


157110


MAP OFFICE COPY

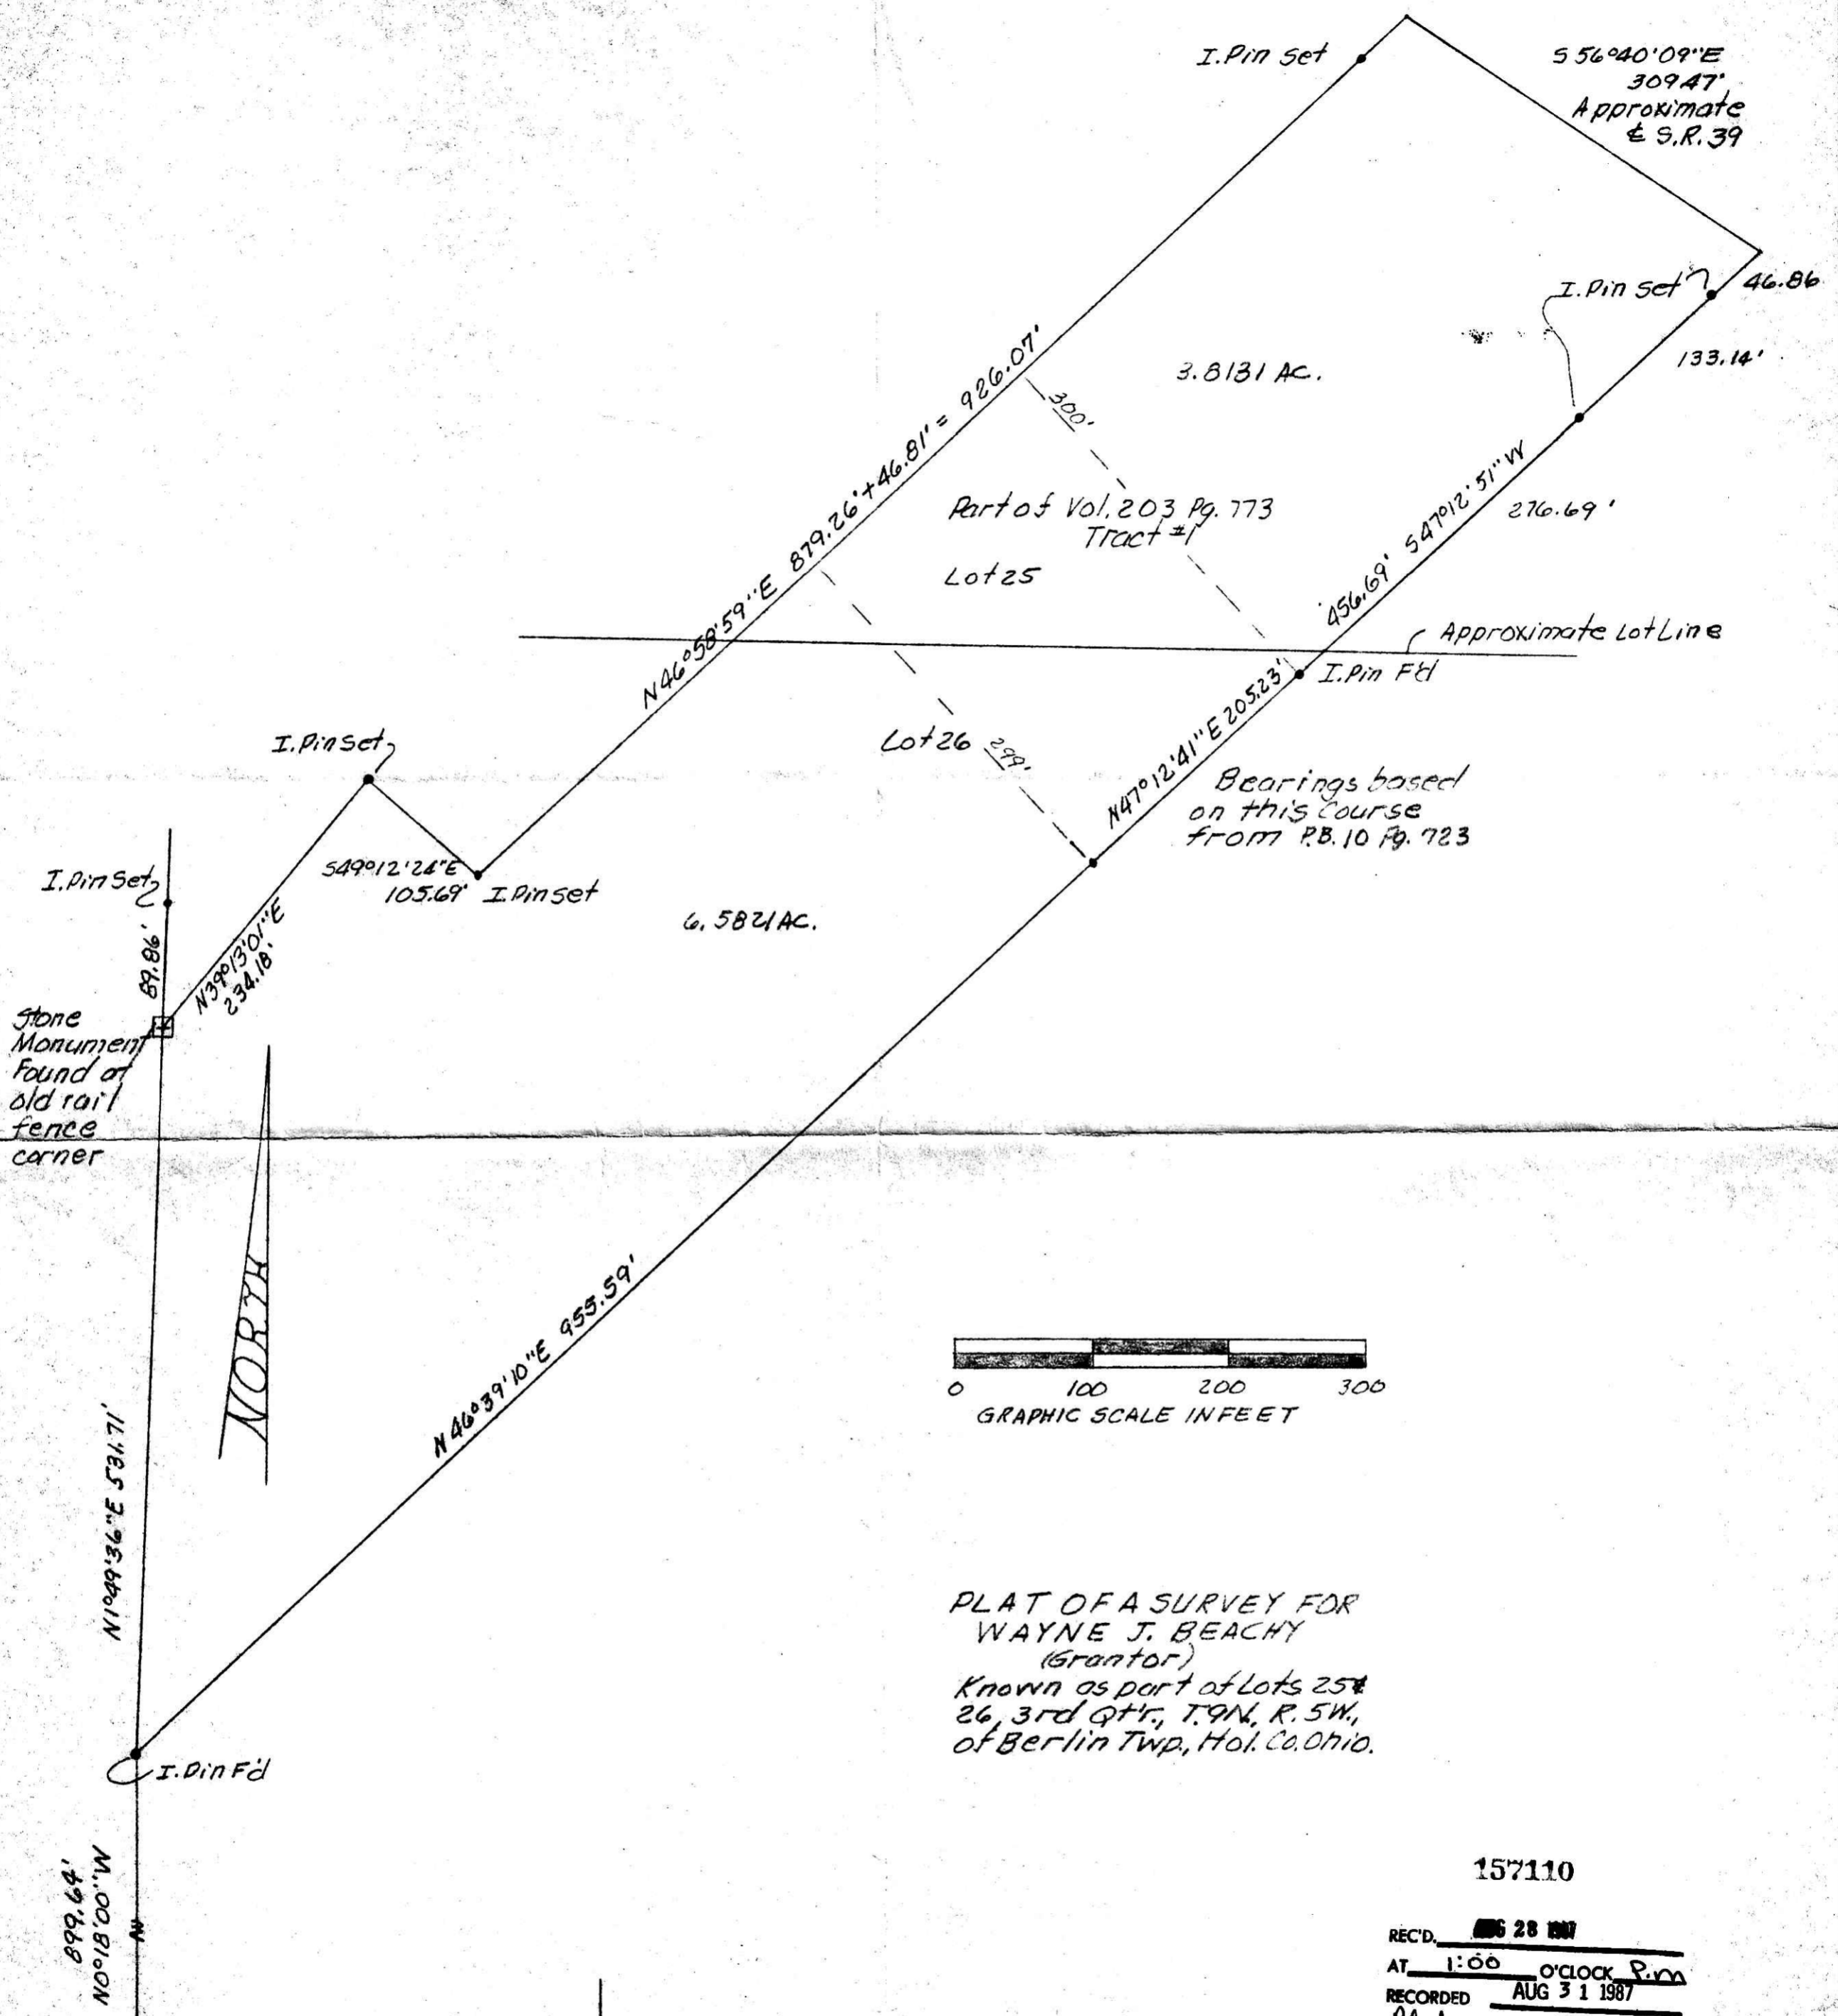

PLAT OF A SURVEY FOR
 WAYNE J. BEACHY
 (Grantor)
 Known as part of Lots 25 &
 26, 3rd Qtr., T. 9N., R. 5W.,
 of Berlin Twp., Hol. Co. Ohio.

157110

REC'D. **28 1987**
 AT 1:00 o'clock P.M.
 RECORDED AUG 31 1987
 Plat VOL 11 PG. 158
 Holmes Co. Ohio Fee: 14.25
 Richard M. Schuler Recorder
 Deed Vol. 236 Page 298

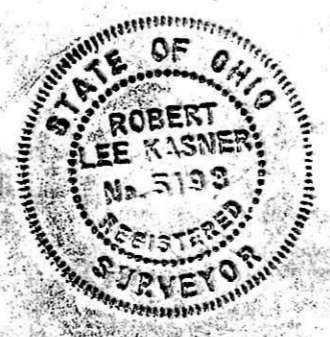

Robert L. Kasner P.S. 5193
 P.E. 28820
 7130187

1600.5' P.B. 5 Pg. 166
 I. Pin Fd Westerly on South
 Line Lot 26 from S.E. corner
 3rd Qtr., T. 9N., R. 5W., of
 Berlin Twp., Hol. Co., Ohio