


160741

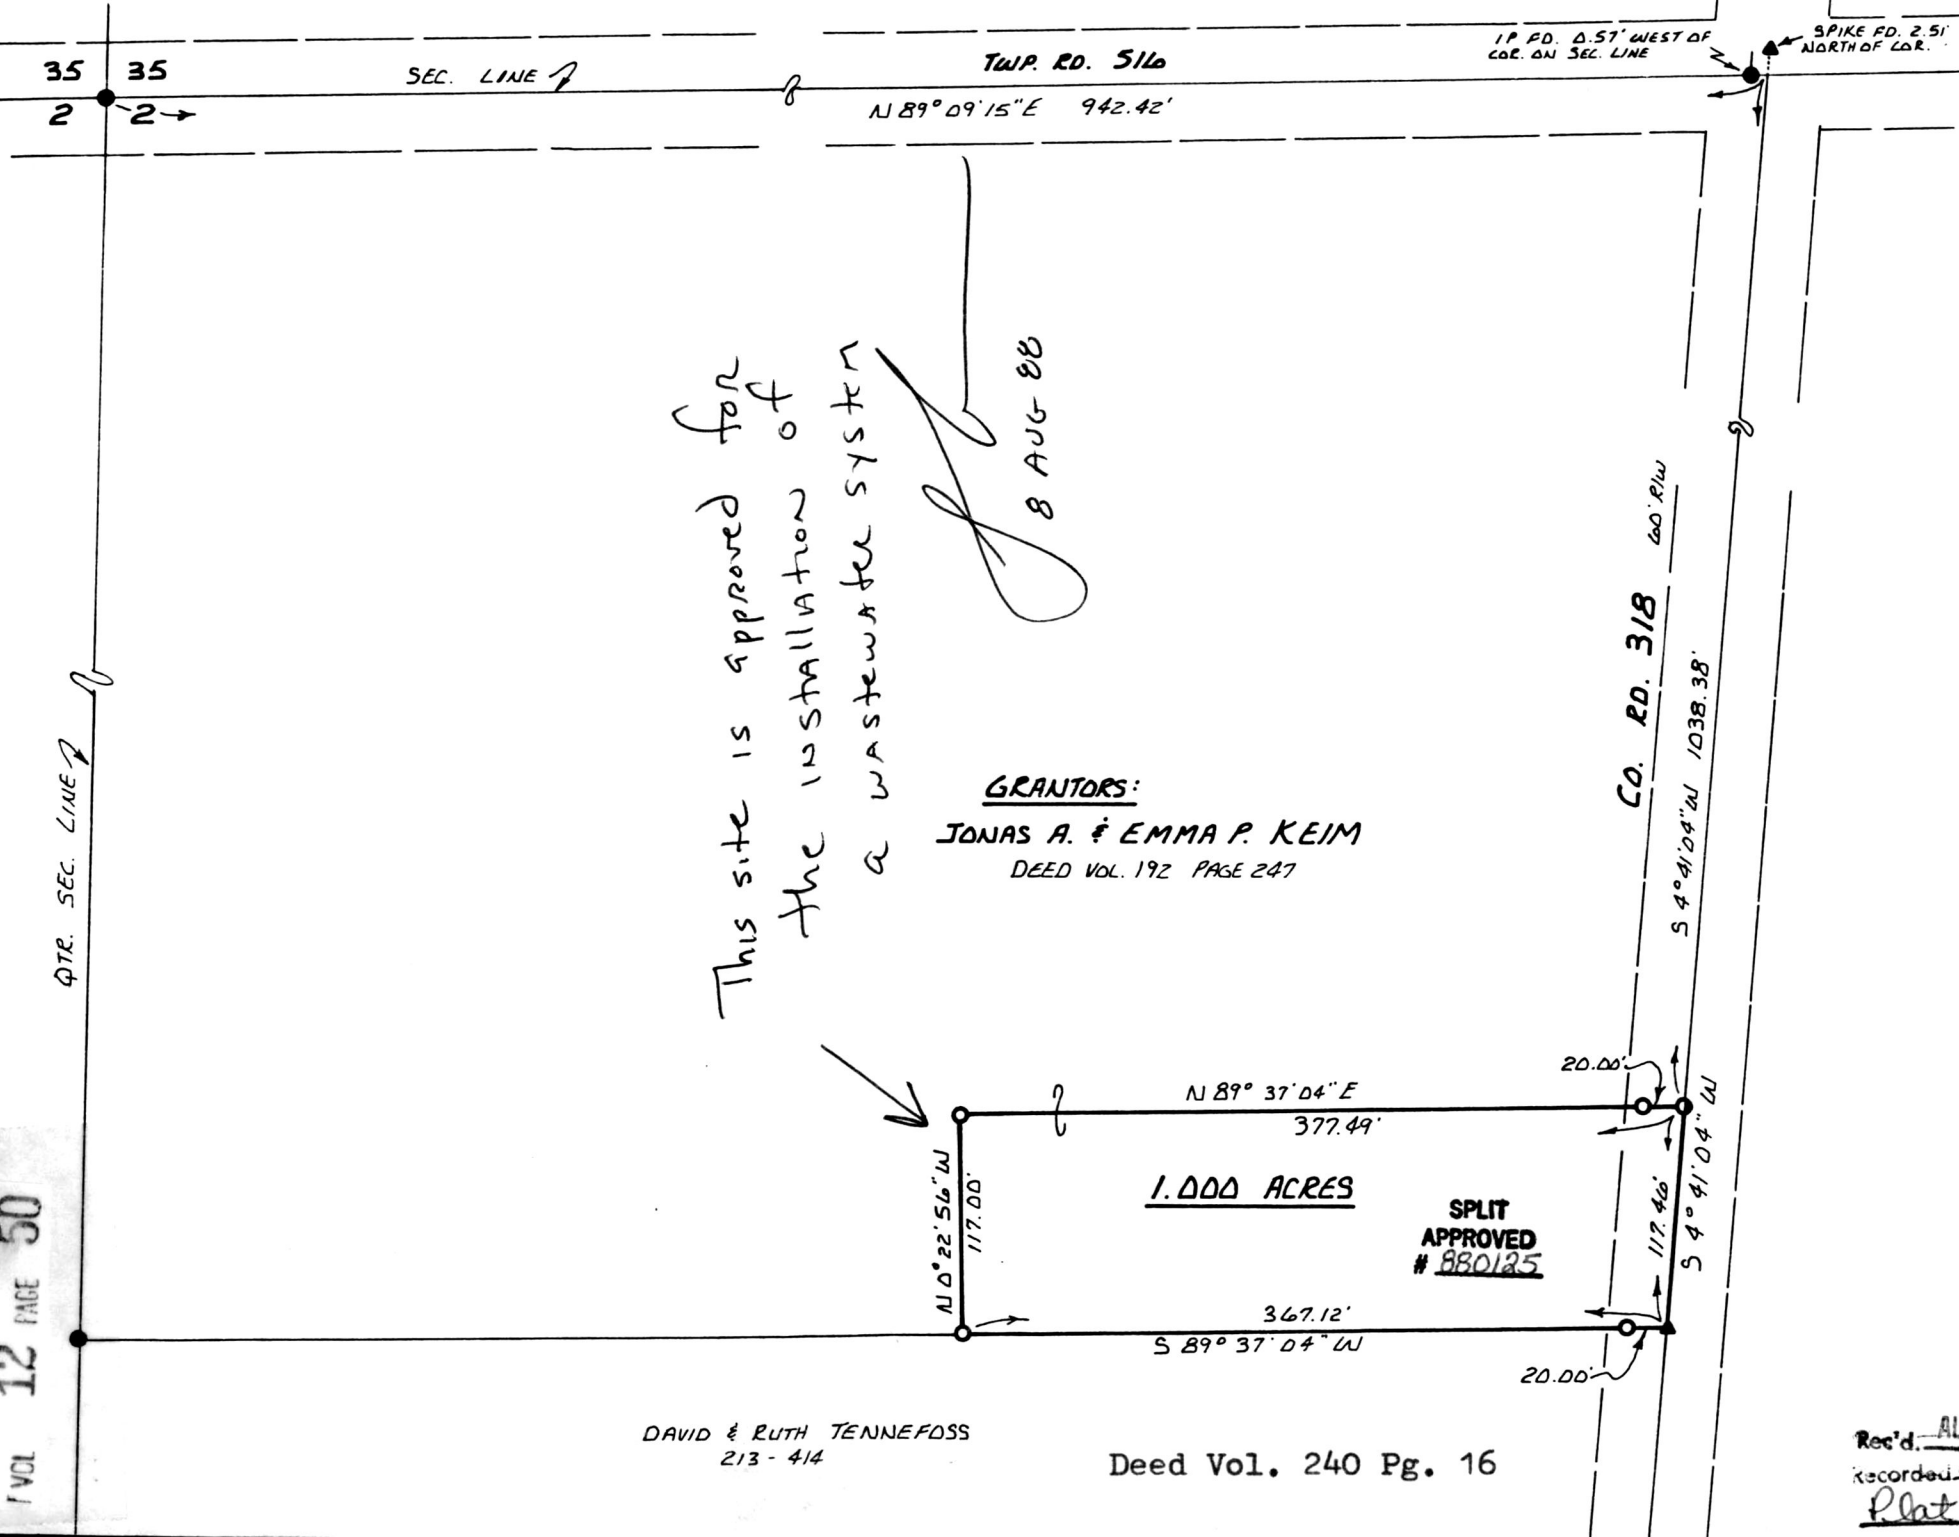


GRANTORS:
 JONAS A. & EMMA P. KEIM
 DEED VOL. 192 PAGE 247

DAVID & RUTH TENNEFOSS
 213 - 414

Deed Vol. 240 Pg. 16

RIPLEY TOWNSHIP
 N.E. QTR. SECTION 2
 T-17 N R-14 W
 HOLMES COUNTY, OHIO

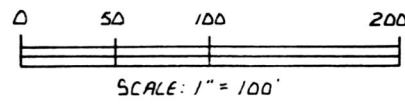

- ▲ R.R. SPIKE FOUND
- IRON PIN FOUND
- 5/8" REBAR SET
- 3/8" REBAR SET WITH I.D. CAP MARKED "BAKER 6938"

REFERENCES:
 PLAT VOL. 10 PAGE 548
 PLAT VOL. 8 PAGE 764
 BEARINGS FROM SAME



I CERTIFY THIS SURVEY TO BE CORRECT TO THE BEST OF MY KNOWLEDGE.

Donald C. Baker
 DONALD C. BAKER P.S. 6938
 4321 TR 252
 GLENMONT, OH.

160741

FEB. 9, 1988

Rec'd. AUG 10 1988 AT 1:32 o'clock pm
 Recorded AUG 11 1988 Holmes Co. Ohio Fee: 5.00
 Plat Vol 12 Pg 50 Recorder Richard Yastin

MAP OFFICE COPY

VOL 12 PAGE 50