


KNOX TOWNSHIP
HOLMES COUNTY, OHIO
NW QTR. SECTION 20, T-17N, R-14W

161525

- Iron Pin Found
- ▲ R.R. Spike Fd.
- Iron Pin Set - 5/8" Rebar With Yellow Cap Marked "LONG-6505"

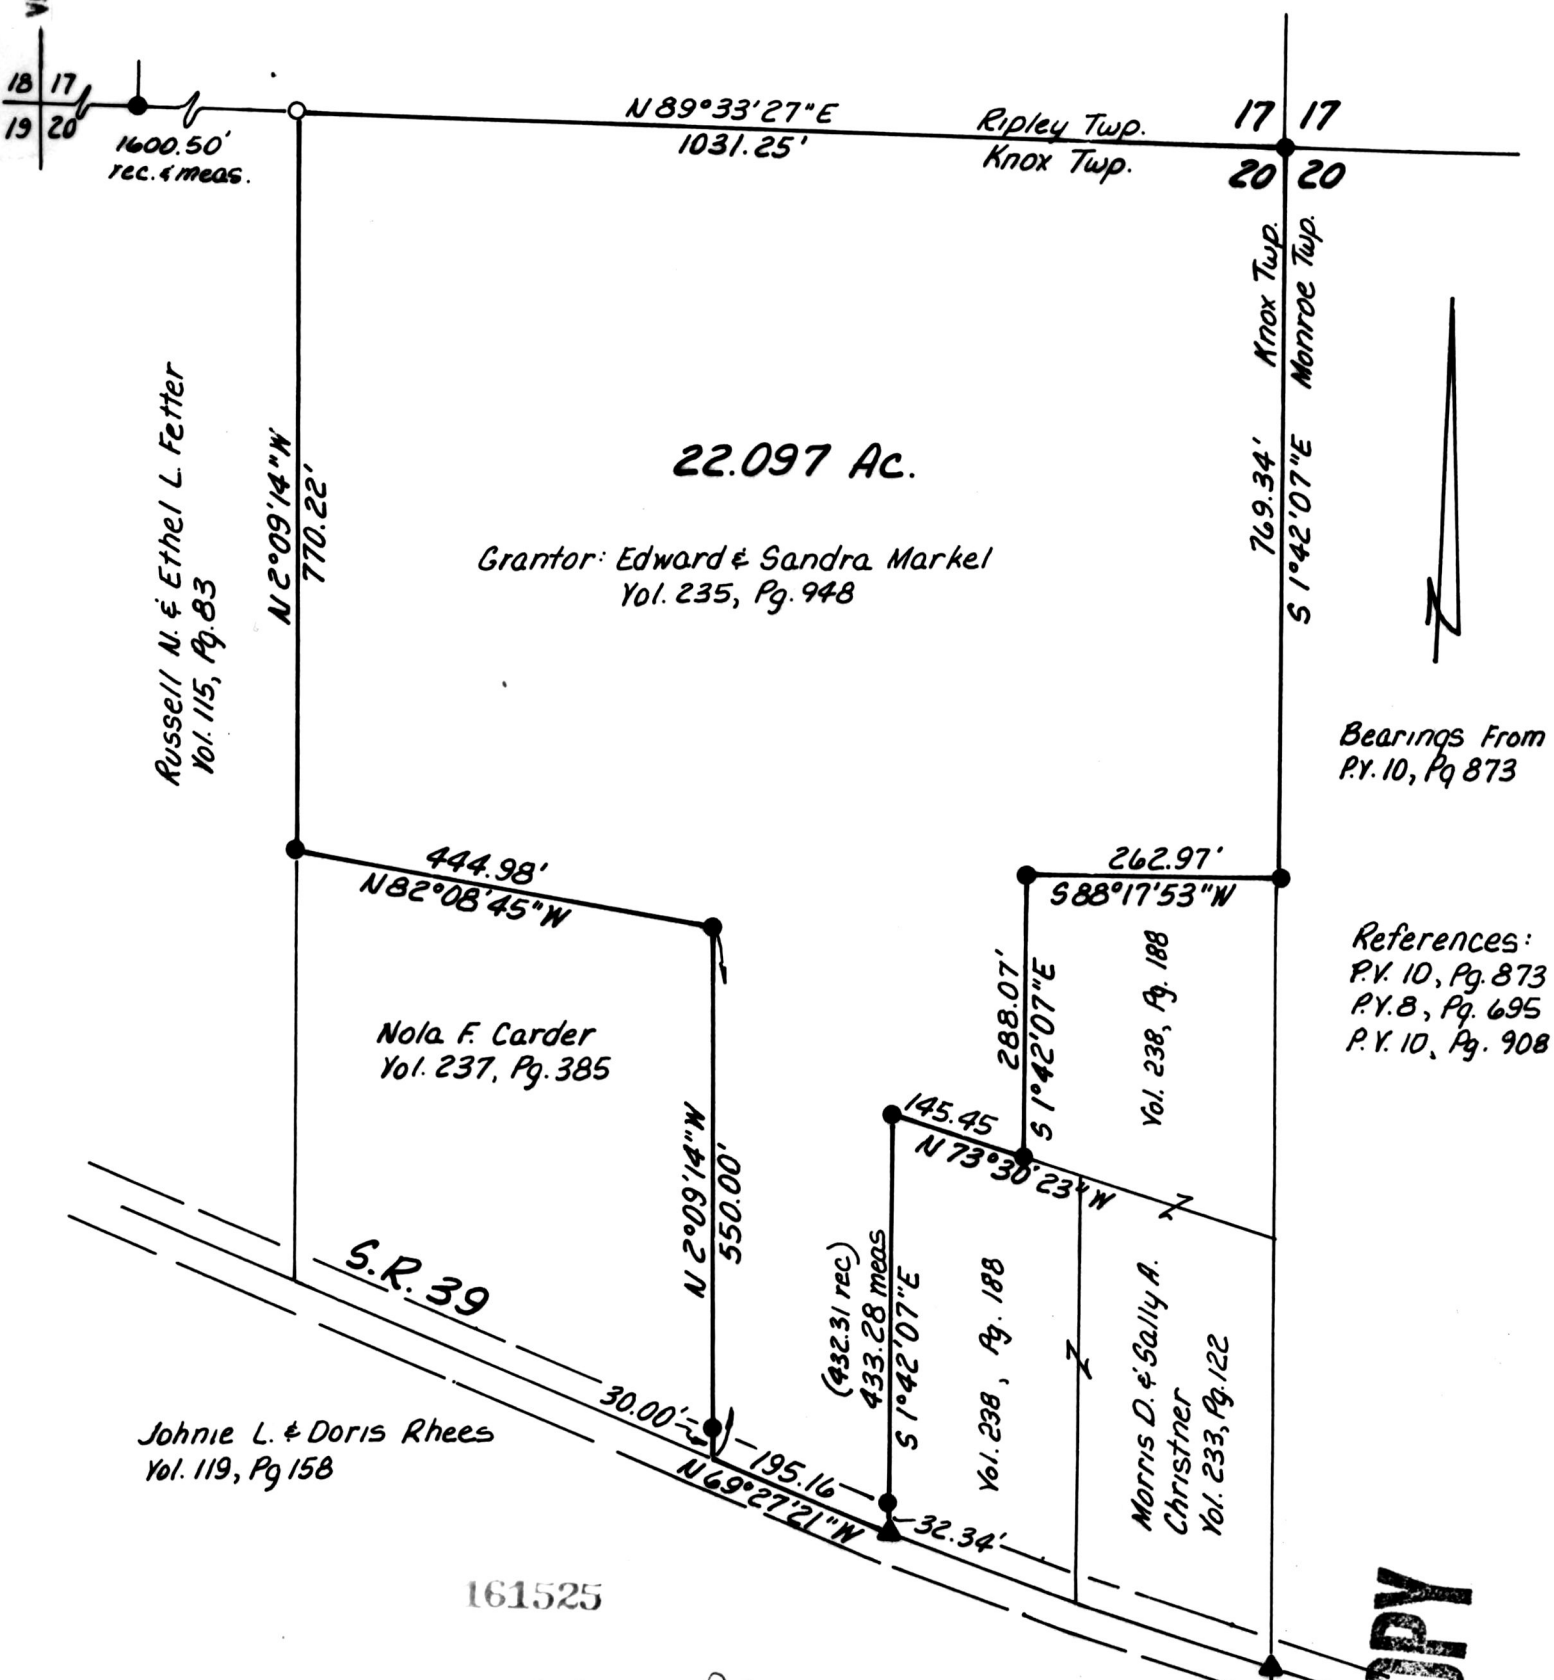

Bearings From
P.Y. 10, Pg 873

References:
P.Y. 10, Pg. 873
P.Y. 8, Pg. 695
P.Y. 10, Pg. 908

161525

Rec'd. OCT 24 1988 AT 12:02 O'CLOCK Pm
 Recorded OCT 25 1988 Holmes Co. Ohio Fee: 5.00
P. Lat Vol. 12 Pg. 90 Recorder Richard Graves

Deed Vol. 240 Page 954

I Certify This Survey To Be Correct
 To The Best Of My Knowledge.
William H. Long Sept. 15, 1988
 William H. Long P.S. 6505
 LONG SURVEYING, INC.
 13301 T.R. 503
 Big Prairie, Ohio 44611



MAP OFFICE COPY