


PAINT TOWNSHIP
4th QTR. T-10N R-5W
LOTS 33 & 34
HOLMES COUNTY, OHIO

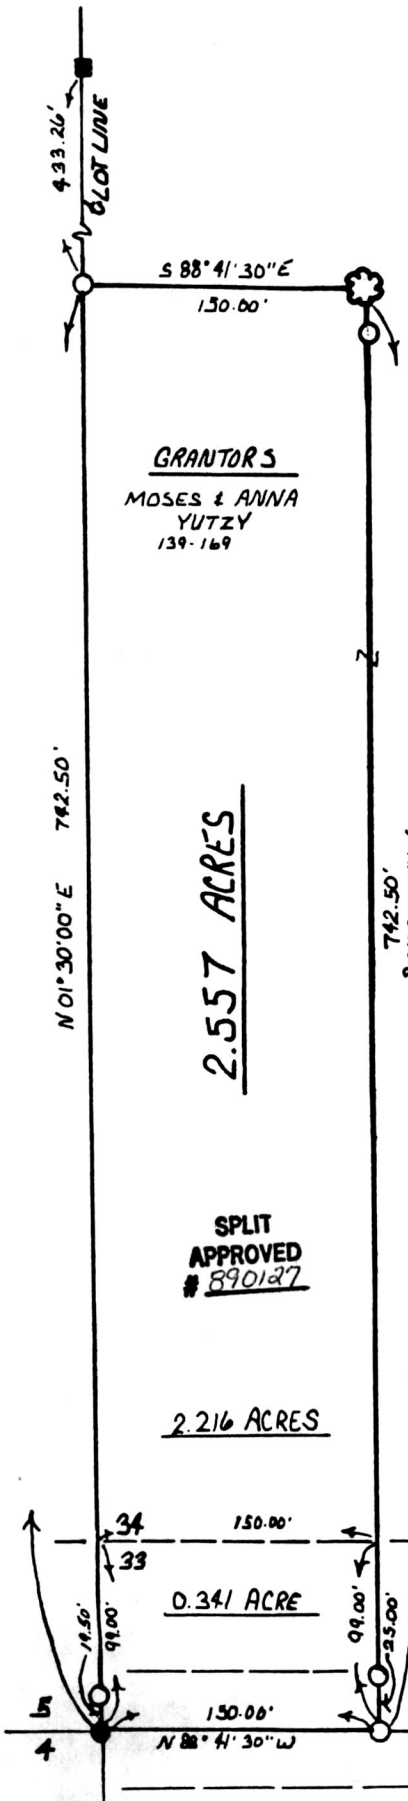

HICKORY TREE
AT CORNER.
SET REBAR
3.00' SOUTH
ON LINE.

GRANTORS
MOSES & ANNA
YUTZY
139-169

2.557 ACRES


SPLIT
APPROVED
890127

2.216 ACRES

0.341 ACRE

This 2.557 Ac. plat is approved
for residential wastewater.

Dennis H. Murray 7/17/89
Sanitarian Date

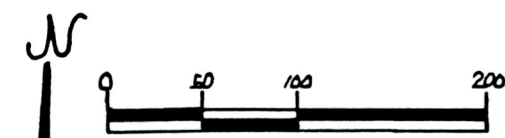

SCALE: 1" = 100'

- STONE FOUND
- IRON PIN FOUND
- 1/2" REBAR WITH I.D. CAP SET
I.D. CAP MARKED "BAKER 6938"

BEARINGS FROM DEED VOL. 139
PAGE 169



I CERTIFY THIS SURVEY TO BE CORRECT
TO THE BEST OF MY KNOWLEDGE.

Donald C. Baker

DONALD C. BAKER P.S. 6938
4321 T.R. 252
GLENMONT, OH.

164636

Deed Vol. 244 Pg. 245

MAY 30, 1989

Rec'd. JUL 27 1989

AT 1:30 O'CLOCK P.M.

Recorded: JUL 28 1989

Holmes Co. Ohio Fees: 5.00

Plat Vol. 12

Pg. 268 Recorder: Richard Heaven

