



MECHANIC TOWNSHIP  
S. E. QTR. SECTION 21  
TWP-8N ; RANGE-6W  
HOLMES COUNTY, OHIO

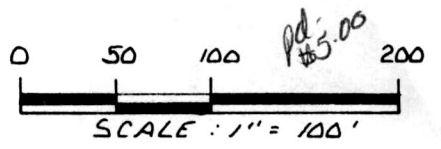

- STONE FOUND
- IRON PIN FOUND
- 5/8" REBAR WITH I.D. CAP SET I.D. CAP MARKED "BAKER 6938"

REFERENCES:

VARIOUS DEEDS AS SHOWN  
BEARINGS FROM PLAT VOL. 6  
PAGE 170

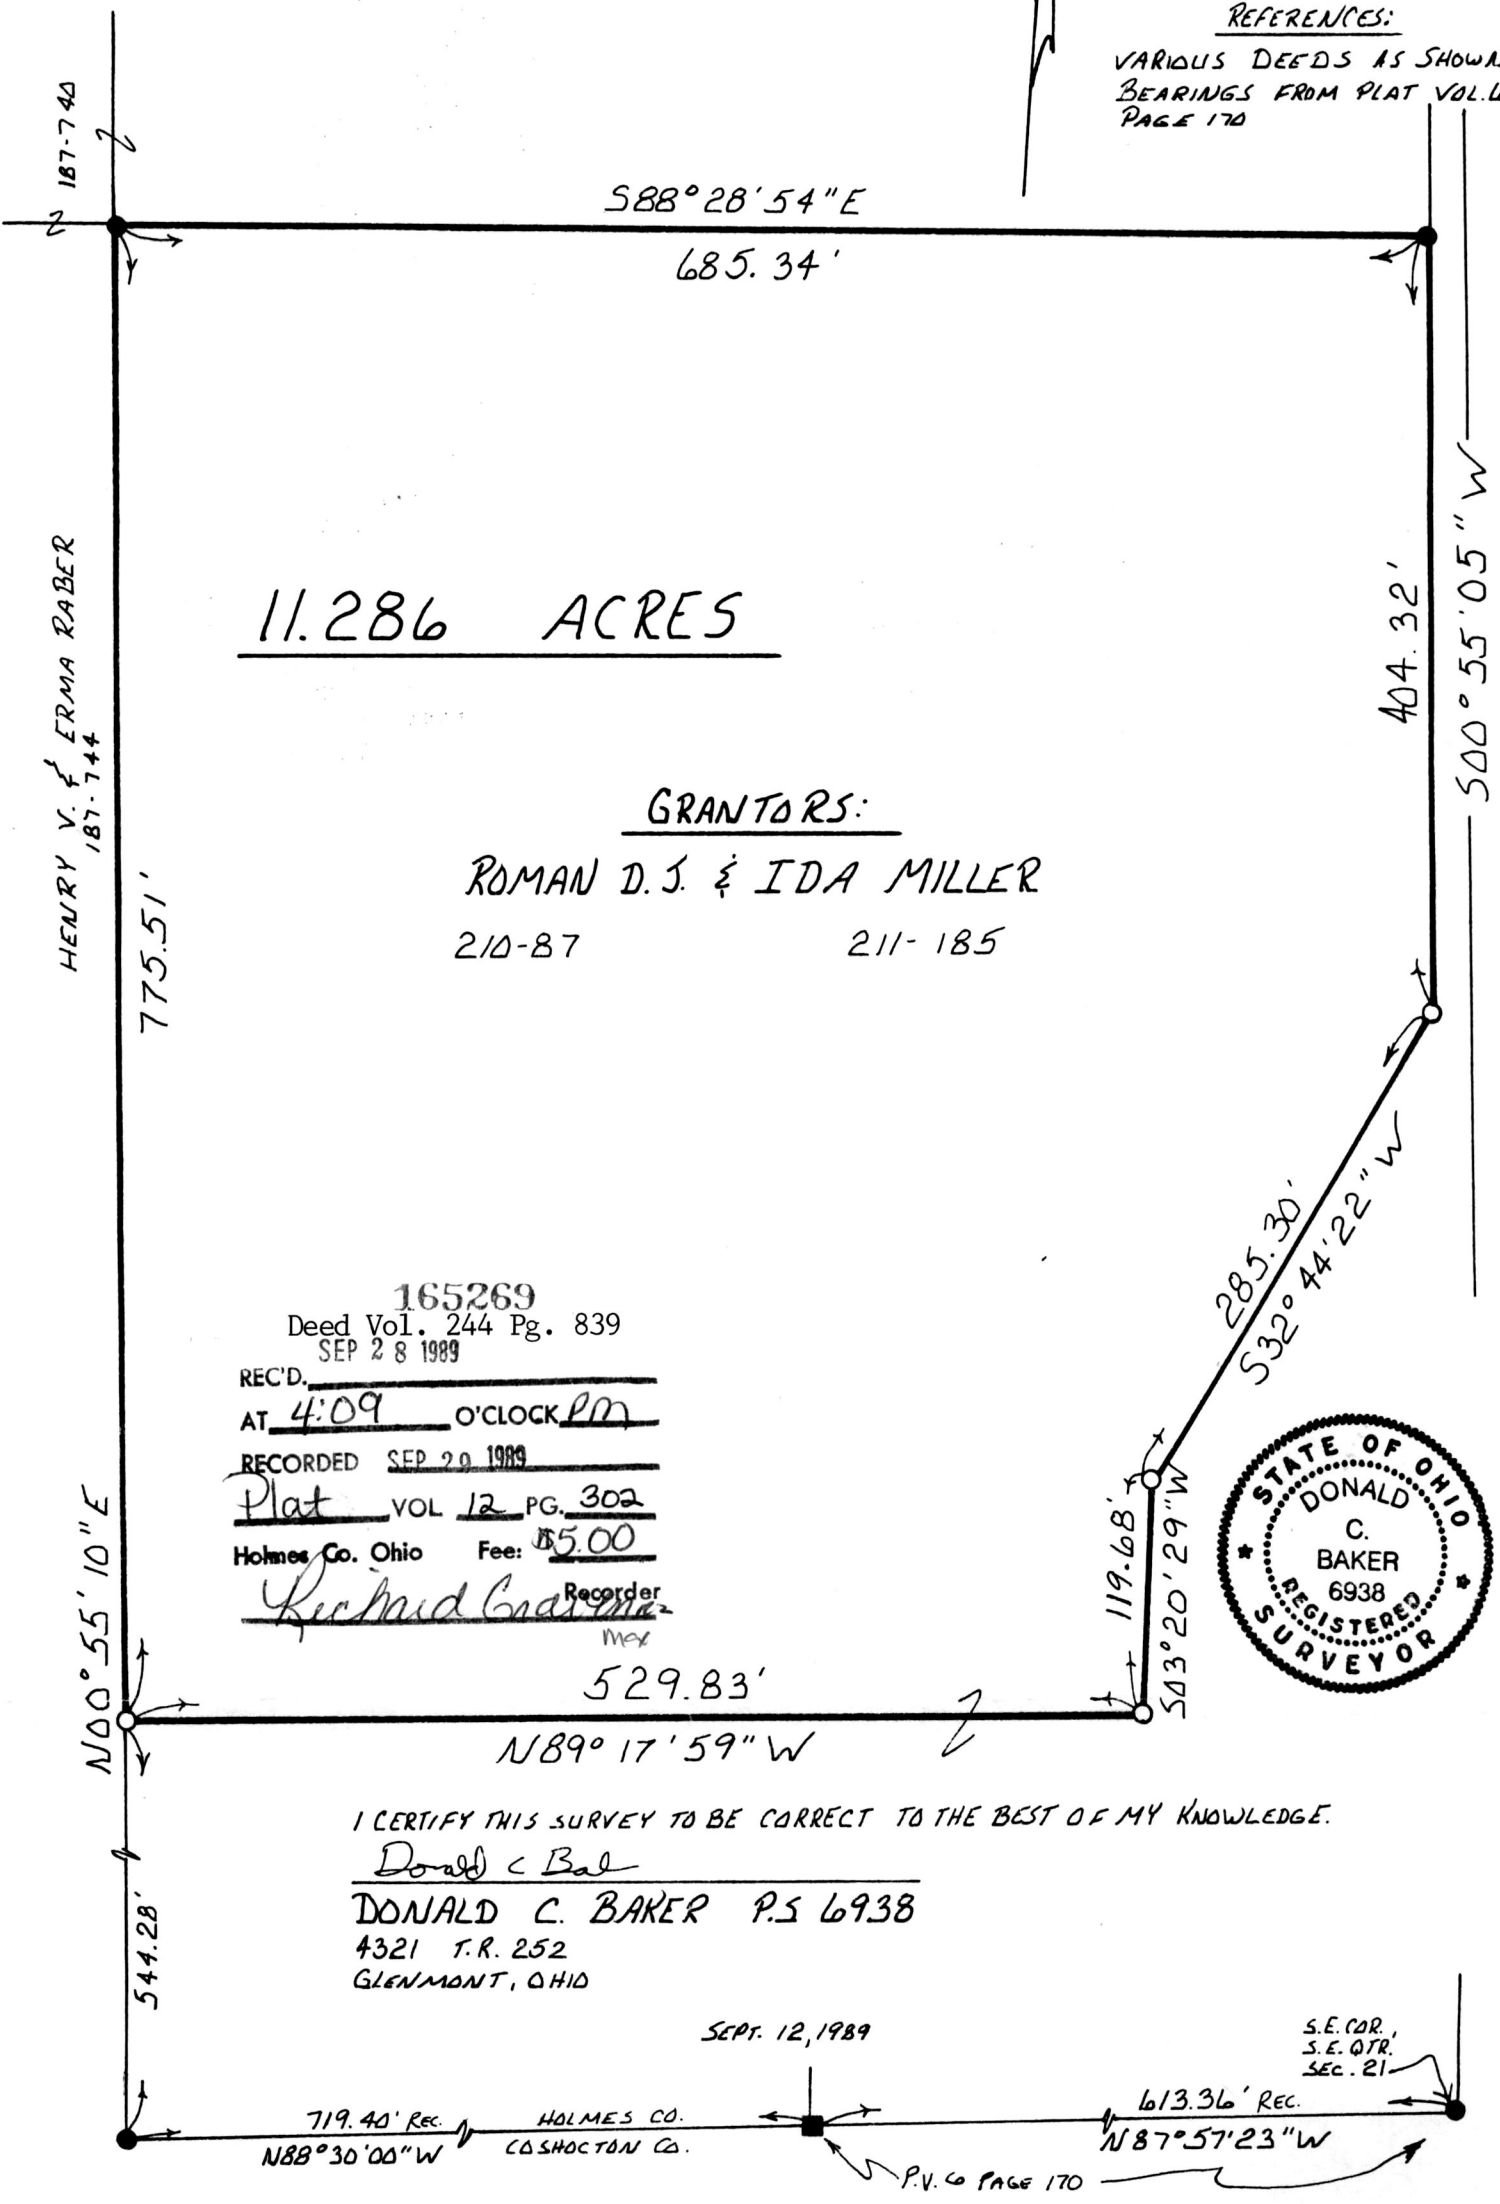

11.286 ACRES

GRANTORS:

ROMAN D. J. & IDA MILLER  
210-87                      211-185

165269  
Deed Vol. 244 Pg. 839  
SEP 28 1989  
REC'D.  
AT 4:09 O'CLOCK PM  
RECORDED SEP 29 1989  
Plat VOL 12 PG. 302  
Holmes Co. Ohio Fee: \$5.00  
Richard G. ... Recorder  
Max



I CERTIFY THIS SURVEY TO BE CORRECT TO THE BEST OF MY KNOWLEDGE.

Donald C. Baker  
DONALD C. BAKER P.S. 6938  
4321 T.R. 252  
GLENMONT, OHIO

SEPT. 12, 1989

S.E. COR.,  
S.E. QTR.,  
SEC. 21