

CLARK TOWNSHIP
S.E. QTR. SECTION 17
T-8N R-4W
HOLMES COUNTY, OHIO



- IRON PIN FOUND
- 5/8" REBAR WITH I.D. CAP SET
I.D. CAP MARKED "BAKER 6938"


BEARINGS FROM PLAT VOL. 11
PAGE 63

SPLIT
APPROVED
890192

(0.181 Ac.)
This plat not approved for any use
that generates wastewater.

Jon M. Group 9/22/89
Sanitarian Date

JONAS A. & ANNA HERSHOEGER

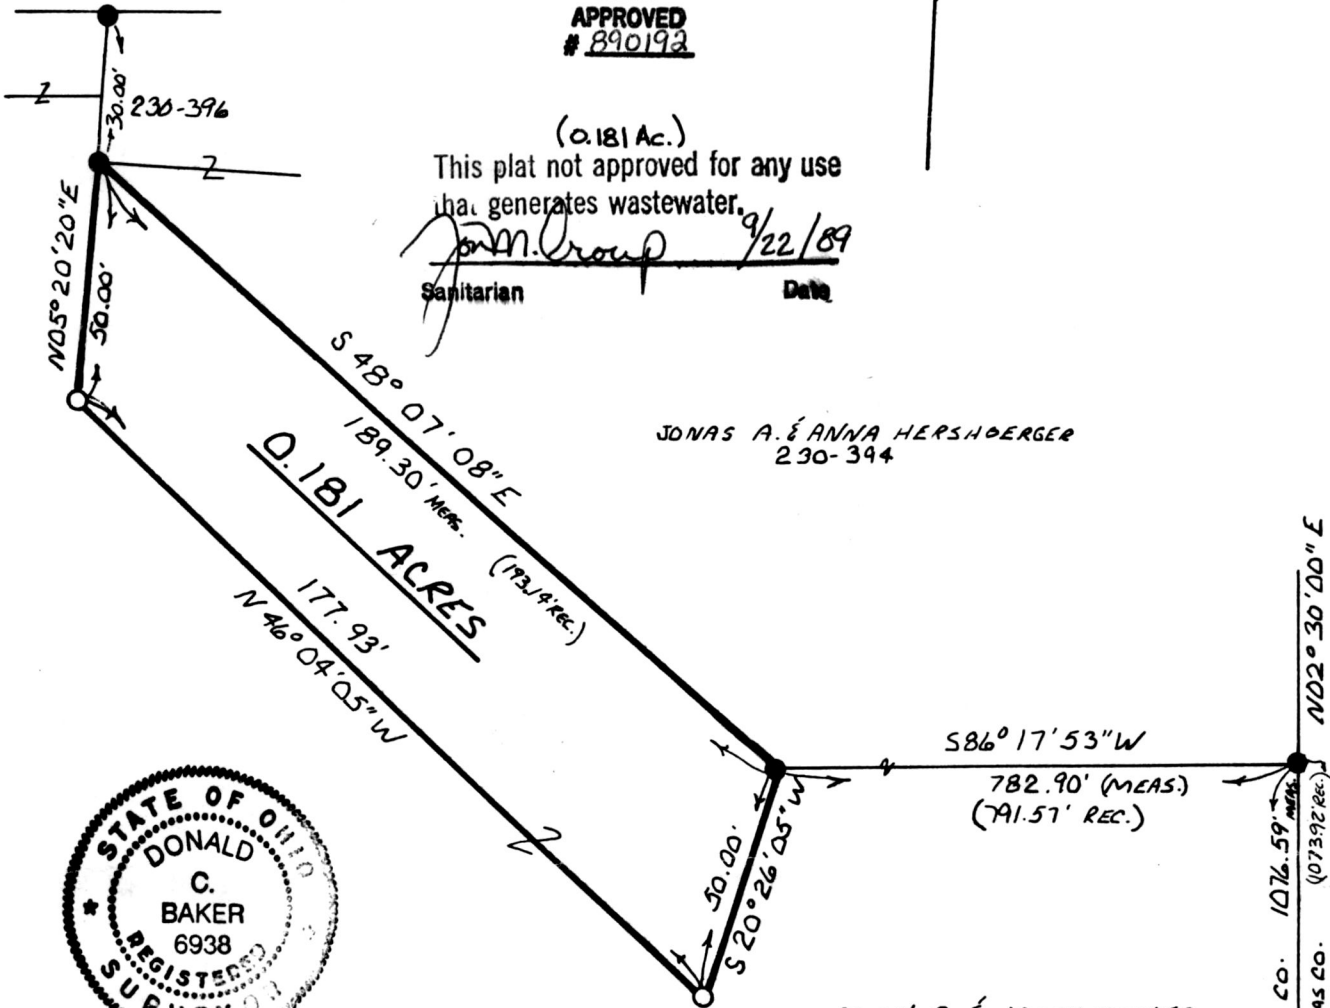

0.181 ACRES
(173.4 REC.)

ANDY A. & MARY TROYER
208-658
227-309

165973

I CERTIFY THIS SURVEY TO BE CORRECT
TO THE BEST OF MY KNOWLEDGE.

Donald C Baker

DONALD C. BAKER P.S. 6938
4321 T.R. 252
GLENMONT, OHIO

Rec'd. NOV 29 1989

Recorded NOV 30 1989

Plat Vol. 12

AT 1:30 O'CLOCK PM

Holmes Co. Ohio Fee: \$ 5.00

Pg. 338 Recorder: *Richard Shallen*

Deed Vol. 245 Page 475

JULY 31, 1989

SECTION LINE 24