

PRAIRIE TOWNSHIP
HOLMES COUNTY, OHIO
NW QTR. SECTION 27, T-14N, R-13W

167359



Pd 500


VOL 12 PAGE 403

- Iron Pin Found
- Iron Pin Set - 5/8" Rebar With Yellow Cap Marked "LONG-6505"

Bearings From
P.Y. 9 Pg 33

References: Plat Vol. 9 Pg 33

5	135
8	301
8	572
10	3

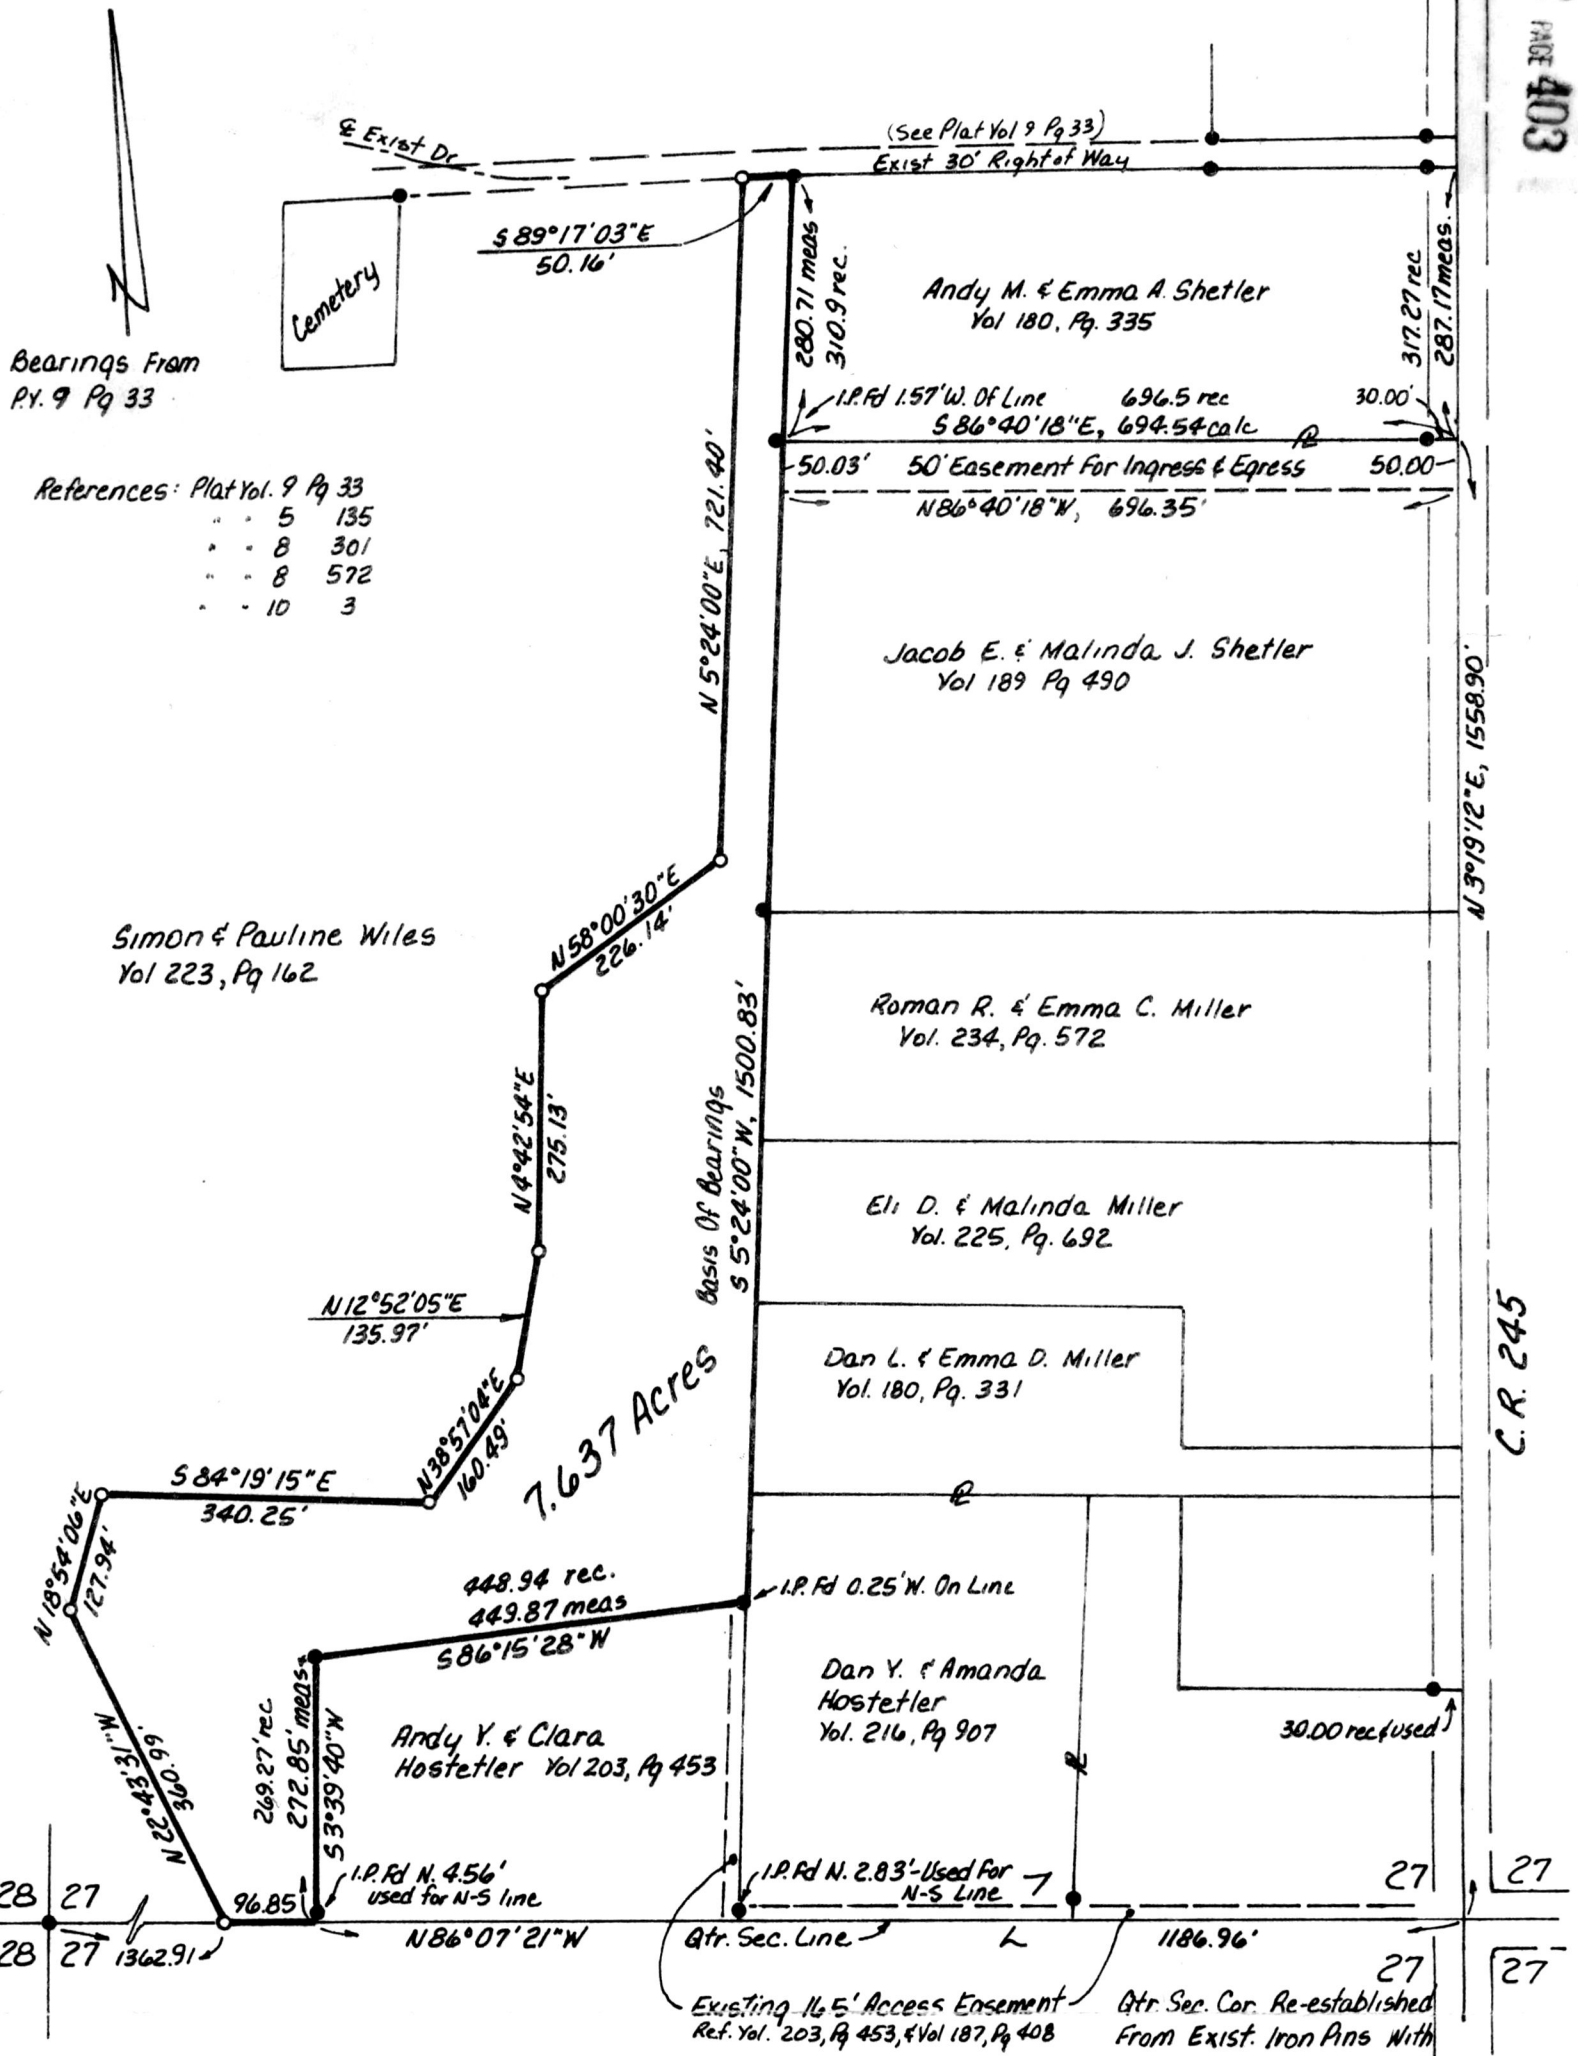

Simon & Pauline Wiles
Vol 223, Pg 162

Andy M. & Emma A. Shetler
Vol 180, Pg. 335

Jacob E. & Malinda J. Shetler
Vol 189 Pg 490

Roman R. & Emma C. Miller
Vol. 234, Pg. 572

Eli D. & Malinda Miller
Vol. 225, Pg. 692

Dan L. & Emma D. Miller
Vol. 180, Pg. 331

Dan Y. & Amanda
Hostetler
Vol. 216, Pg 907

Surveyed for Simon Wiles

I Certify This Survey To Be Correct
To The Best Of My Knowledge
William H. Long Feb. 3, 1989
William H. Long P.S. 6505
LONG SURVEYING, INC.
13301 T.R. 503
Big Prairie, Ohio 44611



Deed Vol. 246 Pg. 789

Rec'd. APR 12 1990
Recorded APR 13 1990
Plat Vol. 12

AT 3:46 o'clock P.M.
Holmes Co. Ohio Fees 5.00
Pg. 403 Recorder Richard
Stranen

PLAT APPROVED
4/10/90 B