



VOL 12 PAGE 412

167599

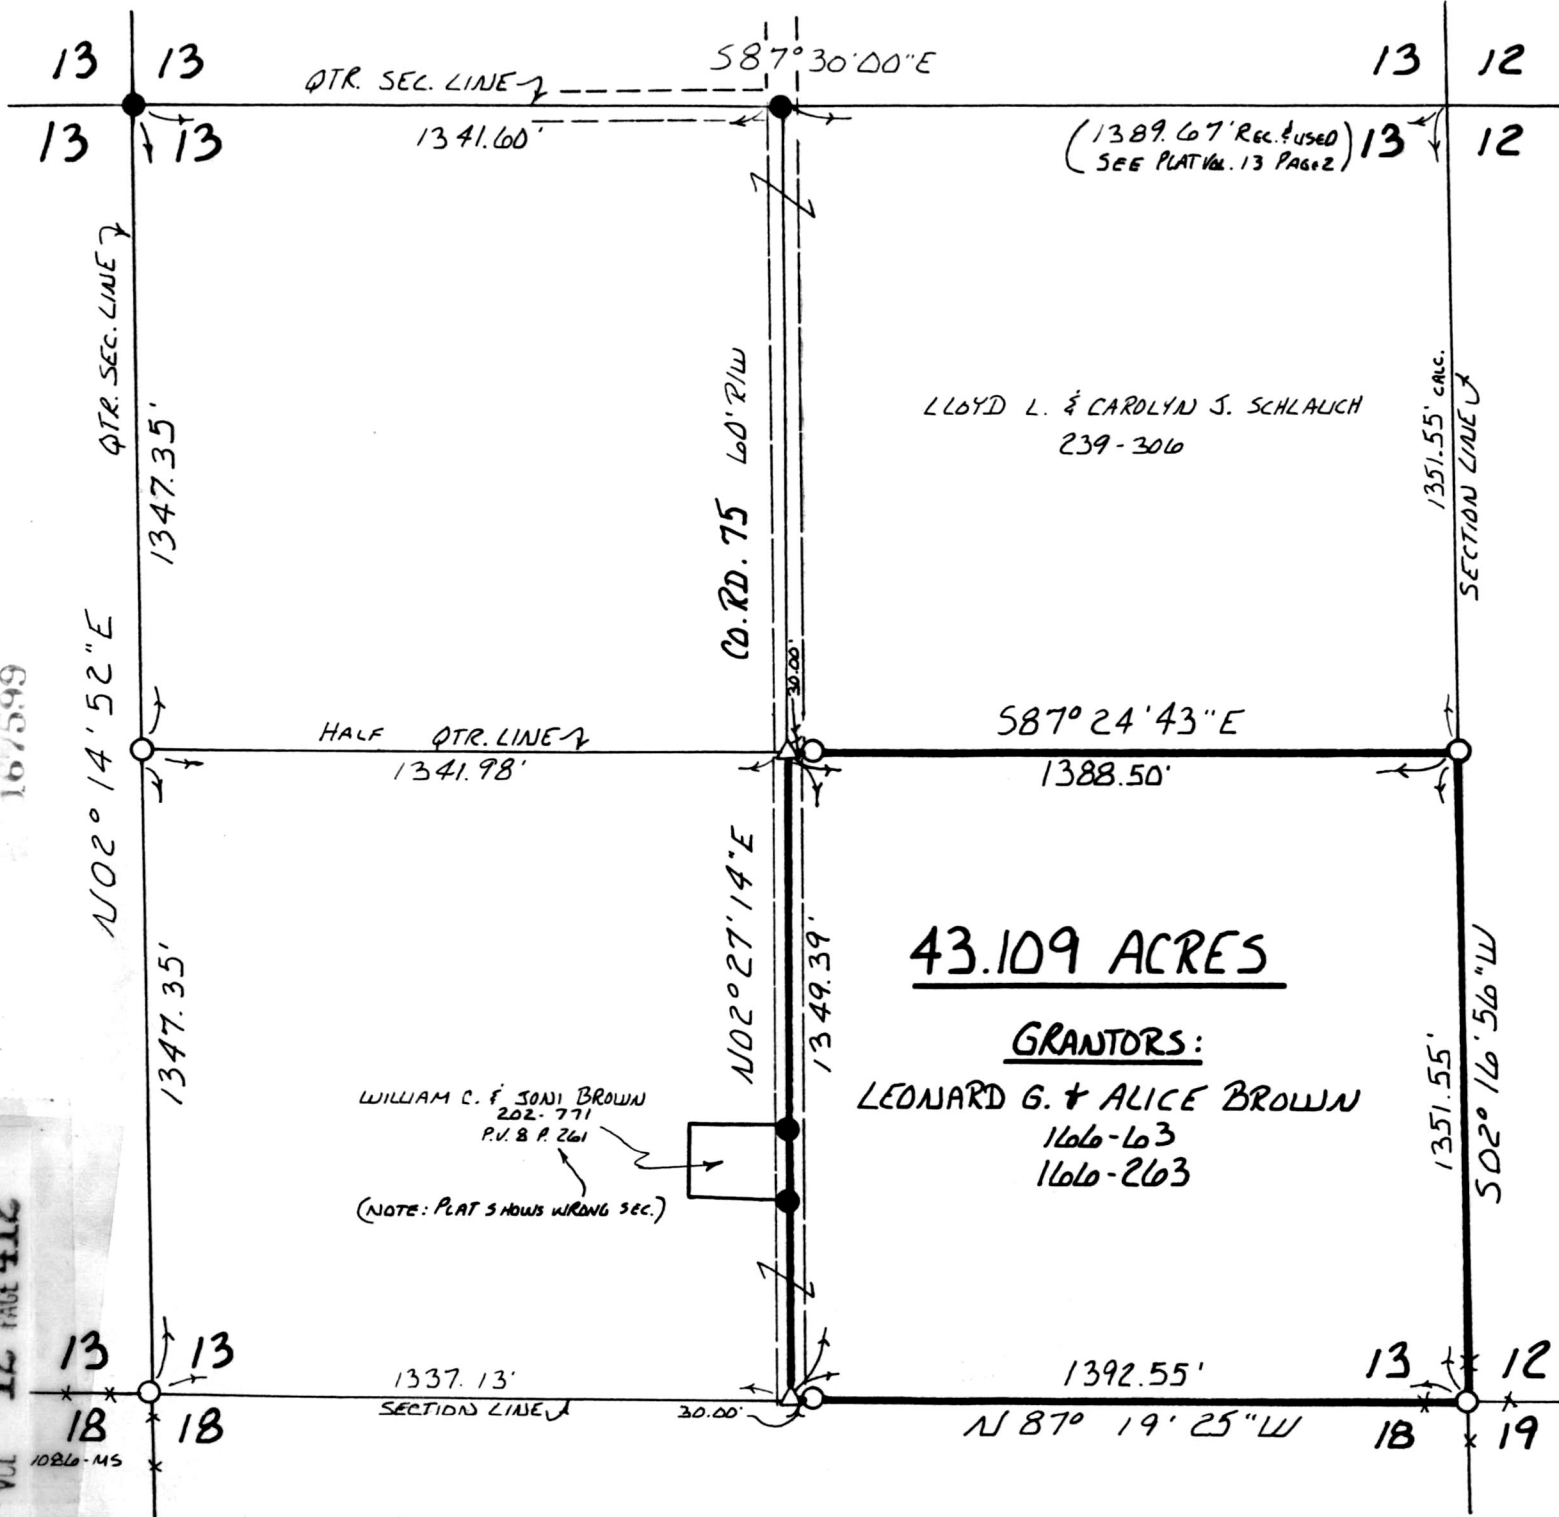

RICHLAND TOWNSHIP  
S.E. QTR. SECTION 13  
T-8N R-9W  
HOLMES COUNTY, OHIO

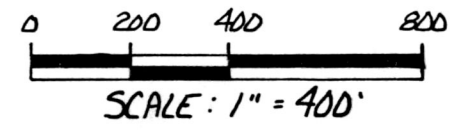

- IRON PIN FOUND
- △ R.R. SPIKE SET
- 5/8" RE BAR WITH I.D. CAP SET  
I.D. CAP MARKED "BAKER 6938"

REFERENCES:  
PLAT VOL. 8 PAGE 261  
VARIOUS DEEDS AS SHOWN  
BEARINGS FROM PLAT VOL. 13  
PAGE 2



I CERTIFY THIS SURVEY TO BE CORRECT  
TO THE BEST OF MY KNOWLEDGE.

Donald C. Baker  
DONALD C. BAKER P.S. 6938  
4321 T.R. 252  
GLENMONT, OHIO

APRIL 3, 1990

PLAT APPROVED  
4/27/90

Deed Vol. 1247 Pg. 50  
AT 8:15 O'CLOCK P.M.  
APR 30 1990  
Recorded MAY 1 1990  
Holmes Co. Ohio Fees 5.00  
Plat Vol. 12 Pg. 412 Recorder Richard Shanon