

MONROE TOWNSHIP  
2ND QTR. LOTS 7 & 8  
TWP. 9N RANGE 8W  
HOLMES COUNTY, OHIO




SCALE: 1" = 200'

- △ R.R. SPIKE FD
- 5/8" REBAR WITH I.D. CAP SET
- I.D. CAP MARKED "BAKER 6938"
- IRON PIN FOUND

REFERENCES:

- PLAT VOL. 7 PAGE 504
- PLAT VOL. 9 PAGE 115
- PLAT VOL. 2 PAGE 210

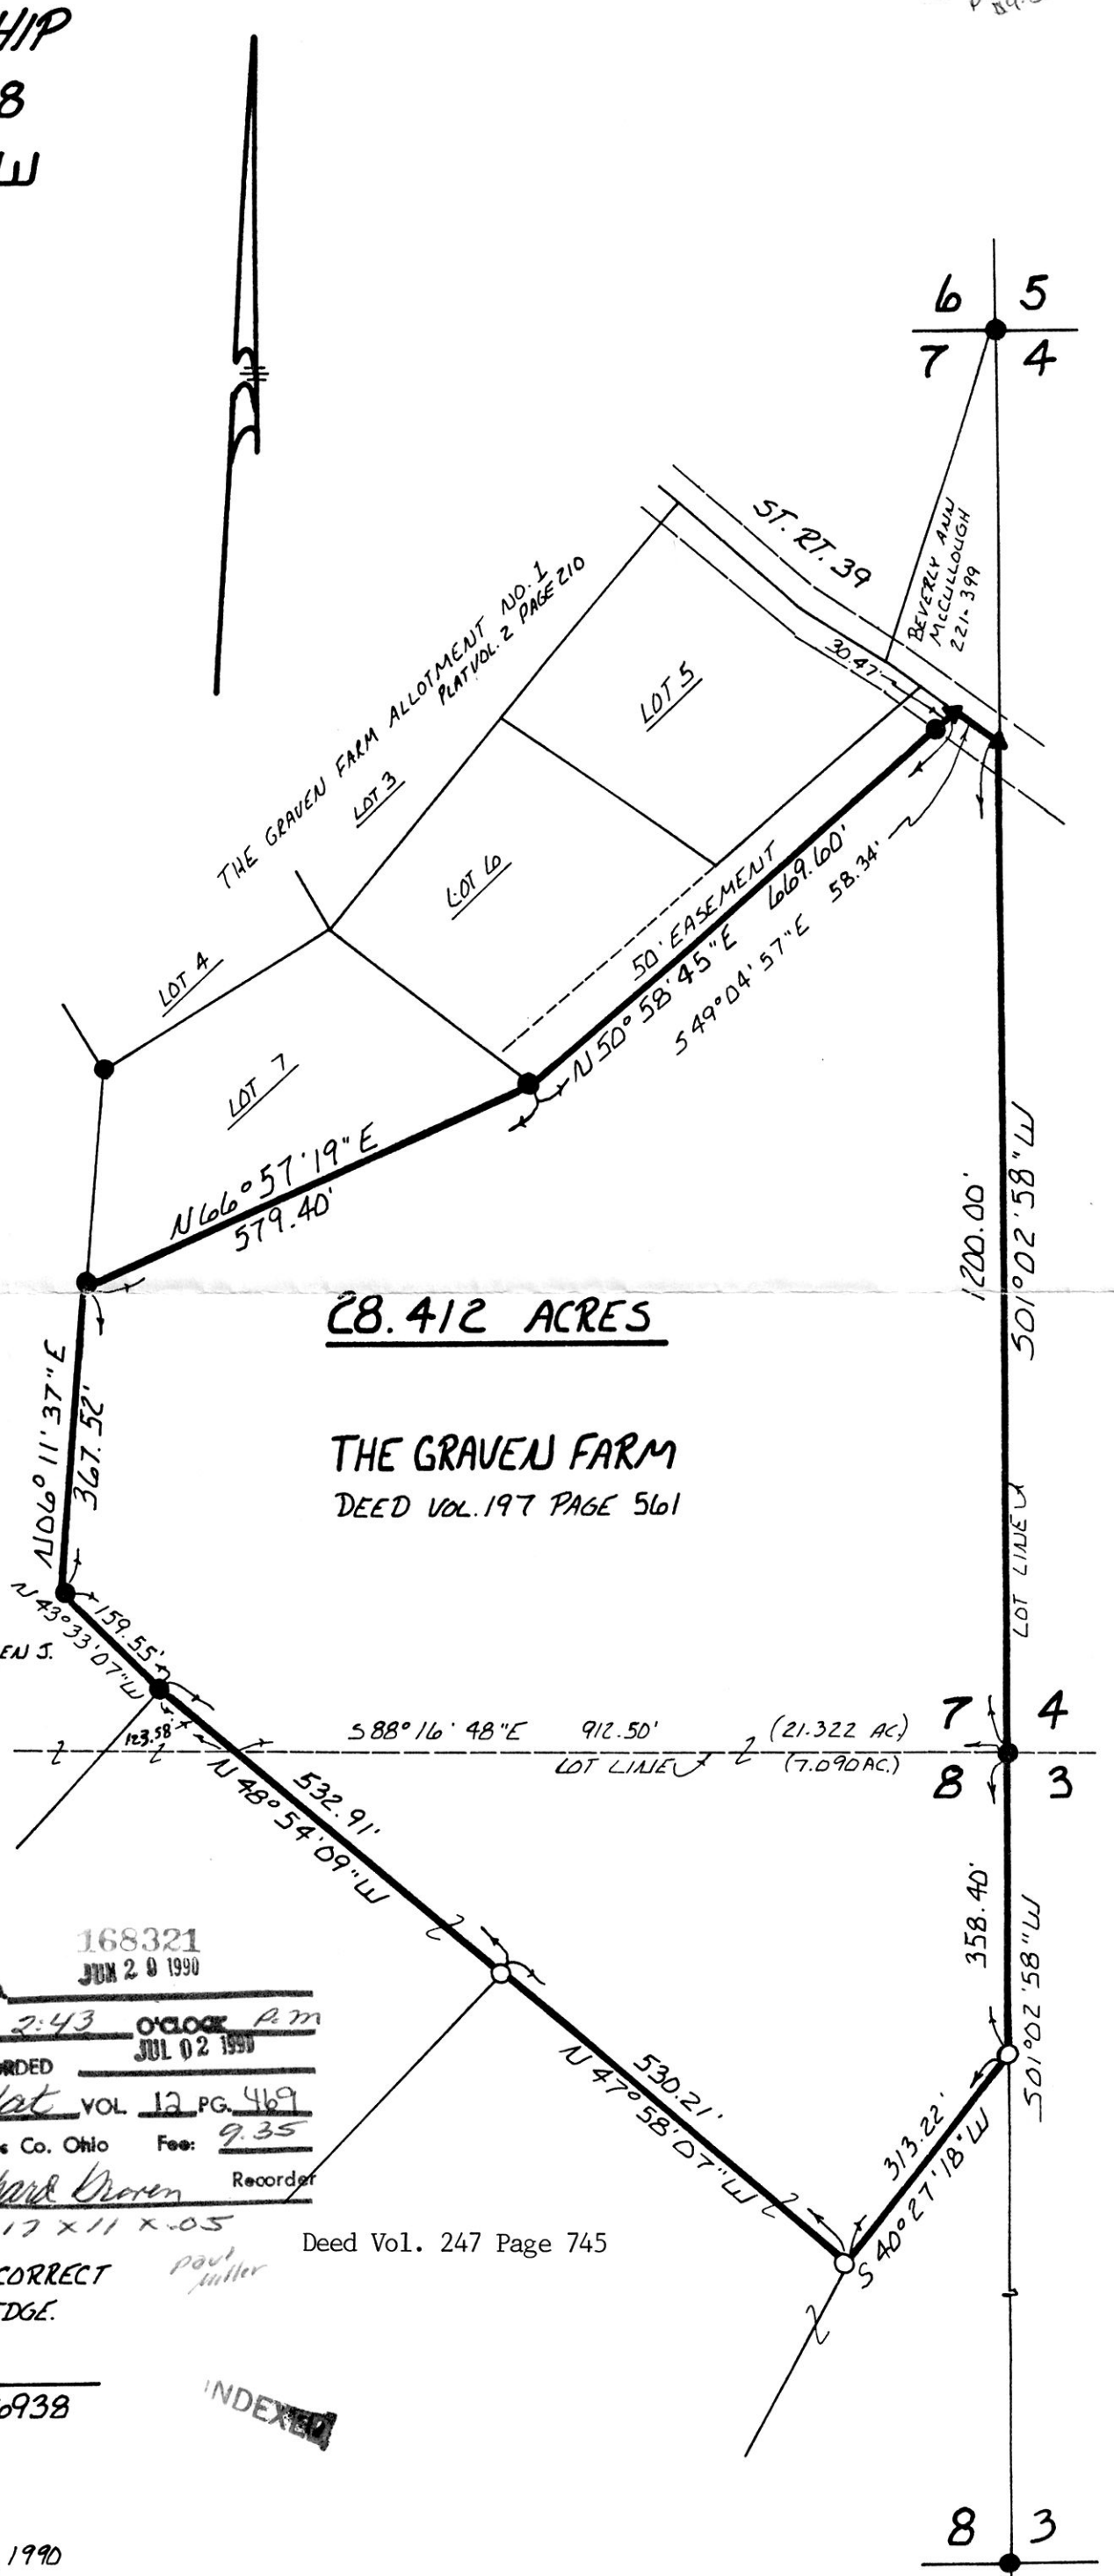

28.412 ACRES

THE GRAVEN FARM  
DEED VOL. 197 PAGE 561

DAVID W. & HELEN S.  
SCHLABACH  
215-985  
223-219



168321  
JUN 29 1990  
REG'D.  
AT 2:43 O'CLOCK P.M.  
RECORDED  
JUL 02 1990  
Plat VOL 12 PG. 469  
Holmes Co. Ohio Fee: 9.35  
Richard Brown Recorder

Deed Vol. 247 Page 745

I CERTIFY THIS SURVEY TO BE CORRECT  
TO THE BEST OF MY KNOWLEDGE.

Donald C. Baker  
DONALD C. BAKER P.S. 6938  
4321 T.R. 252  
GLENMONT, OHIO

MARCH 14, 1990

INDEXED