



WALNUT CREEK TOWNSHIP
N.E. QTR. SECTION 24
TWP. 9N RANGE 4W
HOLMES COUNTY, OHIO

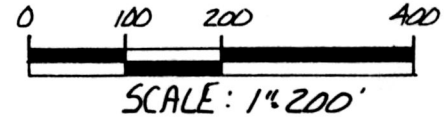

● IRON PIN FOUND

BEARINGS FROM DEED VOL. 244
PAGE 114.

166682

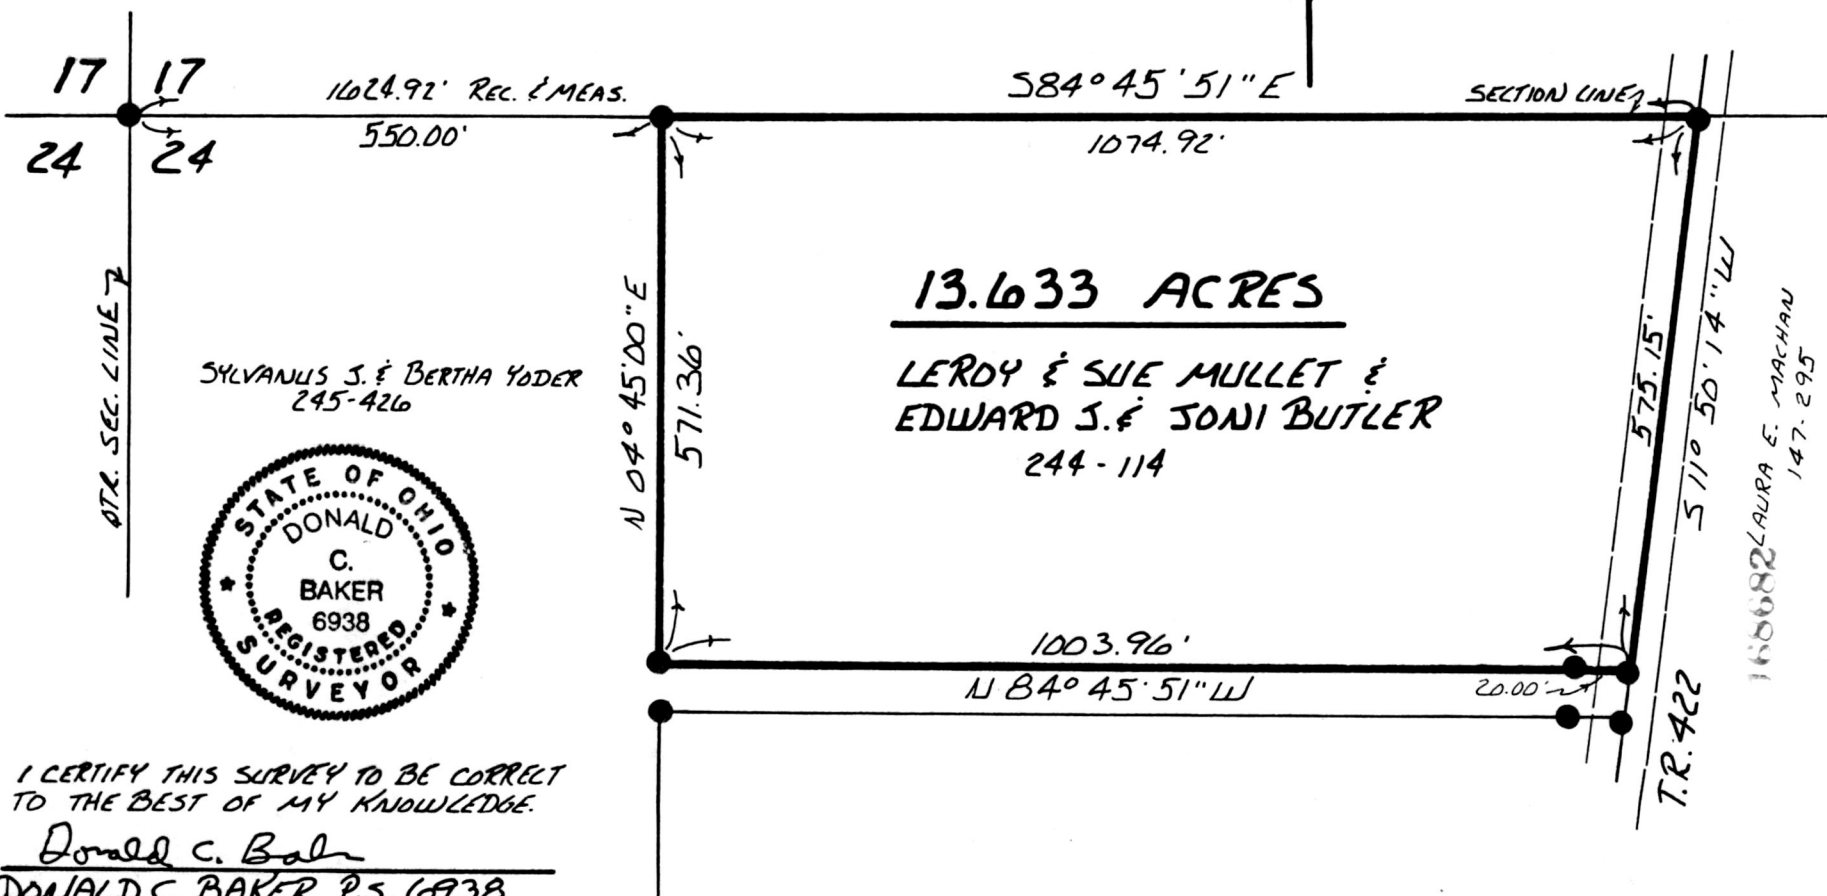

13.633 ACRES
LERDY & SUE MULLET &
EDWARD J. & SONI BUTLER
244 - 114

SYLVANUS J. & BERTHA YODER
245-426



I CERTIFY THIS SURVEY TO BE CORRECT
TO THE BEST OF MY KNOWLEDGE.

Donald C. Baker
DONALD C. BAKER P.S. 6938
4321 T.R. 252
GLENMONT, OHIO

APRIL 17, 1990

REC'D. JUL 31 1990
recorded AUG 01 1990
Plot Vol. 12
11:12:00 CLOCK P.M.
Holmes Co. Ohio Fees 5.00
Pg. Recorder Richard Starn
Deed Vol. 248 Page 98

PLAT APPROVED
7/30/90 B

1115-M5