

Pd. \$5.00


170937

PAINT TOWNSHIP
N.W. QTR. SECTION 33
T-15N ; R-11W
HOLMES COUNTY, OHIO



- ▲ R.R. SPIKE FOUND
- IRON PIN FOUND
- 5/8" REBAR WITH I.D. CAPSET
I.D. CAP MARKED "BAKER6938"

REFERENCES:
DEED VOL. 245 PAGE 6006
PLAT VOL. 12 PAGE 347
BEARINGS FROM DEED VOL. 149 PAGE 147

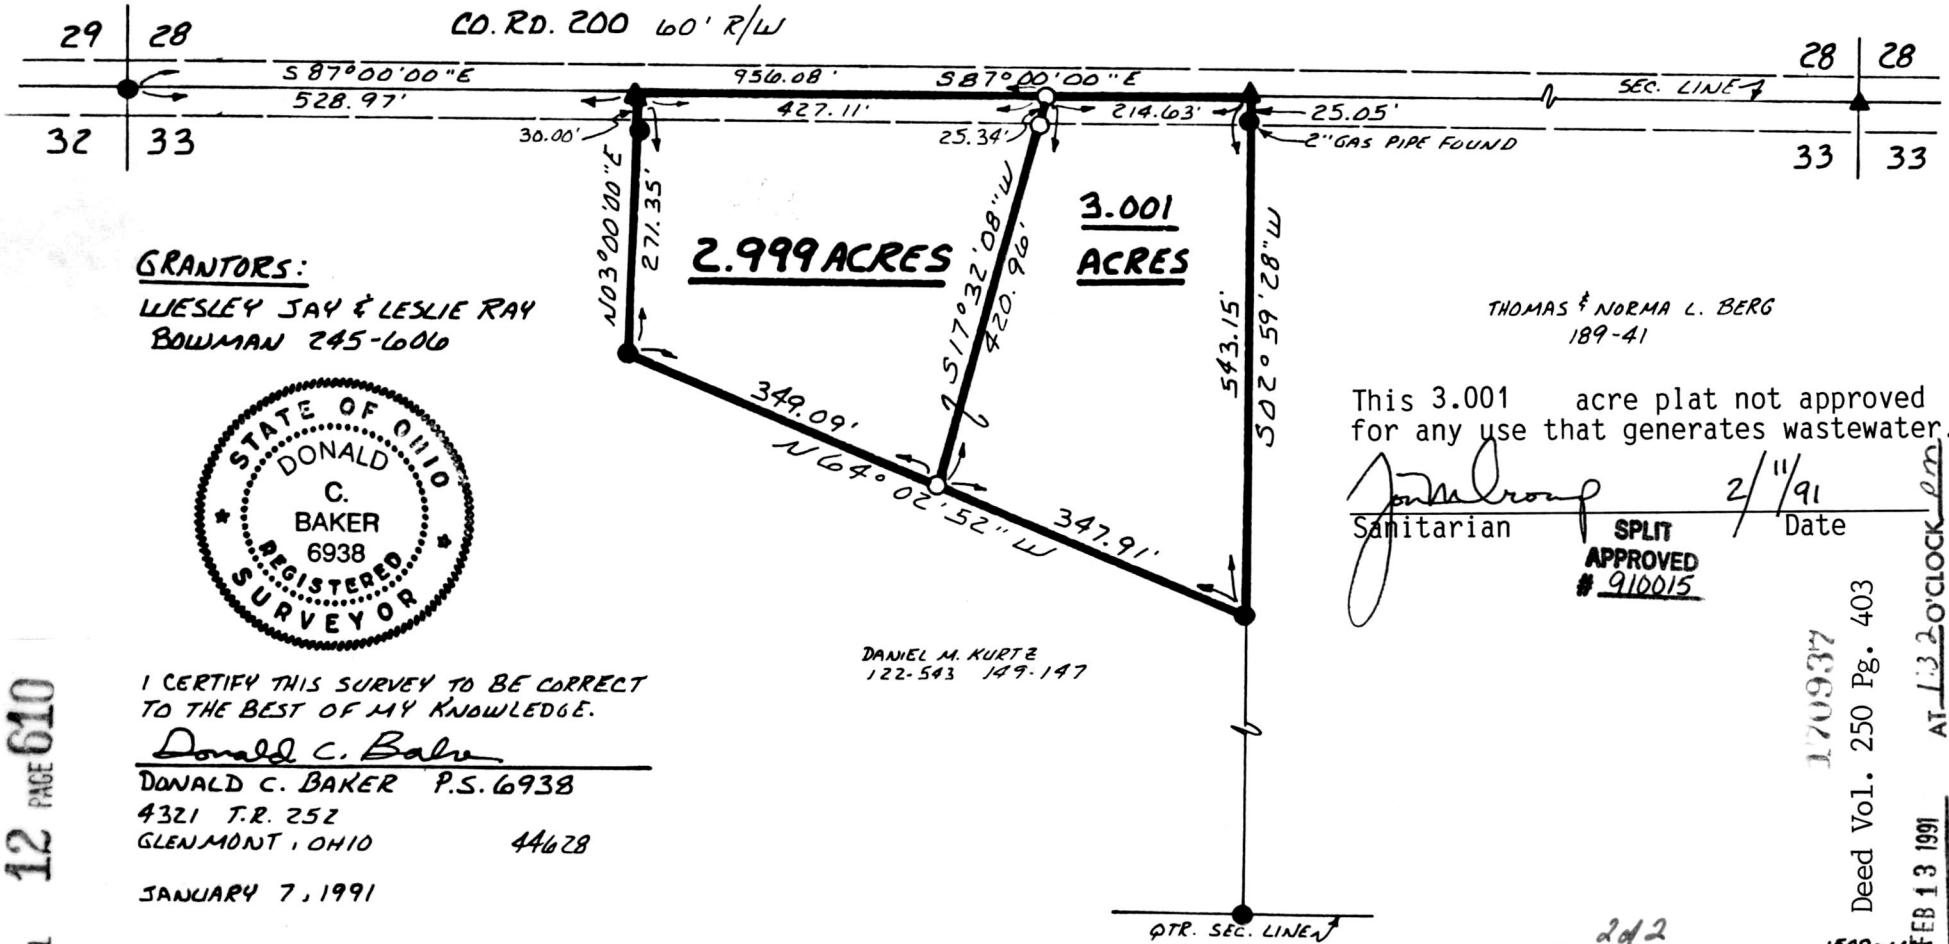

GRANTORS:

WESLEY JAY & LESLIE RAY
BOWMAN 245-6006

THOMAS & NORMA L. BERG
189-41



I CERTIFY THIS SURVEY TO BE CORRECT
TO THE BEST OF MY KNOWLEDGE.

Donald C. Baker
DONALD C. BAKER P.S. 6938
4321 T.R. 252
GLENMONT, OHIO 44628

JANUARY 7, 1991

DANIEL M. KURTZ
122-543 149-147

This 3.001 acre plat not approved
for any use that generates wastewater.

John Brown 2/11/91
Sanitarian Date
SPLIT APPROVED # 910015

170937

Deed Vol. 250 Pg. 403

AT 1:32 O'CLOCK PM
Holmes Co. Ohio Fee: \$9.00
Plat Vol. 12 Pg. 610 Recorder Richard Goren

2 of 2
PLAT APPROVED
2/13/91 B

VOL 12 PAGE 610