



CLARK TOWNSHIP
N.W. QTR. SECTION 22
T-8N ; R-5W
HOLMES COUNTY, OHIO

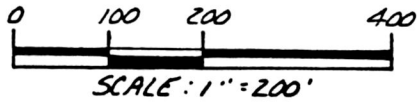

- ▲ R. R. SPIKE FOUND
- IRON PIN FOUND
- 5/8" REBAR WITH I. D. CAP SET
I. D. CAP MARKED "BAKER 6938"

REFERENCES:

PLAT VOL. 10 PAGE 587
DEED VOL. 188 PAGE 897
BEARINGS FROM PLAT VOL. 10 PAGE 587

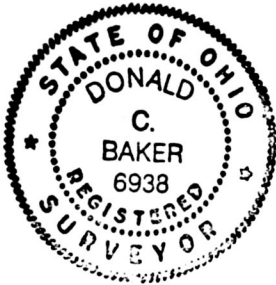


I CERTIFY THIS SURVEY TO BE CORRECT
TO THE BEST OF MY KNOWLEDGE.


Donald C. Baker
DONALD C. BAKER P.S. 6938
4321 T.R. 252
GLENMONT, OHIO 44628

JANUARY 8, 1991

GRANTORS:
MOSE E. & AMANDA RABER
188-897

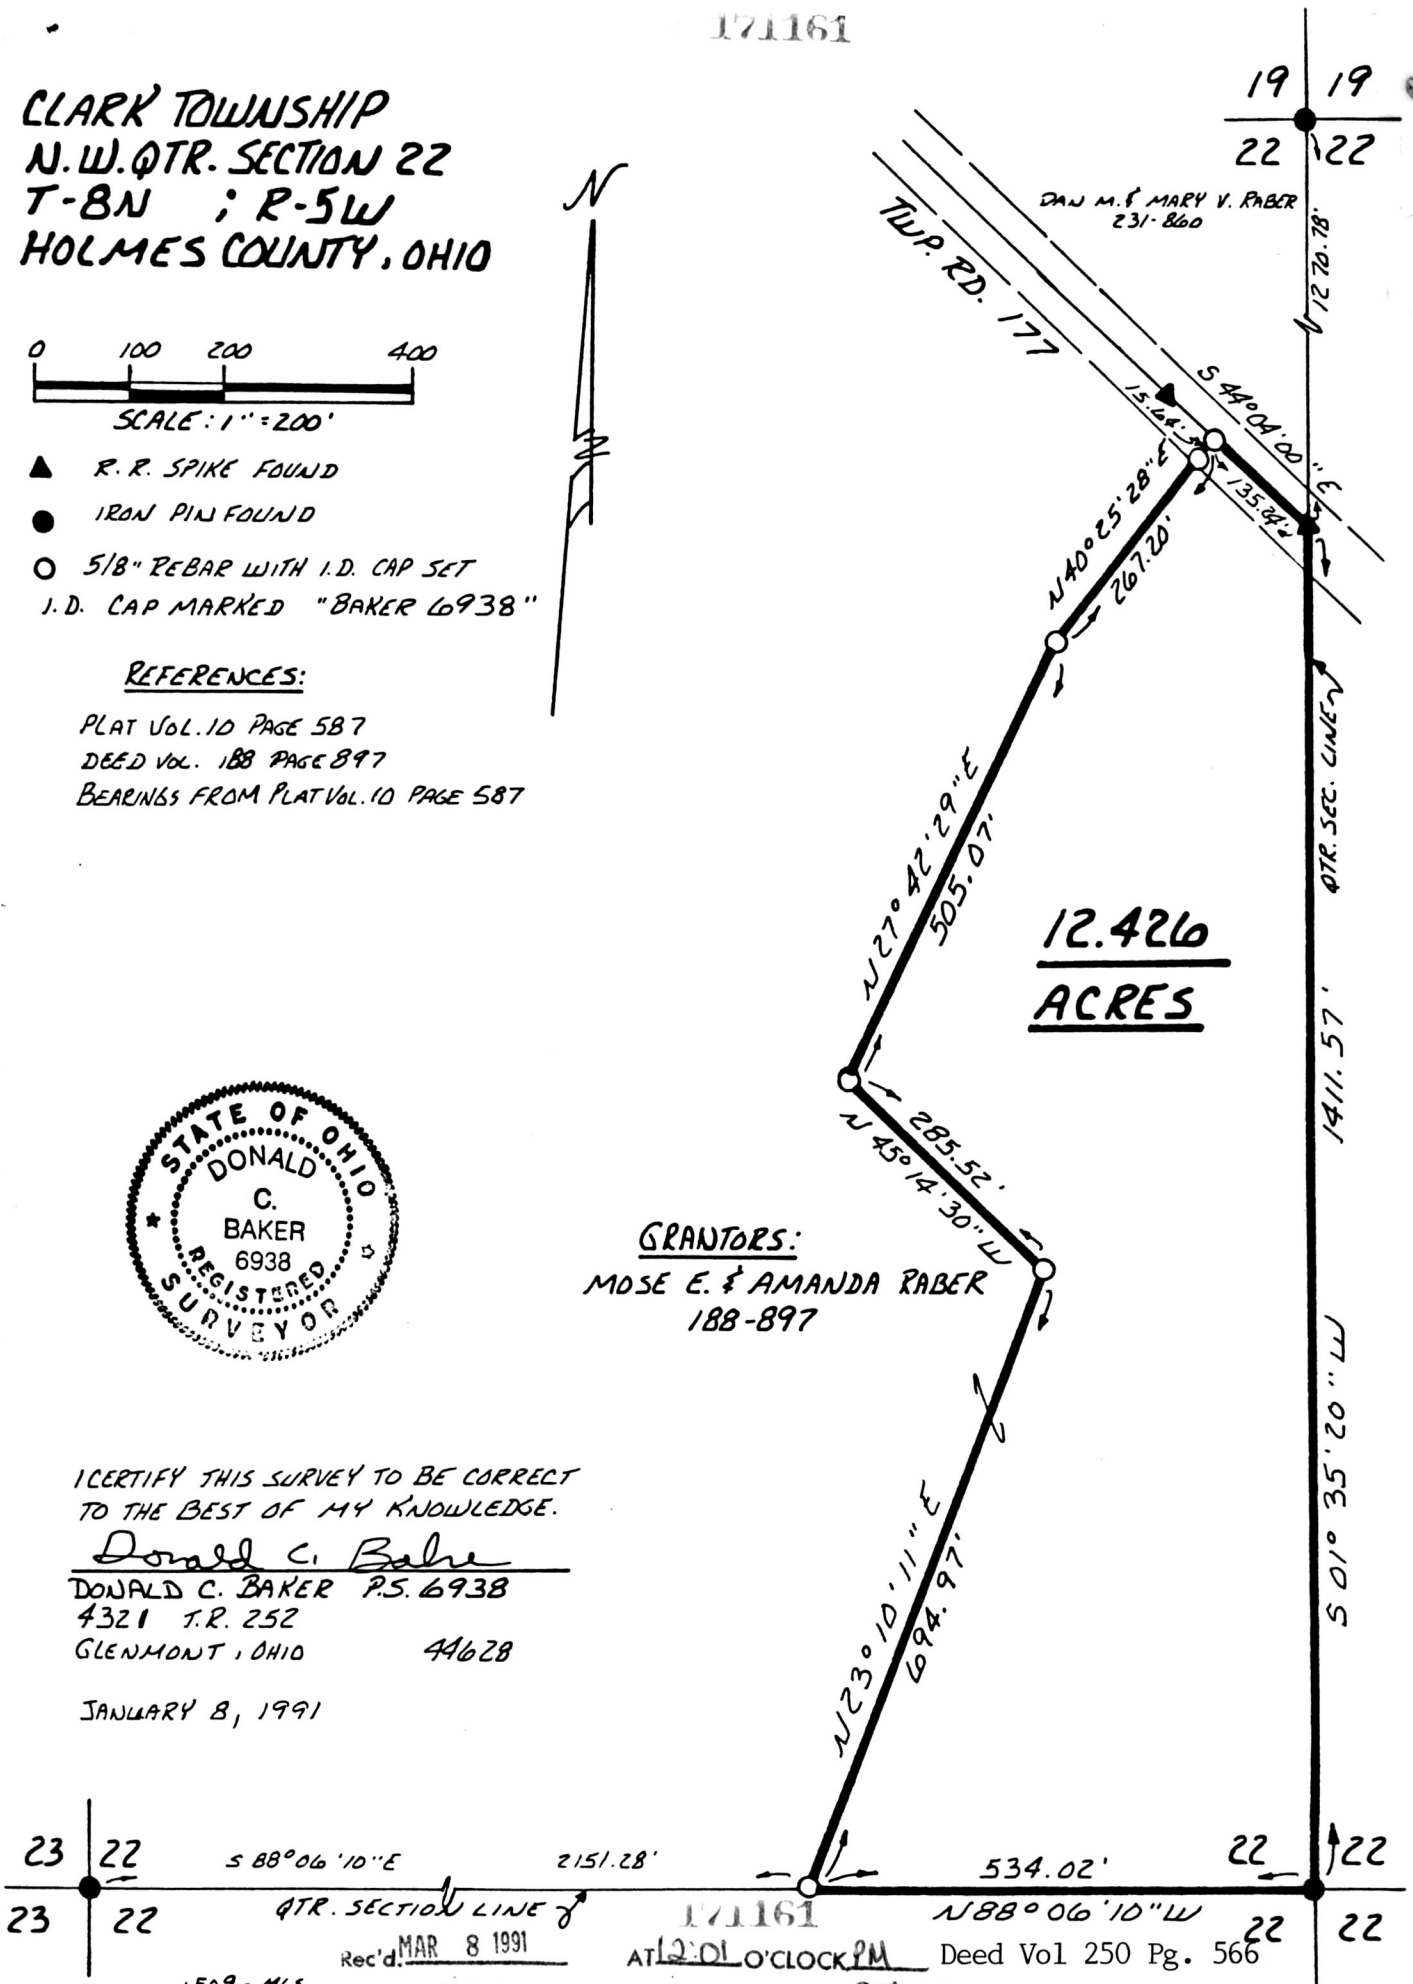

12.426
ACRES

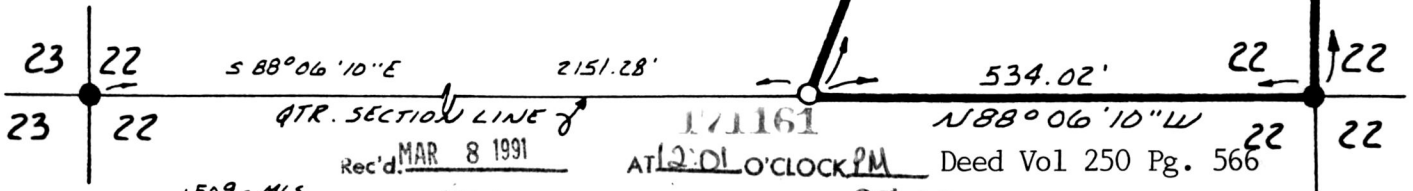

1509-MLS

Rec'd. MAR 8 1991
Recorded MAR 14 1991
Plat Vol. 12

171161
AT 12:01 O'CLOCK PM Deed Vol 250 Pg. 566
Holmes Co. Ohio Fee: \$5.00
Pg. 617 Recorder: [Signature] 3/8/91 B

PLAT APPROVED

caul