

pg 5.00

MONROE TOWNSHIP
2ND. QTR. LOT 8
T-9N; R-BW
HOLMES COUNTY, OHIO




● IRON PIN FOUND

REFERENCES:

PLAT VOL. 8 PAGE 473
PLAT VOL. 9 PAGE 115
PLAT VOL. 10 PAGE 732

BEARINGS FROM PLAT VOL. 12
PAGE 389

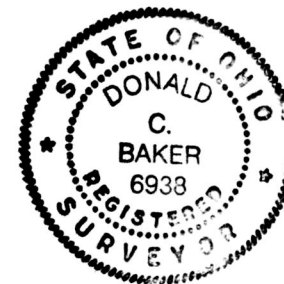

I CERTIFY THIS SURVEY TO BE CORRECT
TO THE BEST OF MY KNOWLEDGE

Donald C. Baker
DONALD C. BAKER P.S. 6938
4321 TR. 252
GLENMONT, OHIO 44628

MAY 9, 1991

INDEXED

172423

Rec'd. JUN 10 1991

2:40 PM

Recorded JUN 11 1991

Holmes Co. Ohio Fee: \$5.00


Plat Vol. 12

Pg. 674 Recorder Mary Ellen Siguster

cancel

PLAT APPROVED

4/10/91 B

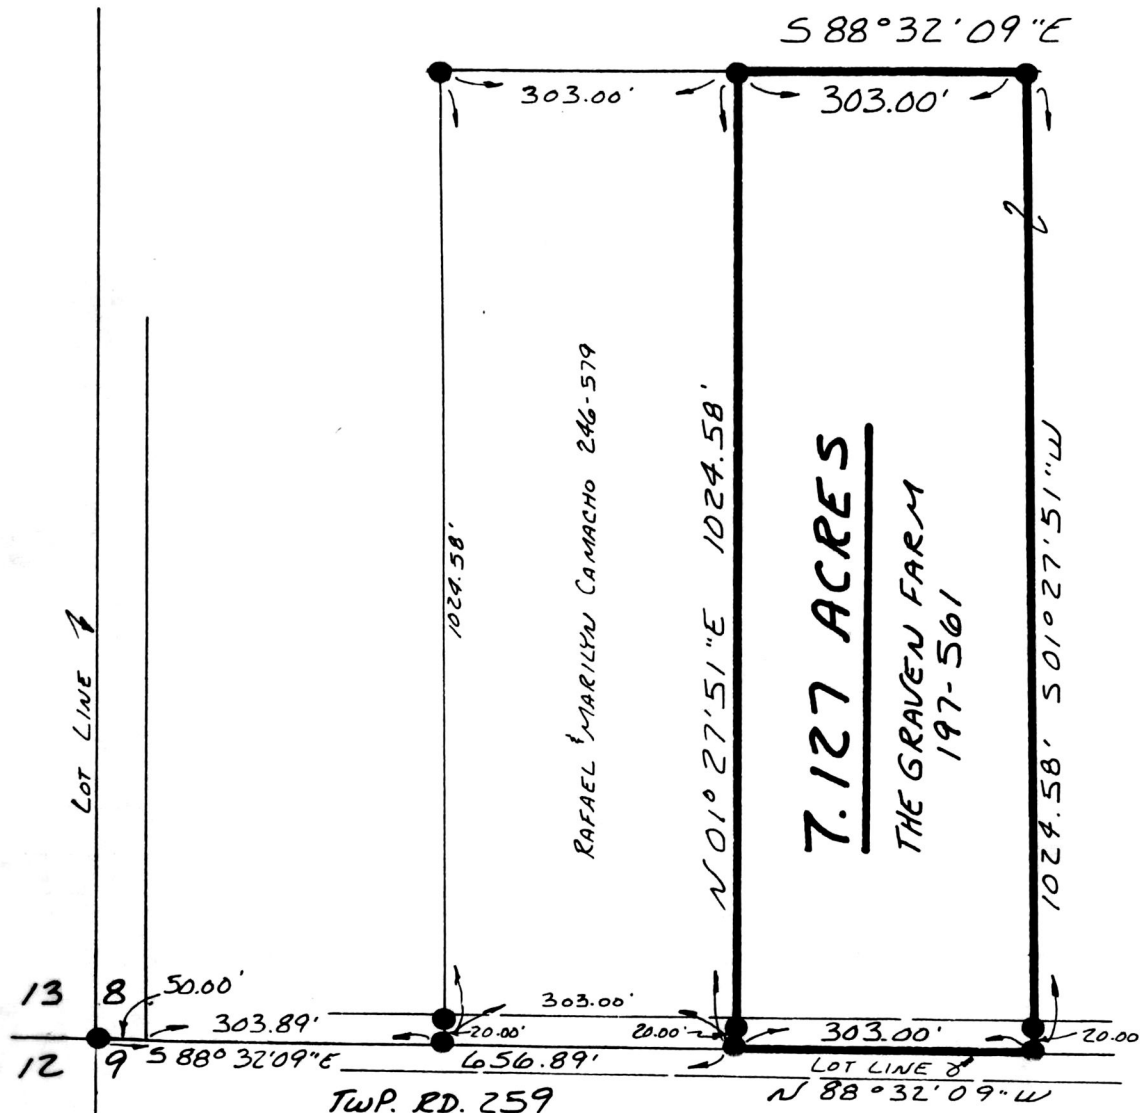

Deed Vol. 251 Page 678 & 681

1693-MLS

VOL 12 PAGE 674