


HARDY TOWNSHIP
S.W. QTR. SECTION 7
T-9N ; R-6W
HOLMES COUNTY, OHIO

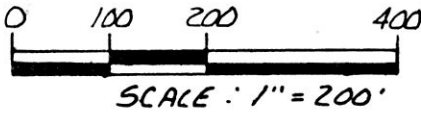


- IRON PIN FOUND
- 5/8" REBAR WITH I.D. CAP SET
I.D. CAP MARKED "BAKER 6938"


REFERENCES:

PLAT VOL. 10 PAGE 55
 PLAT VOL. 10 PAGE 425
 DEED VOL. 187 PAGE 389
 BEARINGS FROM PLAT VOL. 10 PAGE 55

LAWRENCE S. & MARY JANE EBY
187-389

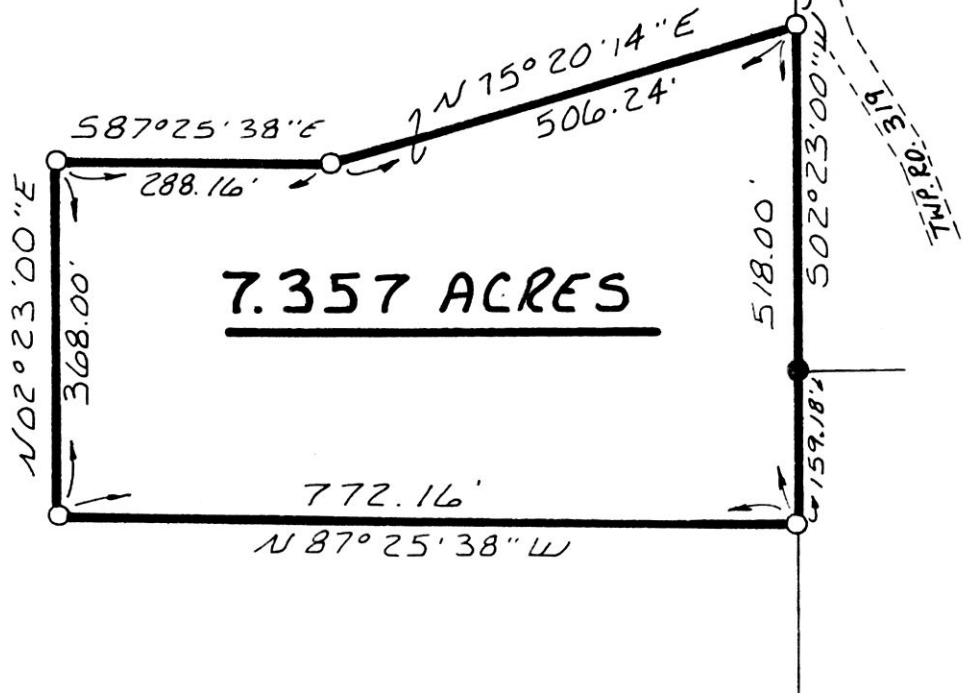

7.357 ACRES

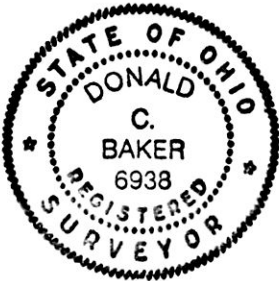

I CERTIFY THIS SURVEY TO BE CORRECT
TO THE BEST OF MY KNOWLEDGE.

Donald C. Baker

DONALD C. BAKER P.S. 6938
4321 T.R. 252
GLENMONT, OHIO 44628

MAY 6, 1991

INDEXED

Deed Vol. 251 Page 730
 JUN 13 1991
 Rec'd. _____ AT 3:16 O'CLOCK PM
 Recorded JUN 14 1991 Holmes Co. Ohio Fee: \$5.00
 Plat Vol. 12 Pg. 678 Recorder Mary Ellen Sigman

1675-MLS

Drain

PLAT APPROVED
6/13/91