


PAINT TOWNSHIP
3RD. QTR. LOT 11
T-10N R-4W
HOLMES COUNTY, OHIO

173031



pd. \$5.00

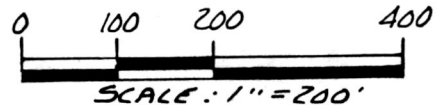


- IRON PIN FOUND
- 5/8" REBAR WITH I.D. CAP SET I.D. CAP MARKED "BAKER 6938"

REFERENCES:

- PLAT VOL. 12 PAGE 350
- PLAT VOL. 12 PAGE 395
- DEED VOL. 245 PAGE 676
- DEED VOL. 246 PAGE 688

BEARINGS FROM PLAT VOL. 8
PAGE 224

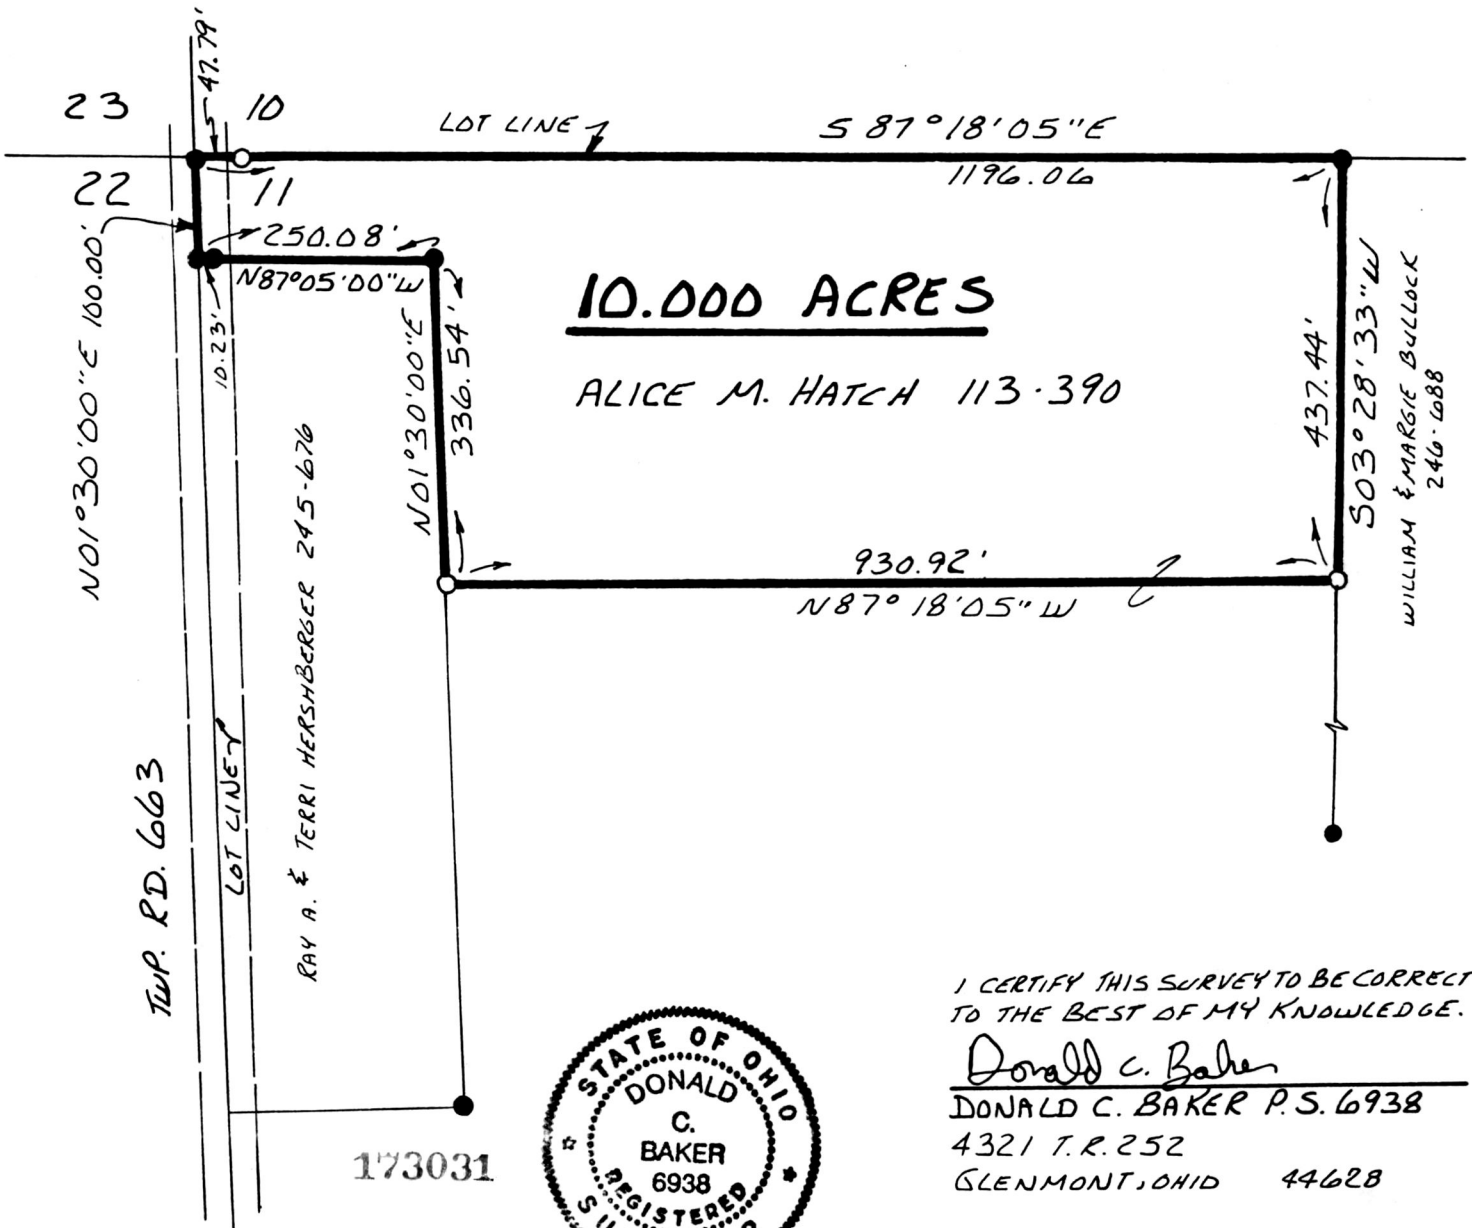

I CERTIFY THIS SURVEY TO BE CORRECT TO THE BEST OF MY KNOWLEDGE.

Donald C. Baker
DONALD C. BAKER P.S. 6938
4321 T.R. 252
GLENMONT, OHIO 44628

JUNE 7, 1991

1724-MCS Rec'd. JUL 25 1991

AT 2:42 O'CLOCK PM

Recorded JUL 26 1991

Holmes Co. Ohio Fee: \$5.00

Plat Vol. 12
Deed Vol 252 pg 303

Pg. 714

Recorder

Mary Ellen Leggett
Dan Wither

PLAT APPROVED
7/24/91 B