


CLARK TOWNSHIP
S.E. QTR. SEC. 5
T-8N ; R-5W
HOLMES CO., OHIO


(VILLAGE OF CHARM)

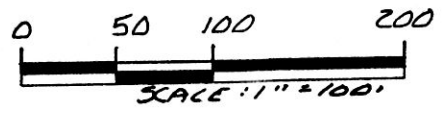

- STONE FOUND
- IRON PIN FOUND
- △ R.R. SPIKE FOUND
- P.K. NAIL SET
- 5/8" REBAR WITH I.D. CAP SET
I.D. CAP MARKED "BAKER 6938"

REFERENCES:

- PLAT VOL. 10 PAGE 127
- PLAT VOL. 7 PAGE 320
- PLAT VOL. 4 PAGE 163
- PLAT VOL. 8 PAGE 298
- PLAT VOL. 10 PAGE 824
- VARIOUS DEEDS AS SHOWN
- BEARINGS FROM DEED VOL. 186
PAGE 763

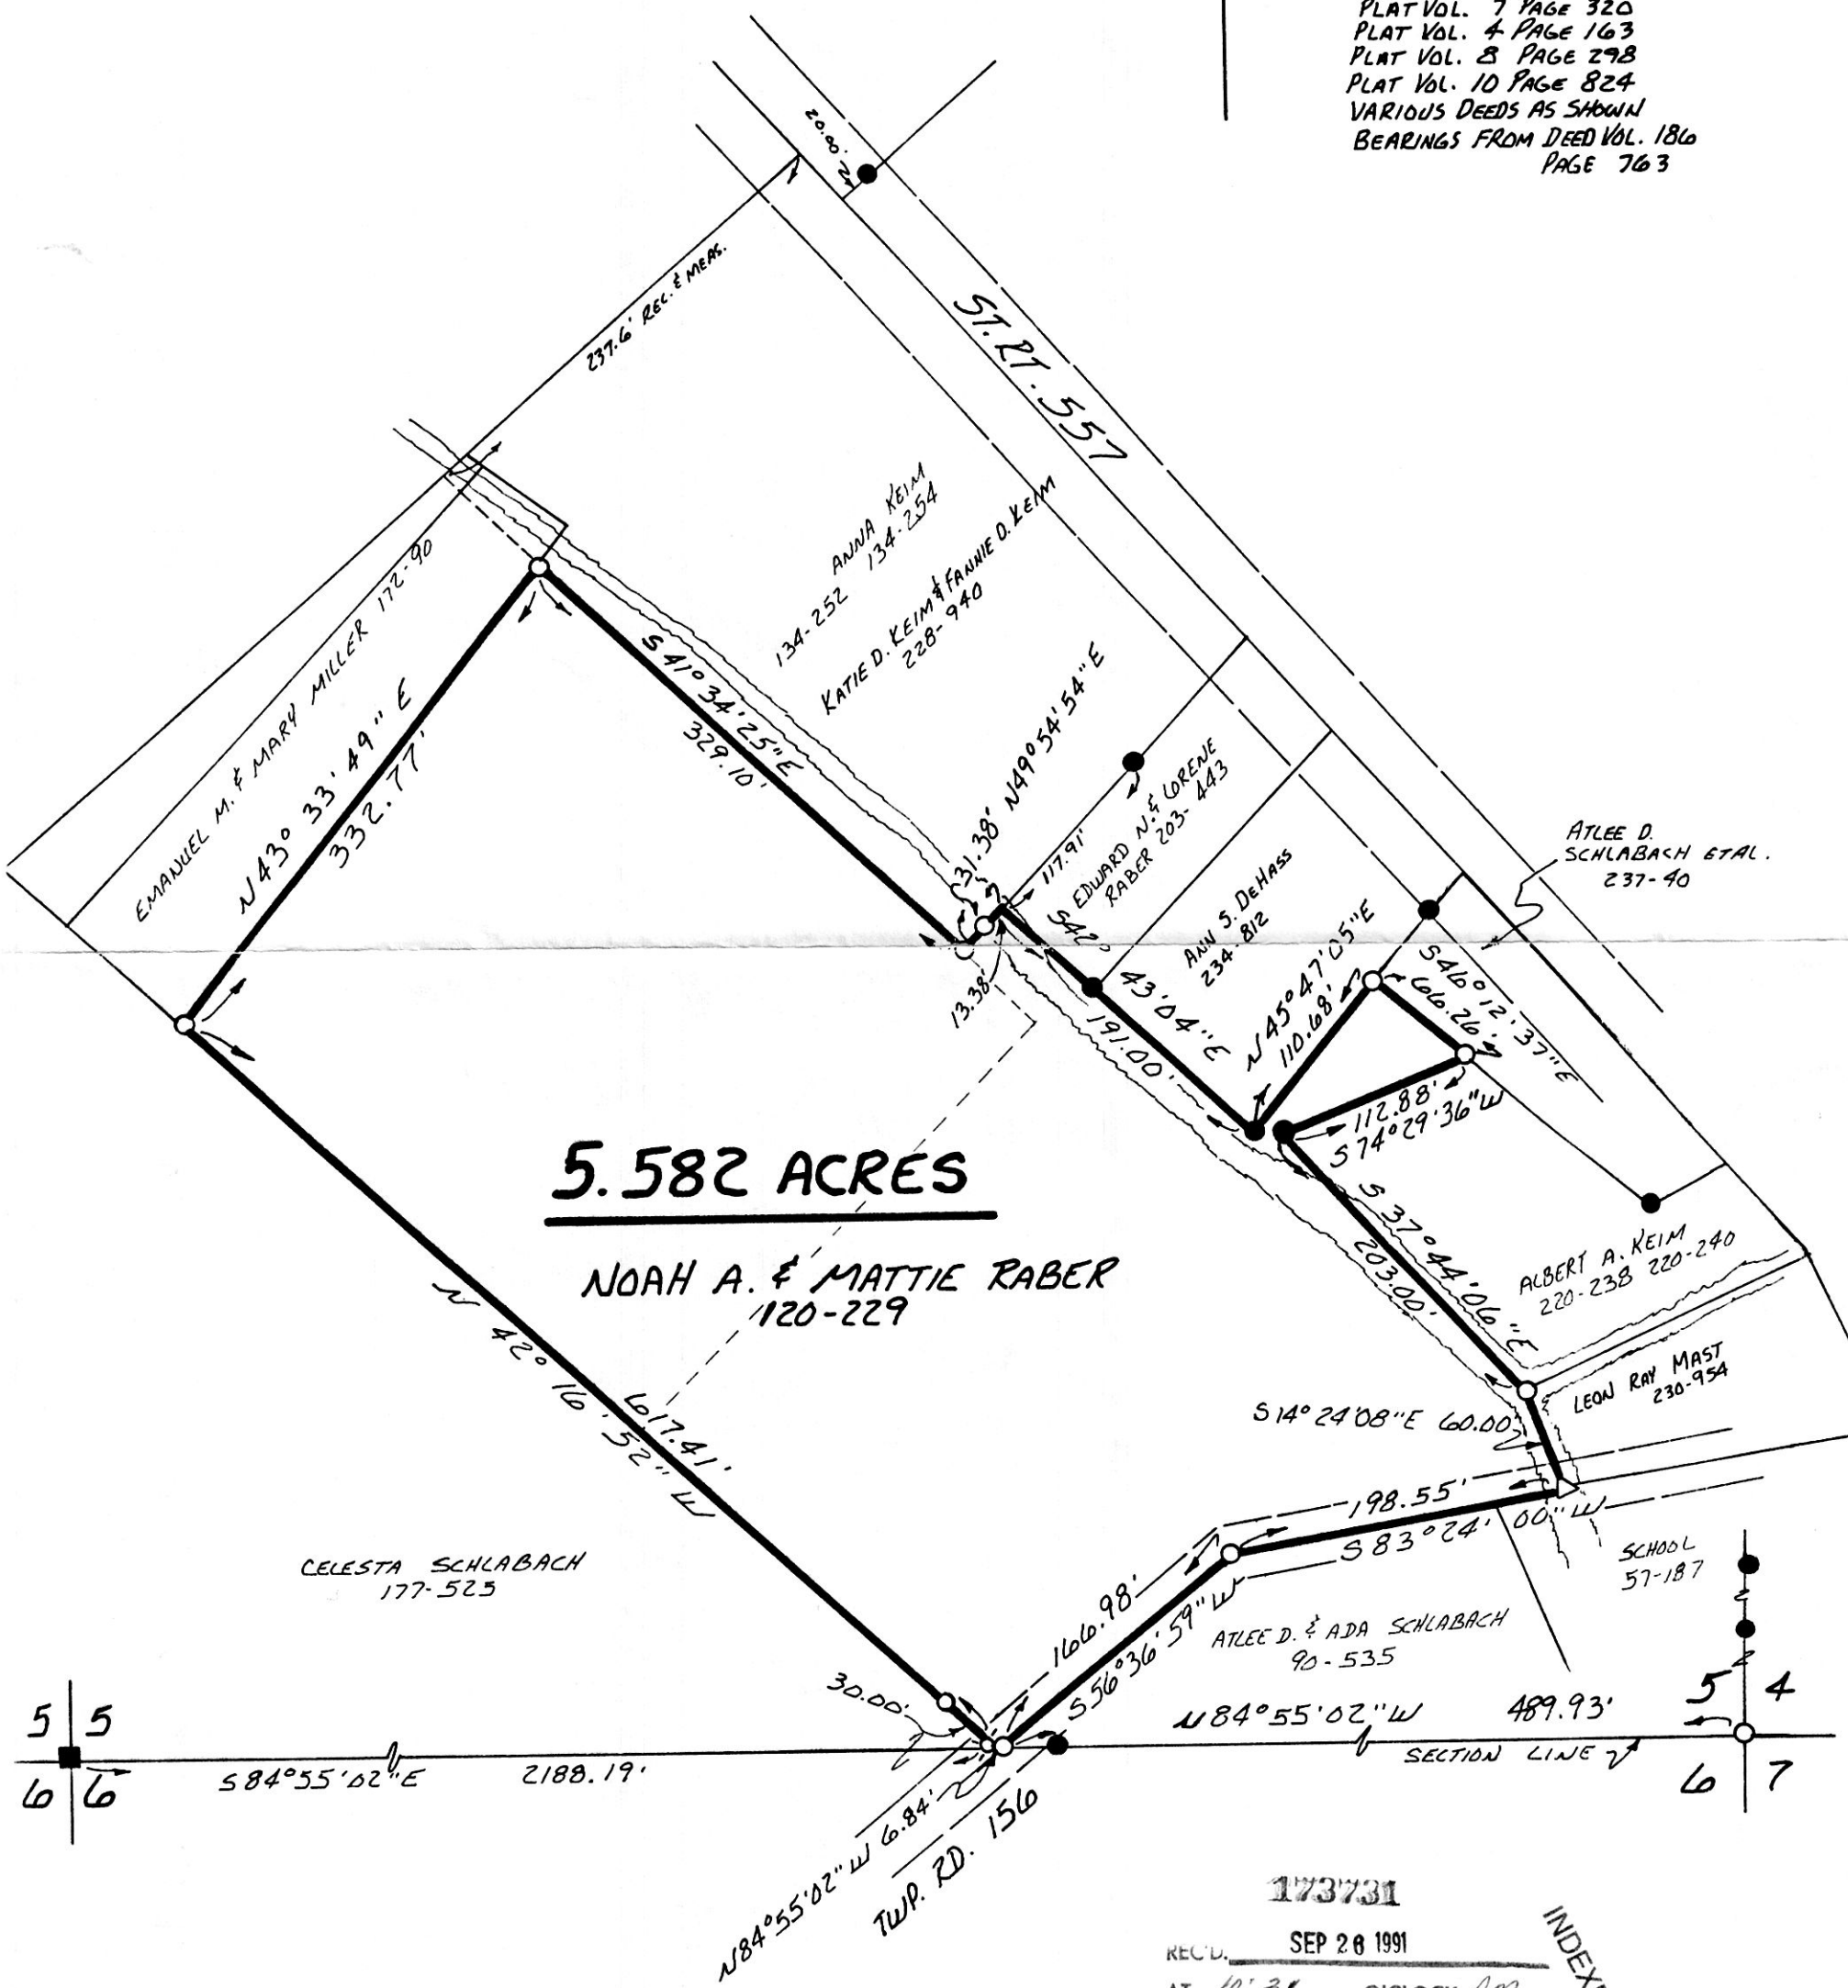

5.582 ACRES

**NOAH A. & MATTIE RABER
120-229**

5 5
6 6


5 4
6 7

I CERTIFY THIS SURVEY TO BE CORRECT
TO THE BEST OF MY KNOWLEDGE.

Donald C. Baker
DONALD C. BAKER P.S. 6938
4321 T.R. 252
CLEMONT OHIO 44628

JANUARY 25, 1991

1513B-MLS

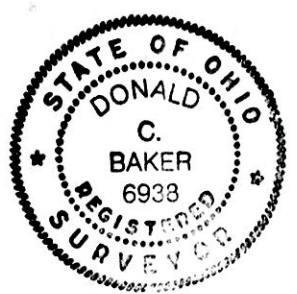

173731

REC'D. SEP 26 1991

AT 10:31 O'CLOCK AM

RECORDED SEP 27 1991

Plat VOL 12 PG 756

Holmes Co. Ohio Fee: 9.35

Mary Ellen Sigrist Recorder
Deed Vol. 252 pg 929

INDEXED

PLAT APPROVED
9/25/91 B