

Adam David Brandt
Vol. 230 Pg. 162

175104

pd 9.35

VOL 12 PAGE 841

Stone F'd at N.E. crnr S.E. 1/4
Sec. 4, T8N, R8W
P.B. 6 Pg. 18 paid no attention
to this stone at all. Hence
the North Line this survey
will not agree with
South Line of that one.

P.B. 6 Pg. 18

I. Pipe F'd 1980
NW. crnr N.E. 1/4 S.E. 1/4 Sec. 4, T8N, R8W

586°27'21"E 1,323.57'

It is called out in
P.B. 10 Pg. 519

S.E. 1/4 Sec. 4, T8N, R8W
Richland Twp., Hol. Co., Ohio

60.6911 Ac. Total

Joseph A. & Helen A. McDowell
Vol. 117 Pg. 143
Vol. 242 Pg. 362

This survey is of the lands of Joseph A. &
Helen A. McDowell in Richland Twp.

500°00'39"W
1,957.51'

60.6911 Ac. Total
18,2762 in S.E. 1/4 S.E. 1/4 Sec. 4, T8N, R8W
42,4149 Ac. in N.E. 1/4 S.E. 1/4 Sec. 4, T8N
R8W

Joseph A. & Helen A.
McDowell
Vol. 117 Pg. 143
Vol. 242 Pg. 362

Erwin F. Felix Vol. 171 Pg. 589 Rita G. Felix Vol. 171 Pg. 593
Vol. 190 Pg. 595
Vol. 200 Pg. 308



I. Pin set 1980

I. R set 1980

586°35'17"E 1,357.27' (calc.)

18,2762 acres in S.E. 1/4 S.E. 1/4 Sec. 4, T8N, R8W
N.W. corner of S.E. 1/4 mentioned in Vol. 71 Pg. 293 in deed
of S.E. 1/4 of Sec. 4, from Clayton Purdy to Wm. D.
T8N, R8W of McDowell.
Richland Twp.,
Hol. Co., Ohio. This tract was determined by using
578.17' on the East and West Lines and striking the
North Line across the tract and there by
calculating the acreage.

Sec. 3, T8N, R8W
Killbuck Twp.,
Hol. Co., Ohio

Donald B. & Greta C. Snyder
Vol. 213 Pg. 202
P.B. 8 Pg. 755

N 025°11' E 1,958.97'
578.17'

I. Pin set 1980

585°30'15"E 576.41'


587°24'30"E 585.15' & 93.34'

Dallas L. Bucklew
Vol. 145 Pg. 320

Pinched pipe F'd
bent somewhat to S.R. 520
the North but tight. 587°54'30"E
96.71'

Pond
Small ditch from pond.
Pinched pipe found,
very loose, tightened
it.

2.198 Ac. P.B. 8 Pg. 375 does
not indicate that it was
run Westward.
Robert P. & Libby A. Wengerd
Vol. 233 Pg. 290
P.B. 8 Pg. 375

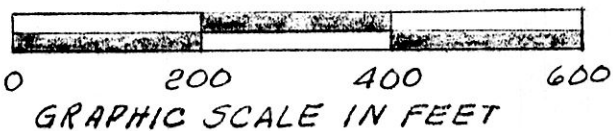

175104

REC'D. JAN 21 1992
AT 10:33 O'CLOCK am
RECORDED JAN 22 1992
Plat VOL 12 PG. 841
Holmes Co. Ohio Fee: 9.35
Mary Ellen Sigant Recorder
Deed vol 254 pg 198 Sam

INDEXED



PLAT OF A SURVEY FOR
JOSEPH A. McDOWELL Et ux
Known as part of the S.E. 1/4
of Sec. 4, T8N, R8W, of Rich-
land Twp., Hol. Co., Ohio
Robert L. Kasner P.S. 5193
P.E. 28820
4116190

PLAT APPROVED
1/15/92