


Kenneth N. & Deborah Ann Troyer
Vol. 254 Pg. 13

VOL 12 PAGE 857

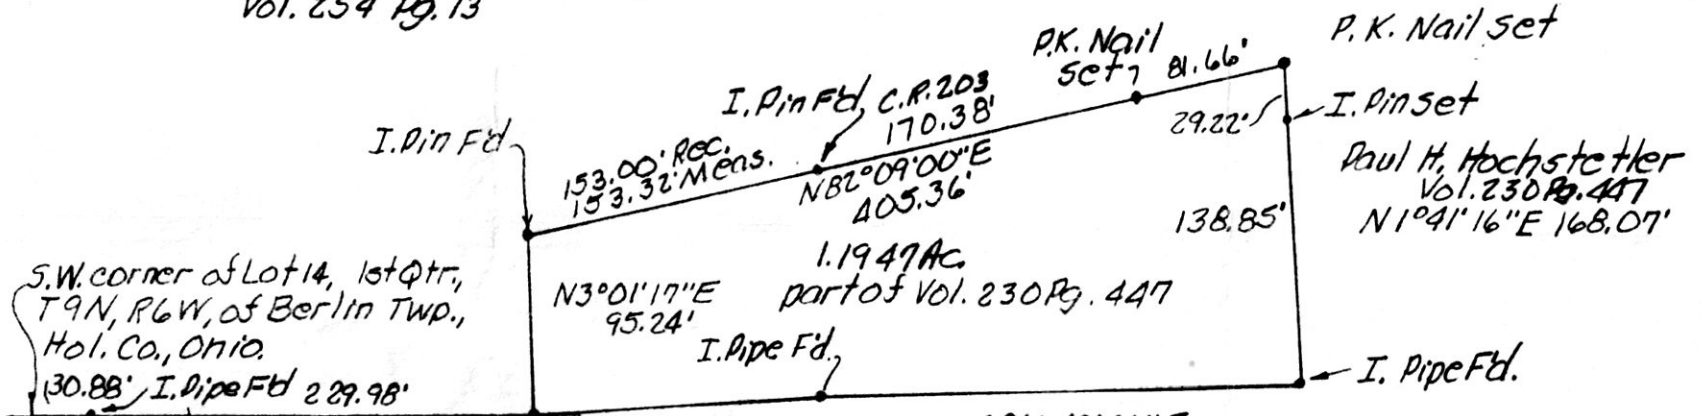


S.W. corner of Lot 14, 1st Qtr.,
T9N, R6W, of Berlin Twp.,
Hol. Co., Ohio.
30.88' I. Pipe Fd 229.98'

point in T.R. 353 585°21'31\"E 260.86' I. Pipe Fd
588°48'39\"E 151.79' I. Pipe Fd
586°42'26\"E 250.29' Mens. 250.21' Rec.

Brian & Karen Hummel
Vol. 236 Pg. 47
Brian & Karen Hummel
Vol. 206 Pg. 680

Brian & Karen Hummel
Vol. 243 Pg. 687

P.K. Nail set
I. Pin set
Paul H. Hochstetler
Vol. 230 Pg. 447
N1°41'16\"E 168.07'

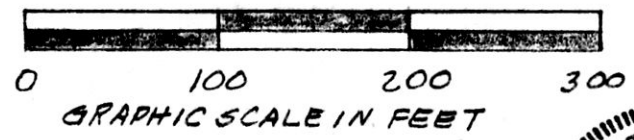

This 1.1947 acre parcel is not approved
for any use that generates wastewater.

[Signature] 1/27/92
Sanitarian Date



PAUL H. HOCHSTETLER
Grantor

Known as part of Lot 14, 1st
Qtr., T9N, R6W, of Berlin
Twp., Hol. Co., Ohio.

Robert L. Kasner P.S. 5193
175363 P.E. 28820

INDEXED 113192
PLAT APPROVED 2/4/92

REC'D. FEB 05 1992 At 1:07 O'CLOCK PM
Recorded FEB 06 1992 Holmes Co. Ohio Fee \$5.00
Plat Vol. 12 Pg. 857 Recorder Mary E. [Signature]