


WALNUT CREEK TOWNSHIP  
N.W. QTR. SECTION 20  
T-9N ; R-5W  
HOLMES COUNTY, OHIO

176269

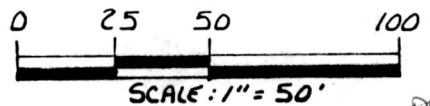


pd. 5.00

- ▲ BOLT FOUND
- IRON PIN FOUND
- 5/8" REBAR WITH I.D. CAP SET  
I.D. CAP MARKED "BAKER 6938"

REFERENCES:

- DEED VOL. 224 PAGE 515
- DEED VOL. 244 PAGE 322
- DEED VOL. 232 PAGE 387
- PLAT VOL. 12 PAGE 123
- PLAT VOL. 3 PAGE 23
- DEED VOL. 241 PAGE 723
- BEARINGS FROM PLAT VOL. 12  
PAGE 123

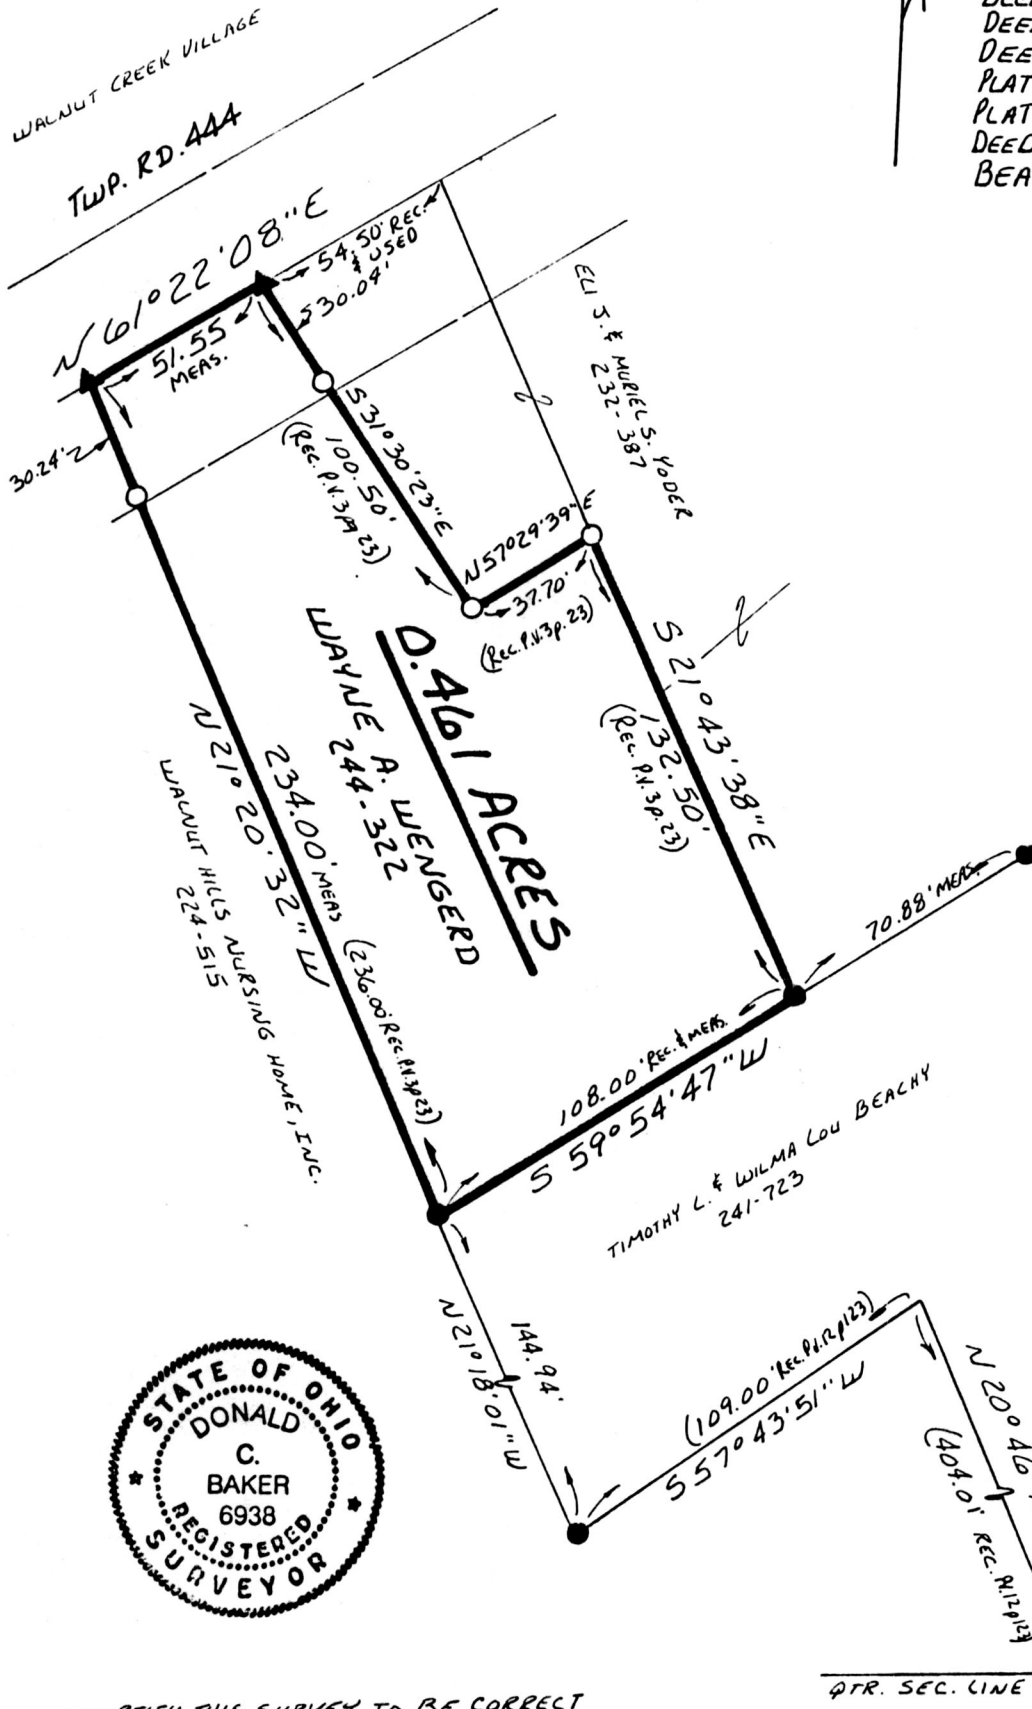

I CERTIFY THIS SURVEY TO BE CORRECT TO THE BEST OF MY KNOWLEDGE.

Donald C. Baker  
DONALD C. BAKER P.S. 6938  
4321 T.R. 252  
GLENMONT, OHIO 44628

APRIL 17, 1991

176269

Rec'd. APR 06 1992 AT 11:20 O'CLOCK am

Recorded APR 07 1992 Holmes Co. Ohio Fee: 5.00

Plat Vol. 12 Pg. 899 Recorder Mary Ellen Signst

Deed vol 255 pg 65 Laund

INDEXED

PLAT APPROVED  
4/3/92 B