


VOL 12 PAGE 903

BERLIN TOWNSHIP
4TH. QTR. LOT 1
T-9N ; R-6W
HOLMES COUNTY, OHIO

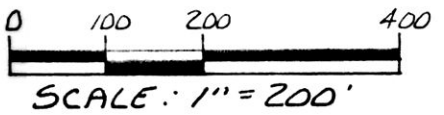

● IRON PIN FOUND

REFERENCES:

- DEED Vol. 221 PAGE 392
- PLAT Vol. 2 PAGE 204
- DEED Vol. 233 PAGE 868
- DEED Vol. 233 PAGE 864
- PLAT Vol. 9 PAGE 193

BEARINGS FROM PLAT Vol. 11
PAGE 122





I CERTIFY THIS SURVEY TO BE CORRECT
TO THE BEST OF MY KNOWLEDGE.

Donald C. Baker
DONALD C. BAKER P.S. 6938
4321 T. R. 252
GLENMONT, OHIO 44628


SEPTEMBER 24, 1991

1899-MLS

176308

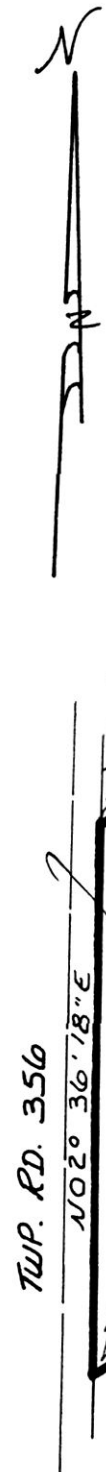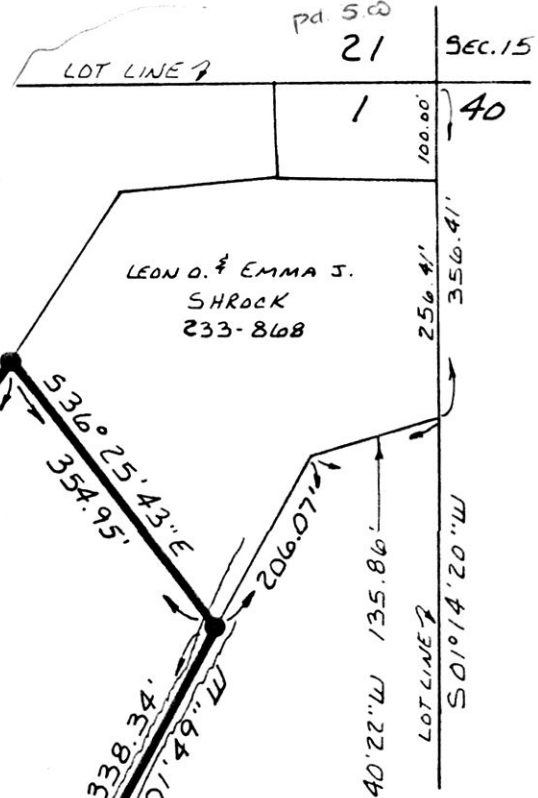

11.722 ACRES
CARL H. & NAOMI YODER
221-392

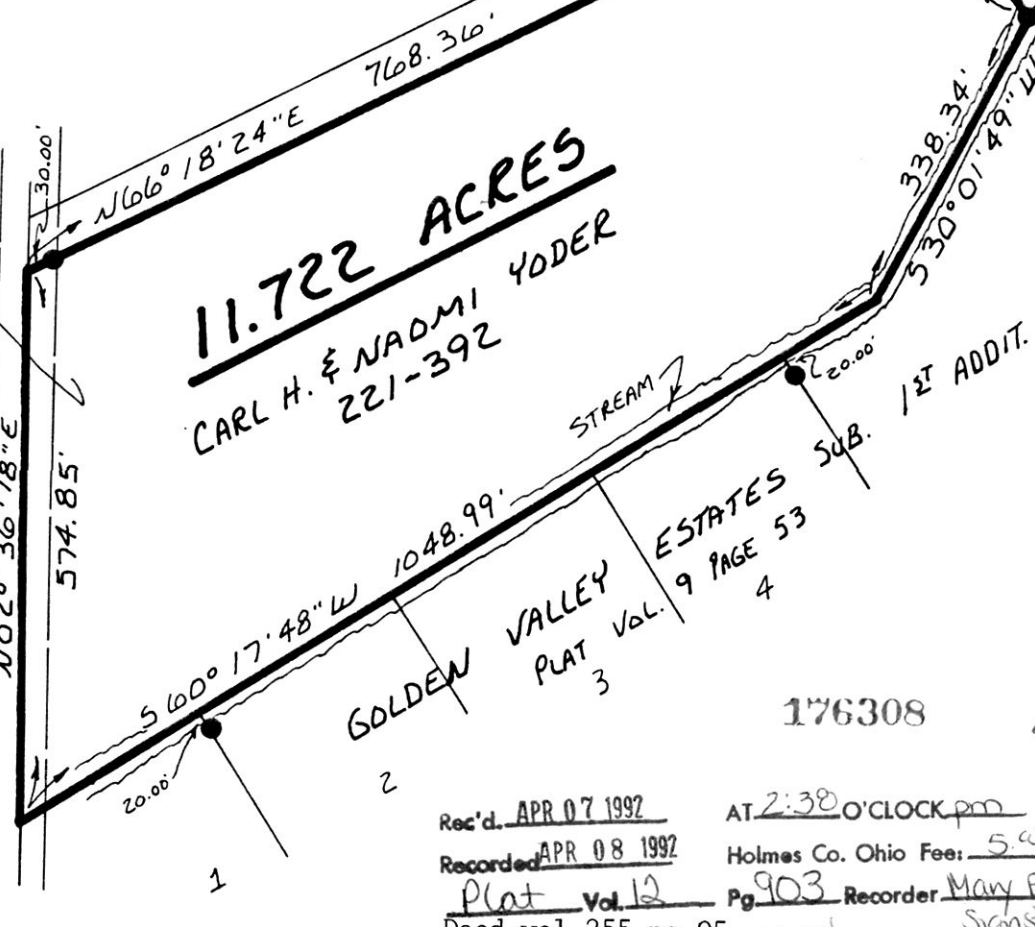

176308

INDEXED

Rec'd. APR 07 1992 AT 2:38 O'CLOCK pm
 Recorded APR 08 1992 Holmes Co. Ohio Fee: 5.00
 Plat Vol. 12 Pg. 903 Recorder Mary Ellen
 Deed vol 255 pg 95 Laurel Signist

PLAT APPROVED
4/7/92 B