

MAIN ST. 66'

VILLAGE OF WINESBURG  
PART OF LOT 27

PAINT TWP., 3RD. PTR.  
LOT 38, T. 10N; R. 4W  
HOLMES COUNTY, OHIO




SCALE: 1" = 30'

- AXLE FOUND
- 5/8" RE BAR WITH I.D. CAP SET  
I.D. CAP MARKED "BAKER 6938"
- ⊙ DRILL HOLE IN CONCRETE

REFERENCES:

- PLAT VOL. 8 PAGE 53
- PLAT VOL. 11 PAGE 22
- PLAT VOL. 8 PAGE 452
- SURVEY RECORD 3 PAGE 236
- DEED VOL. 251 PAGE 413
- BEARINGS FROM S.R. 5 Pg. 317

CHESTNUT ST. 35'

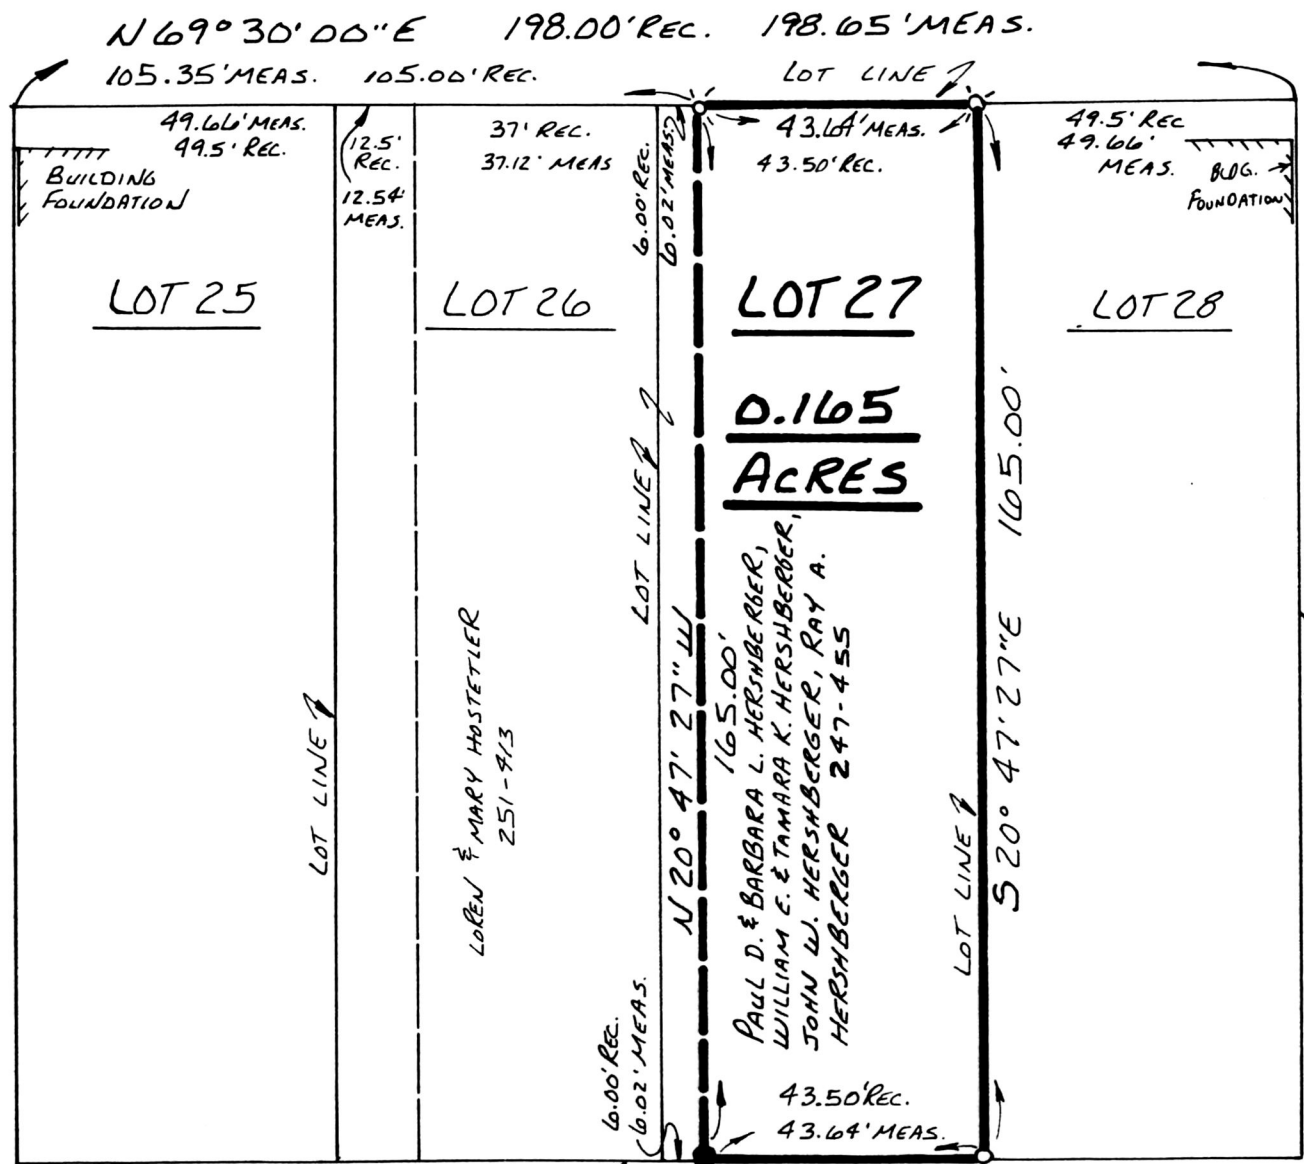

WOOD ST. 35' AKA T-1026

33' ALLEY AKA VINTAGE ST. AKA T-1025



177210

I CERTIFY THIS SURVEY TO BE CORRECT  
TO THE BEST OF MY KNOWLEDGE.

Donald C. Baker  
DONALD C. BAKER P.S. 6938  
5958 T.R. 322  
MILLERSBURG, OHIO 44654  
PH. (216) 674-4788  
MAY 27, 1992

Rec'd. JUN 04 1992 AT 2:22 o'clock pm INDEXED  
Recorded JUN 05 1992 Holmes Co. Ohio Fee: 5.00  
Plat Vol. 12 pg. 947 Recorder Mary Ellen Signot  
Deed vol 255 pg 775  
PLAT APPROVED 4/1/92  
21992-MCS