VOL 12 PAGE 959 pd. 9.35

177386

HARDY TOWNSHIP
1ST. QTR. LOTS 15 & 20
T-9N ; R-7W
HOLMES COUNTY, OHIO

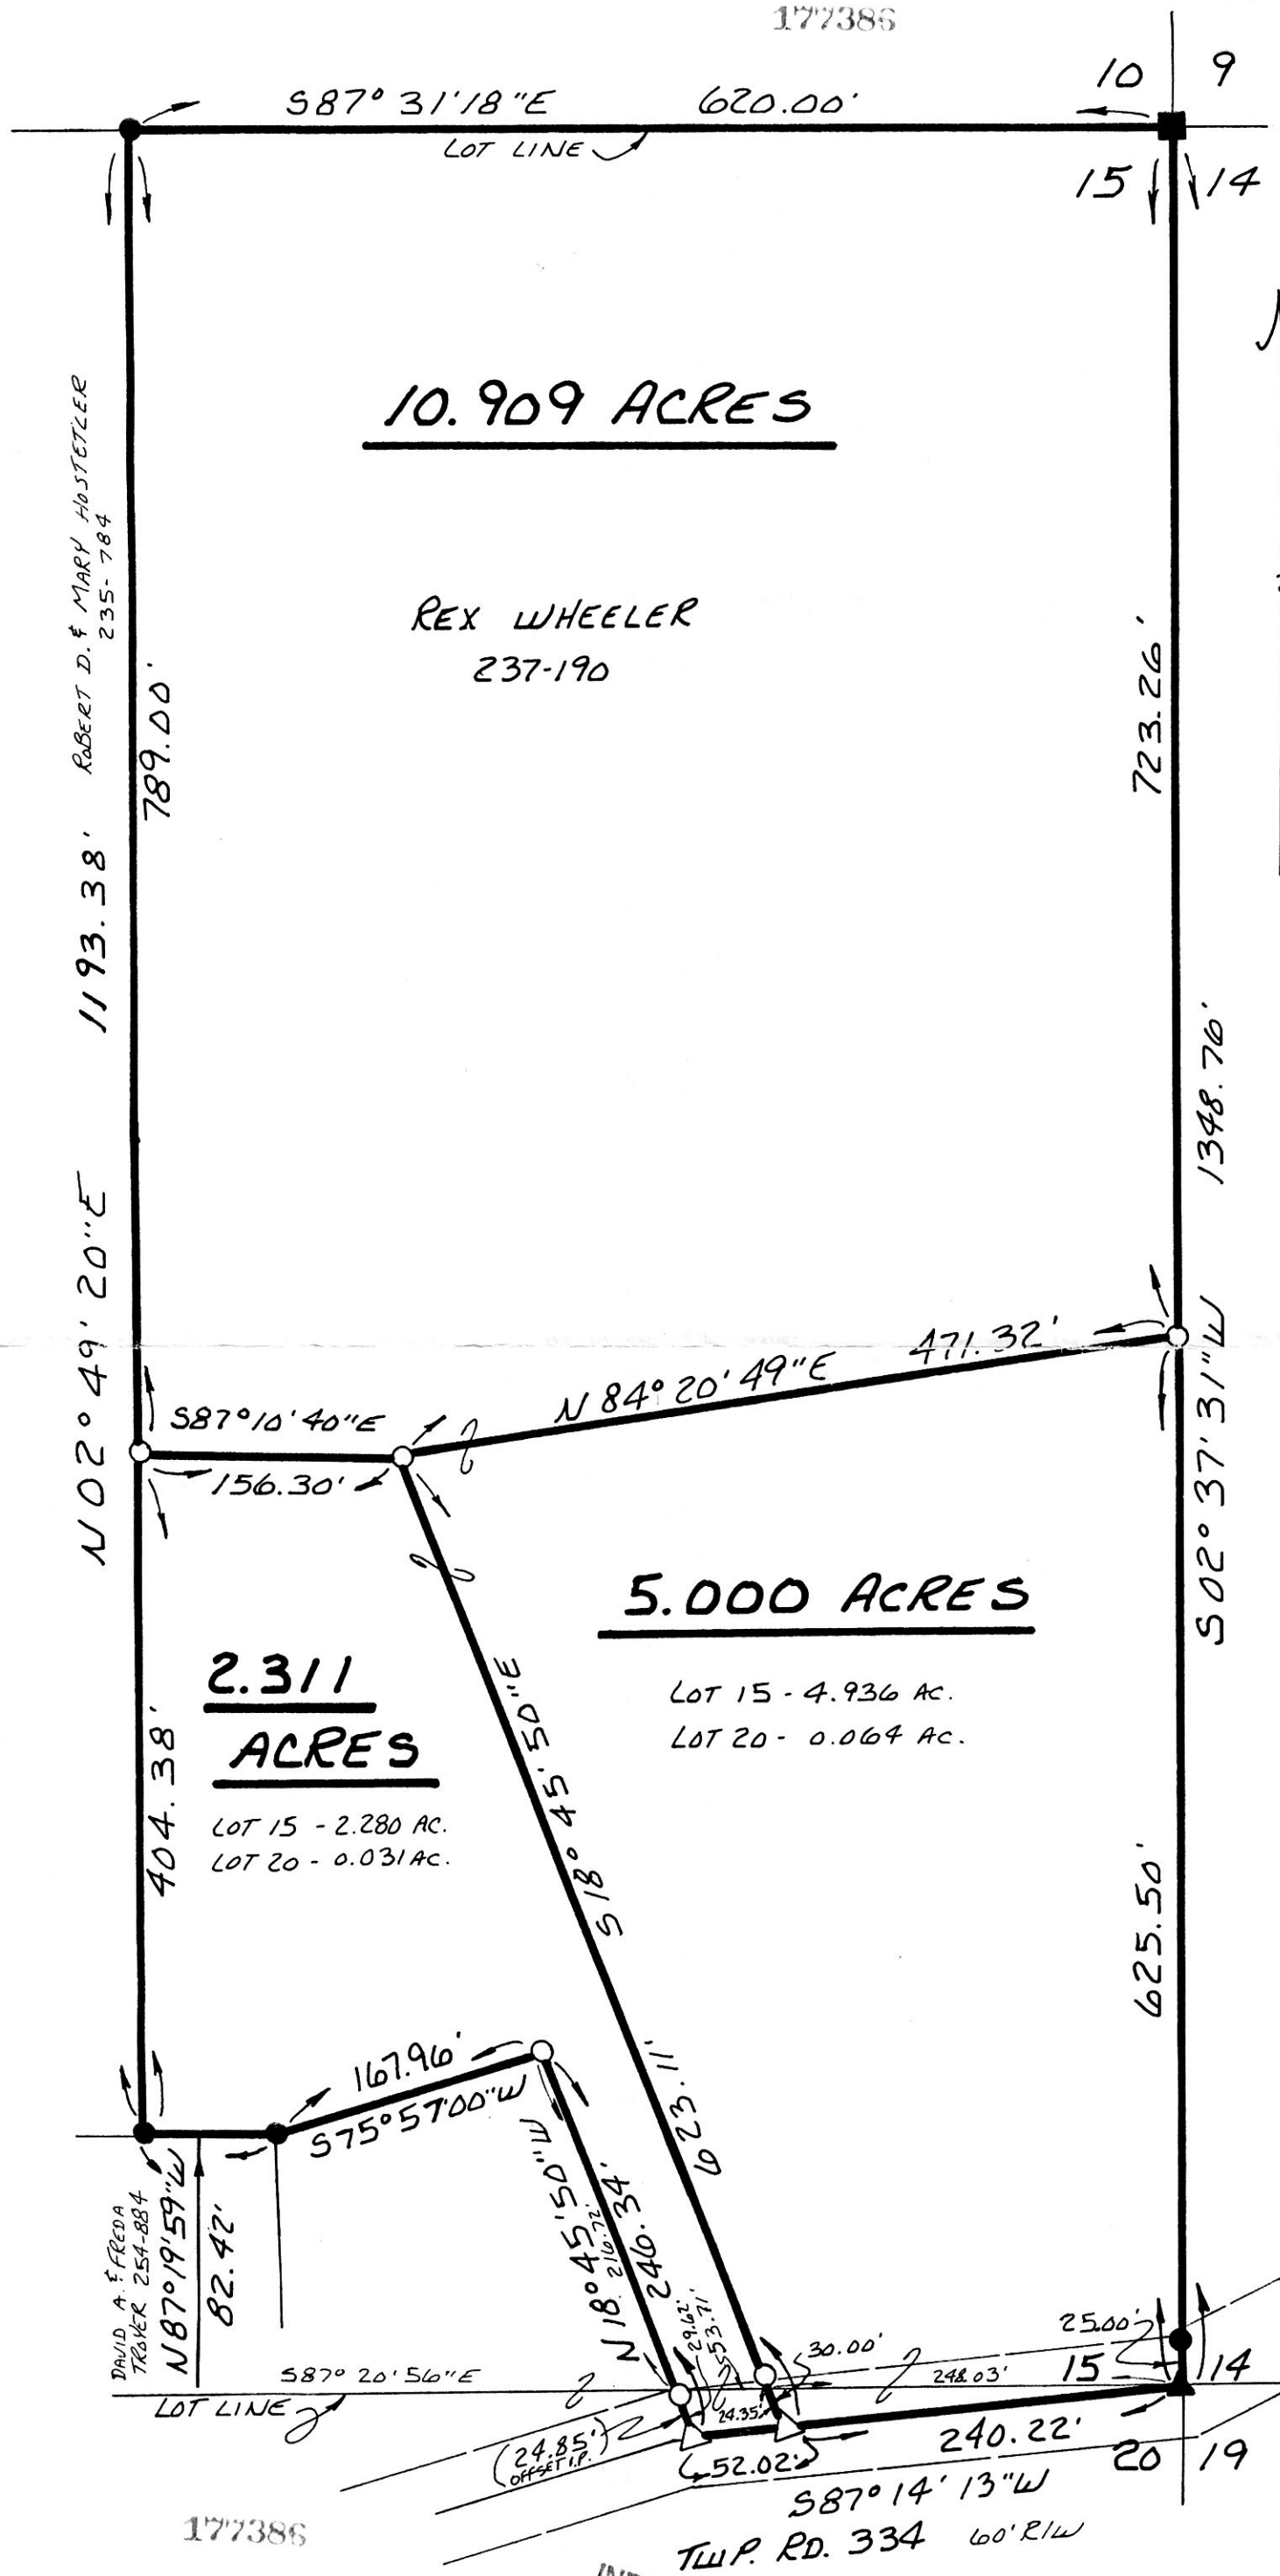

0 50 100 200
SCALE: 1" = 100'

- ■ STONE FOUND
- ▲ R.R. SPIKE FOUND
- ● IRON PIN FOUND
- △ R.R. SPIKE SET
- ○ 5/8" RE BAR WITH I.D. CAP SET

I.D. CAP MARKED "BAKER 6938"

REFERENCES:

PLAT VOL. 7 PAGE 31
PLAT VOL. 10 PAGE 86
PLAT VOL. 10 PAGE 15
DEED VOL. 235 PAGE 784
DEED VOL. 237 PAGE 190
DEED VOL. 254 PAGE 884

BEARINGS FROM PLAT VOL. 10 PAGE 775

STATE OF OHIO
DONALD C. BAKER
6933
REGISTERED SURVEYOR

I CERTIFY THIS SURVEY TO BE CORRECT TO THE BEST OF MY KNOWLEDGE.

Donald C. Baker

DONALD C. BAKER P.S. 6938
5958 T.R. 322
MILLERSBURG, OHIO 44654
PH. (216) 674-4788

JUNE 2, 1992

©1992-MLS

177386

INDEXED

Rec'd. JUN 15 1992 AT 3:00 O'CLOCK pm
Recorded JUN 16 1992 Holmes Co. Ohio Fee: 9.35
Plat Vol. 12 Pg. 959 Recorder Mary Ellen Signst
RR
Deed vol 255 pg 925

PLAT APPROVED 6/11/92