

SCALE: 1" = 300'

- STONE FOUND
- IRON PIN FOUND
- 5/8" RE BAR WITH I.D. CAP SET
- I.D. CAP MARKED "BAKER 6938"

RIPLEY TOWNSHIP  
 N.W. QTR. SECTION 13  
 N.E. QTR. SECTION 14  
 T-17N ; R-14W  
 HOLMES COUNTY, OHIO

**REFERENCES:**  
 PLAT Vol. 5 PAGE 5  
 PLAT Vol. 10 PAGE 622  
 DEED Vol. 255 PAGE 693  
 DEED Vol. 225 PAGE 351  
 DEED Vol. 186 PAGE 529  
 BEARINGS FROM DEED Vol. 253 PAGE 563




I CERTIFY THIS SURVEY TO BE CORRECT  
 TO THE BEST OF MY KNOWLEDGE.

**Donald C. Baker**  
 DONALD C. BAKER P.S. 6938  
 5958 T.R. 322  
 MILLERSBURG, OHIO 44654  
 PH. (216) 674-4788

AUGUST 14, 1992

34292-MLS

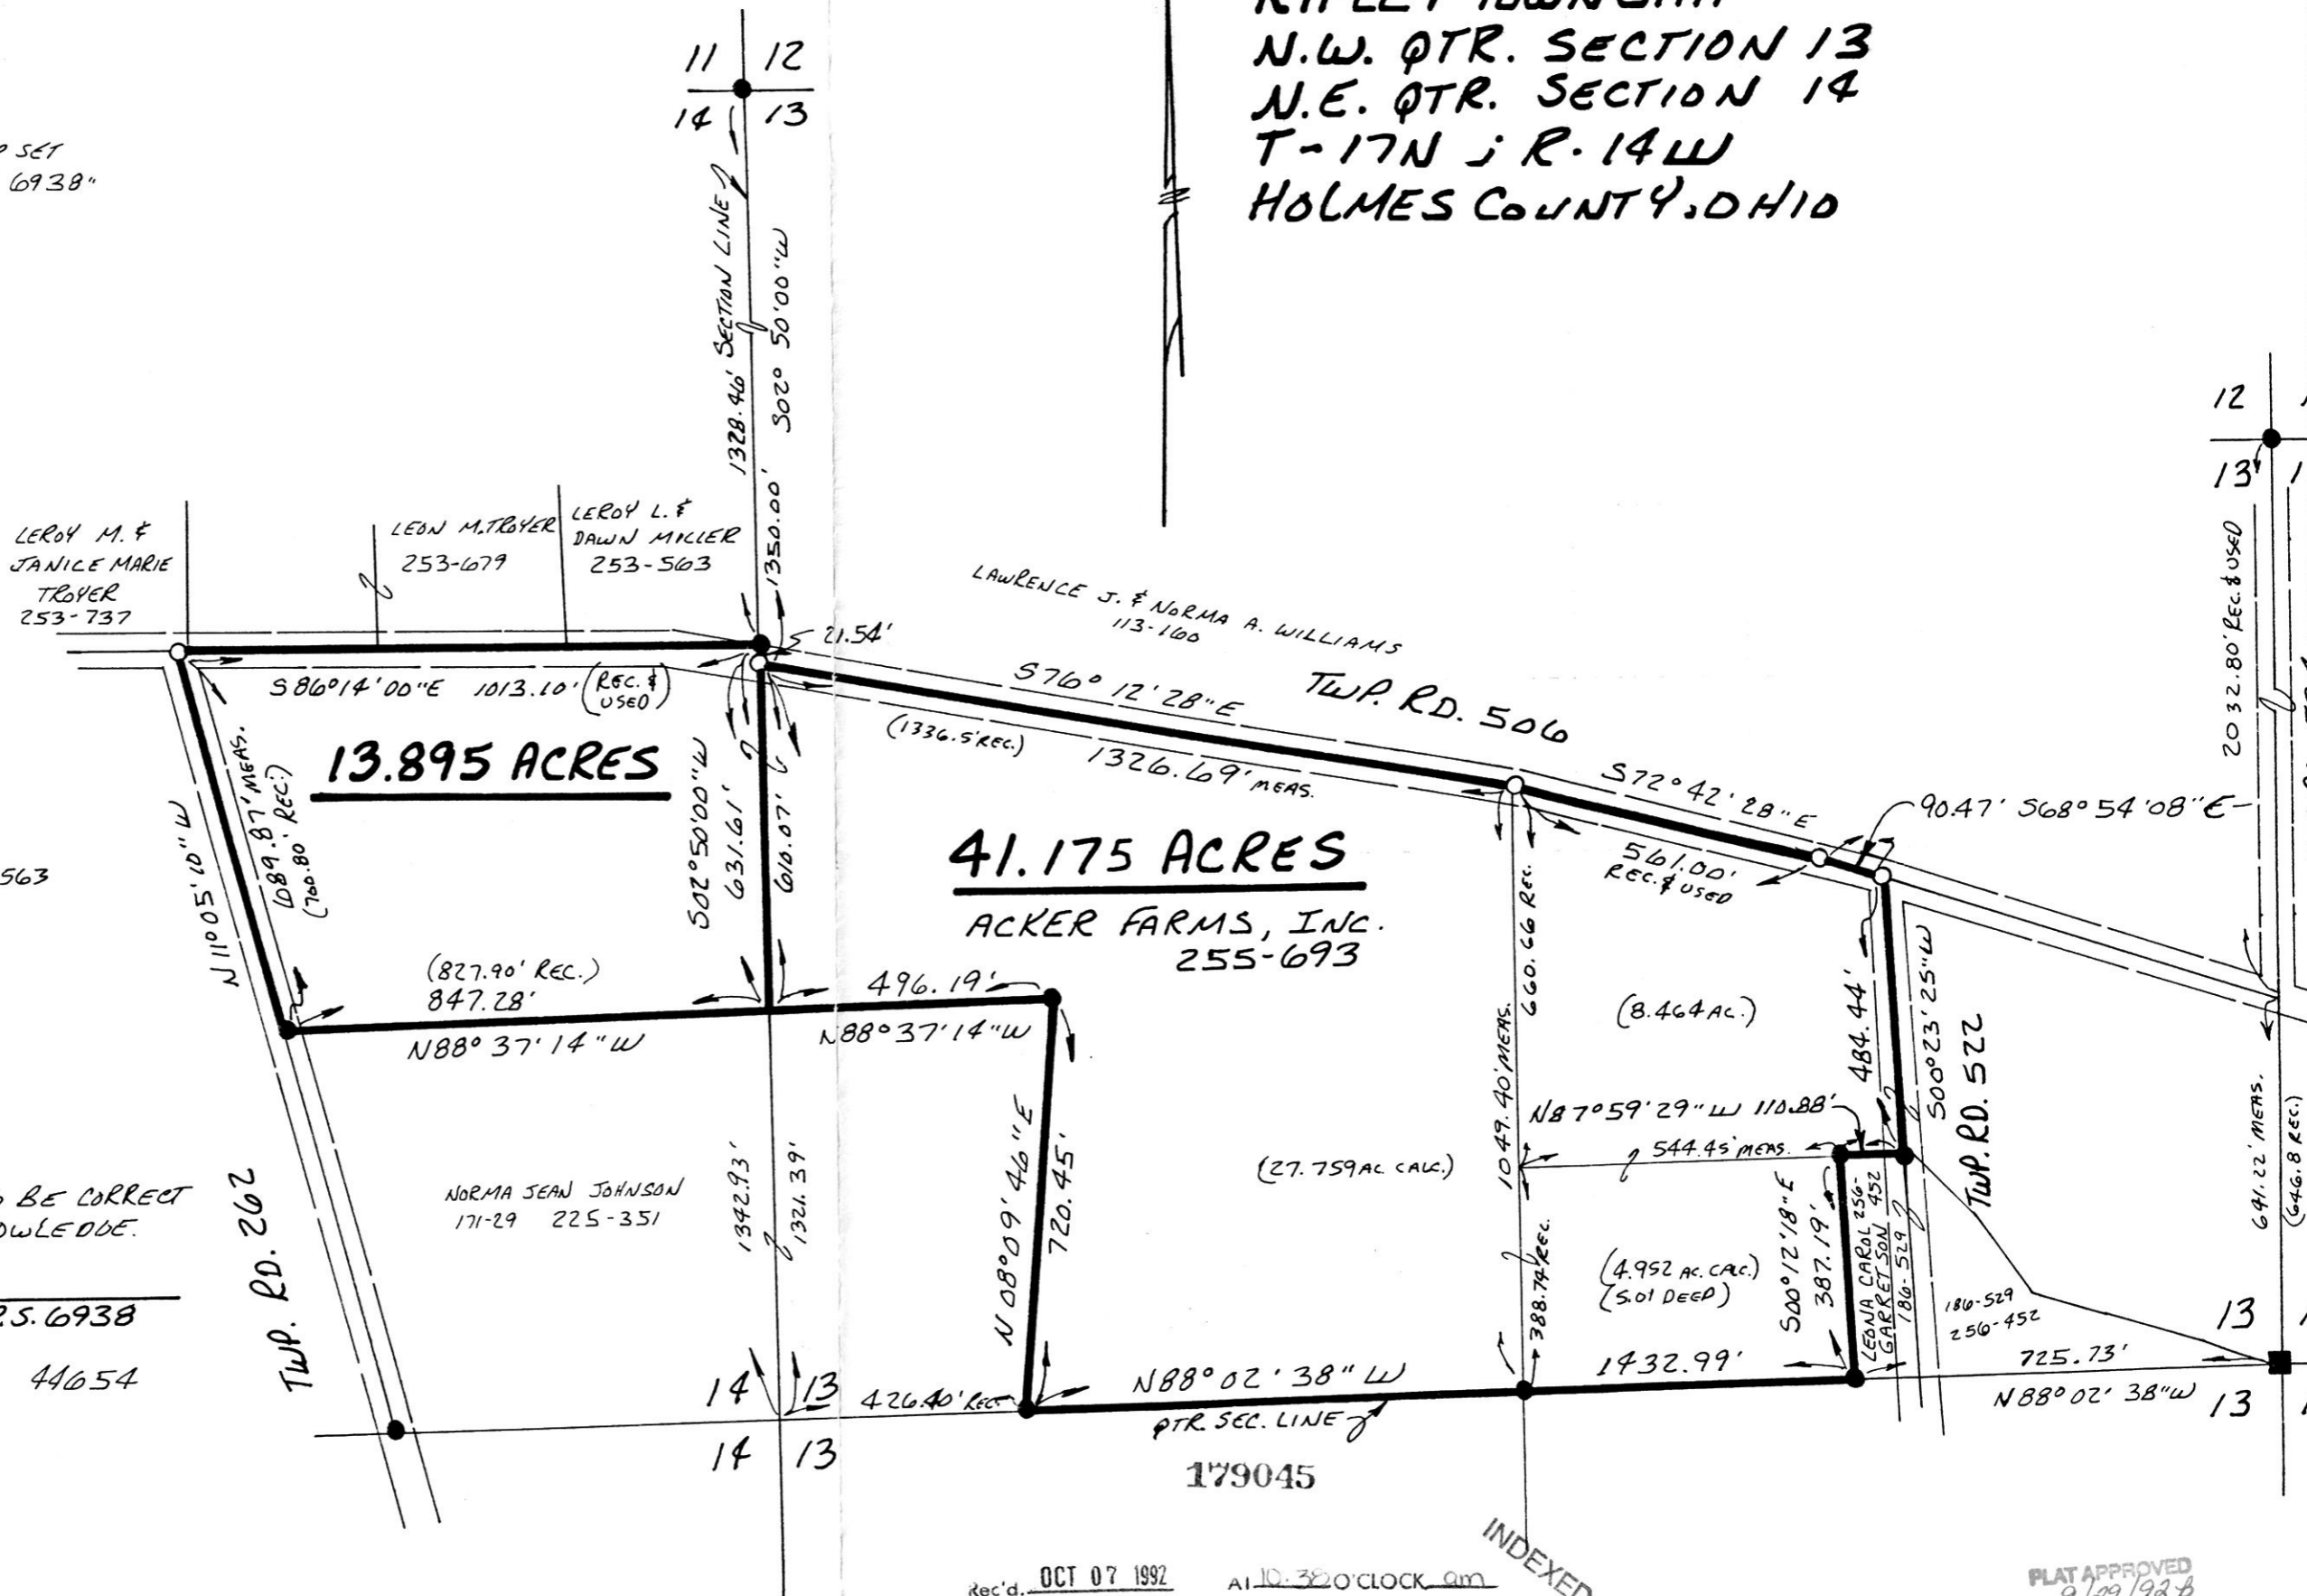

Rec'd. OCT 07 1992 At 10:32 O'CLOCK am  
 Recorded OCT 08 1992 Holmes Co. Ohio Fee 9.35  
 Plat Vol. 14 Pg. 53 Recorder Mary Ellen Signist  
 Deed vol 257 pg 446 Dan

INDEXED

PLAT APPROVED  
9/29/92 B