

WASHINGTON TOWNSHIP  
N.W. QTR. SECTION 35  
T-20N; R-15W  
HOLMES COUNTY, OHIO




SCALE: 1"=200'

- ▲ R.R. SPIKE FOUND
- IRON PIN FOUND
- △ R.R. SPIKE SET
- 5/8" RE BAR WITH I.D. CAP SET
- I.D. CAP MARKED "BAKER 6938"

REFERENCES:

- PLAT VOL. 7 PAGE 61
- PLAT VOL. 12 PAGE 139
- DEED VOL. 184 PAGE 303
- DEED VOL. 226 PAGE 986
- BEARINGS FROM PLAT VOL. 7 PAGE 61

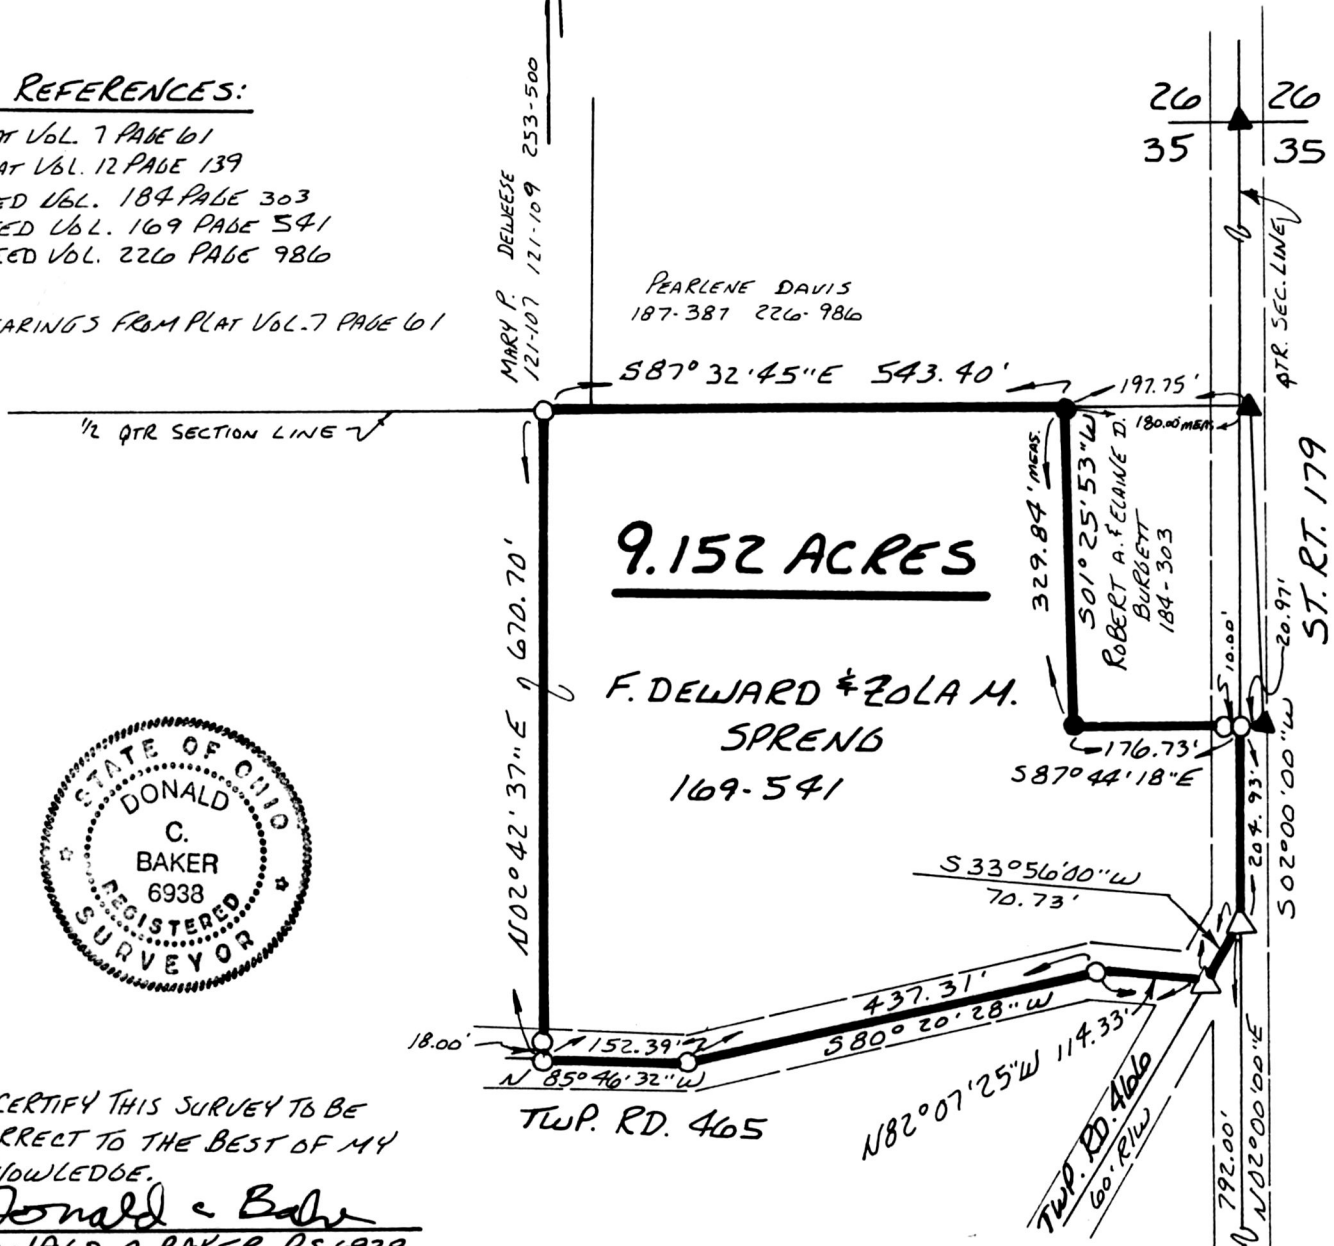

I CERTIFY THIS SURVEY TO BE CORRECT TO THE BEST OF MY KNOWLEDGE.

*Donald C. Baker*  
 DONALD C. BAKER P.S. 6938  
 5958 T.R. 322  
 MILLERSBURG, OHIO 44654  
 PH. (216) 674-4788

SEPT. 28, 1992  
REVISED OCT. 5, 1992

42592-MLS

NOV 04 1992  
 Rec'd. \_\_\_\_\_  
 Recorded NOV 05 1992

Plat Vol. 14  
 Deed vol 257 pg 787

AT 1:34 O'CLOCK PM  
 Holmes Co. Ohio Fee: \$5.00

Pg. 75 Recorder *Mary Ellen Siefert*  
 John S

179434 INDEXED

20 20  
35 35


PLAT INDEXED  
11-2-92 hz