
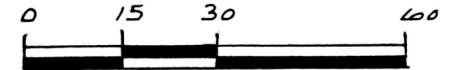


LAKE BUCKHORN LOT 228

MECHANIC TOWNSHIP
N.E. QTR. SECTION 20
T-8N; R-7W
HOLMES COUNTY, OHIO

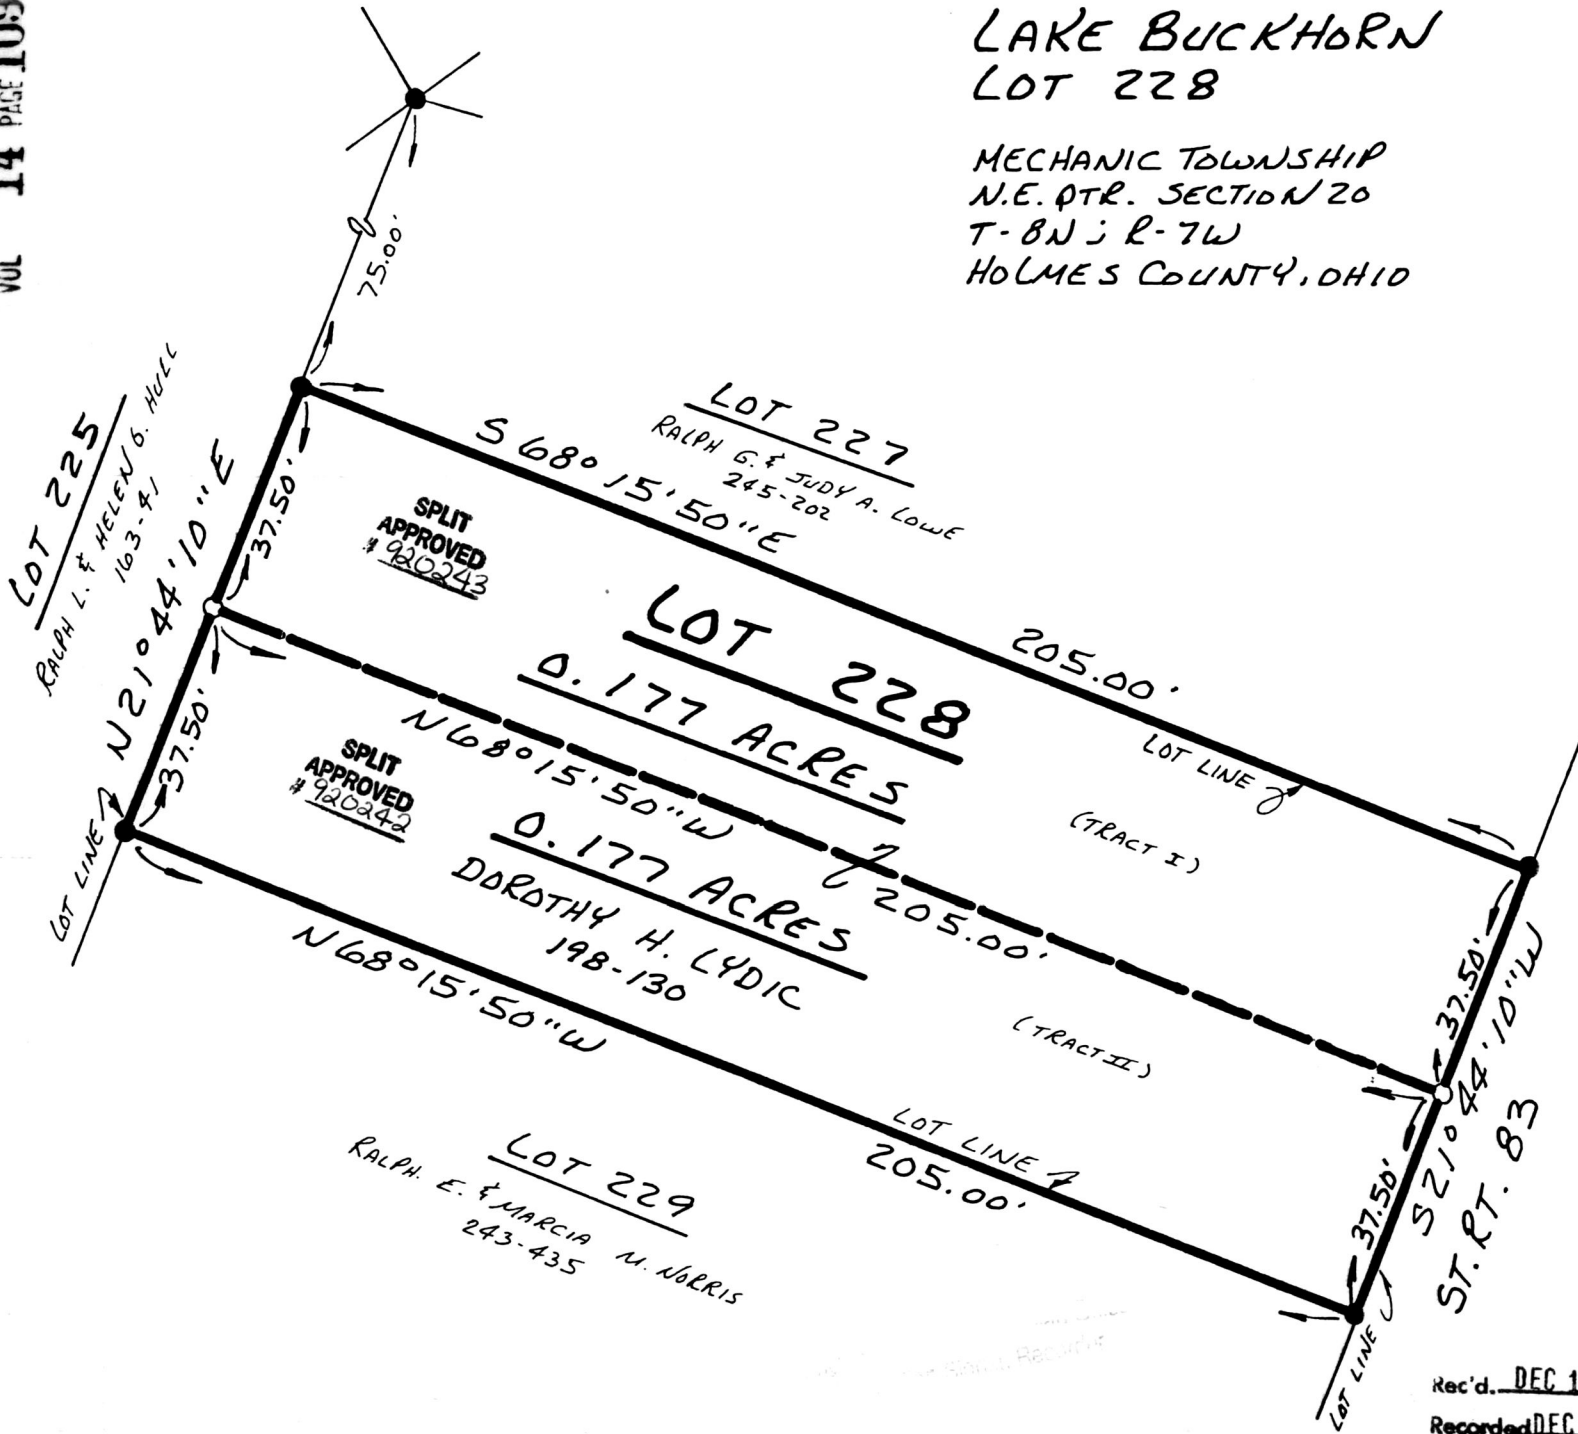

SCALE: 1" = 30'

- IRON PIN FOUND
- 5/8" RE BAR WITH I.D. CAP SET
I.D. CAP MARKED "BAKER 6938"

REFERENCES:

- DEED VOL. 243 PAGE 435
- DEED VOL. 198 PAGE 130
- DEED VOL. 245 PAGE 202
- DEED VOL. 163 PAGE 41
- PLAT VOL. 2 PAGE 5-A



I CERTIFY THIS SURVEY TO BE CORRECT TO THE BEST OF MY KNOWLEDGE.

Donald C Baker
DONALD C. BAKER P.S. 6938
5958 T.R. 322
MILLERSBURG OHIO 44654
PH. (216) 674-4788

AUGUST 18, 1992

180008

Rec'd. DEC 17 1992 AT 5:50 O'CLOCK pm
Recorded DEC 18 1992 Holmes Co. Ohio Fee: 5.00
Plat Vol. 14 Pg. 109 Recorder Mary Ellen Signot
Deed Vol. 238 pgs 236 + 238 Dan

INDEXED

34592-MCS

PLAT APPROVED
12/17/92