


EVOL 14 PAGE 115

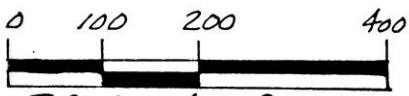

- ▲ R.R. SPIKE FOUND
- IRON PIN FOUND
- PK. NAIL SET
- △ R.R. SPIKE SET
- 5/8" REBAR WITH I.D. CAP SET
I.D. CAP MARKED "BAKER 6938"

BERLIN TOWNSHIP
3RD. QTR. LOT 33
T-9N; R-5W

4TH. QTR. LOT 21
T-9N; R-6W
HOLMES COUNTY, OHIO

REFERENCES:

- PLAT VOL. 3 PAGE 24
- PLAT VOL. 13 PAGE 154
- PLAT VOL. 12 PAGE 977
- DEED VOL. 224 PAGE 117
- DEED VOL. 246 PAGE 615
- DEED VOL. 219 PAGE 580
- DEED VOL. 256 PAGE 29
- DEED VOL. 256 PAGE 182
- DEED VOL. 255 PAGE 309
- BEARINGS FROM PLAT VOL. 12 PAGE 977

(A) DAN M. & LYDIA ANN FODER
166-554 224-117




I CERTIFY THIS SURVEY TO BE CORRECT
TO THE BEST OF MY KNOWLEDGE.

Donald C. Baker
DONALD C. BAKER P.S. 6938
5958 T.R. 322
MILLERSBURG, OHIO 44654
PH. (216) 674-4788

DECEMBER 16, 1992

54092-MLS

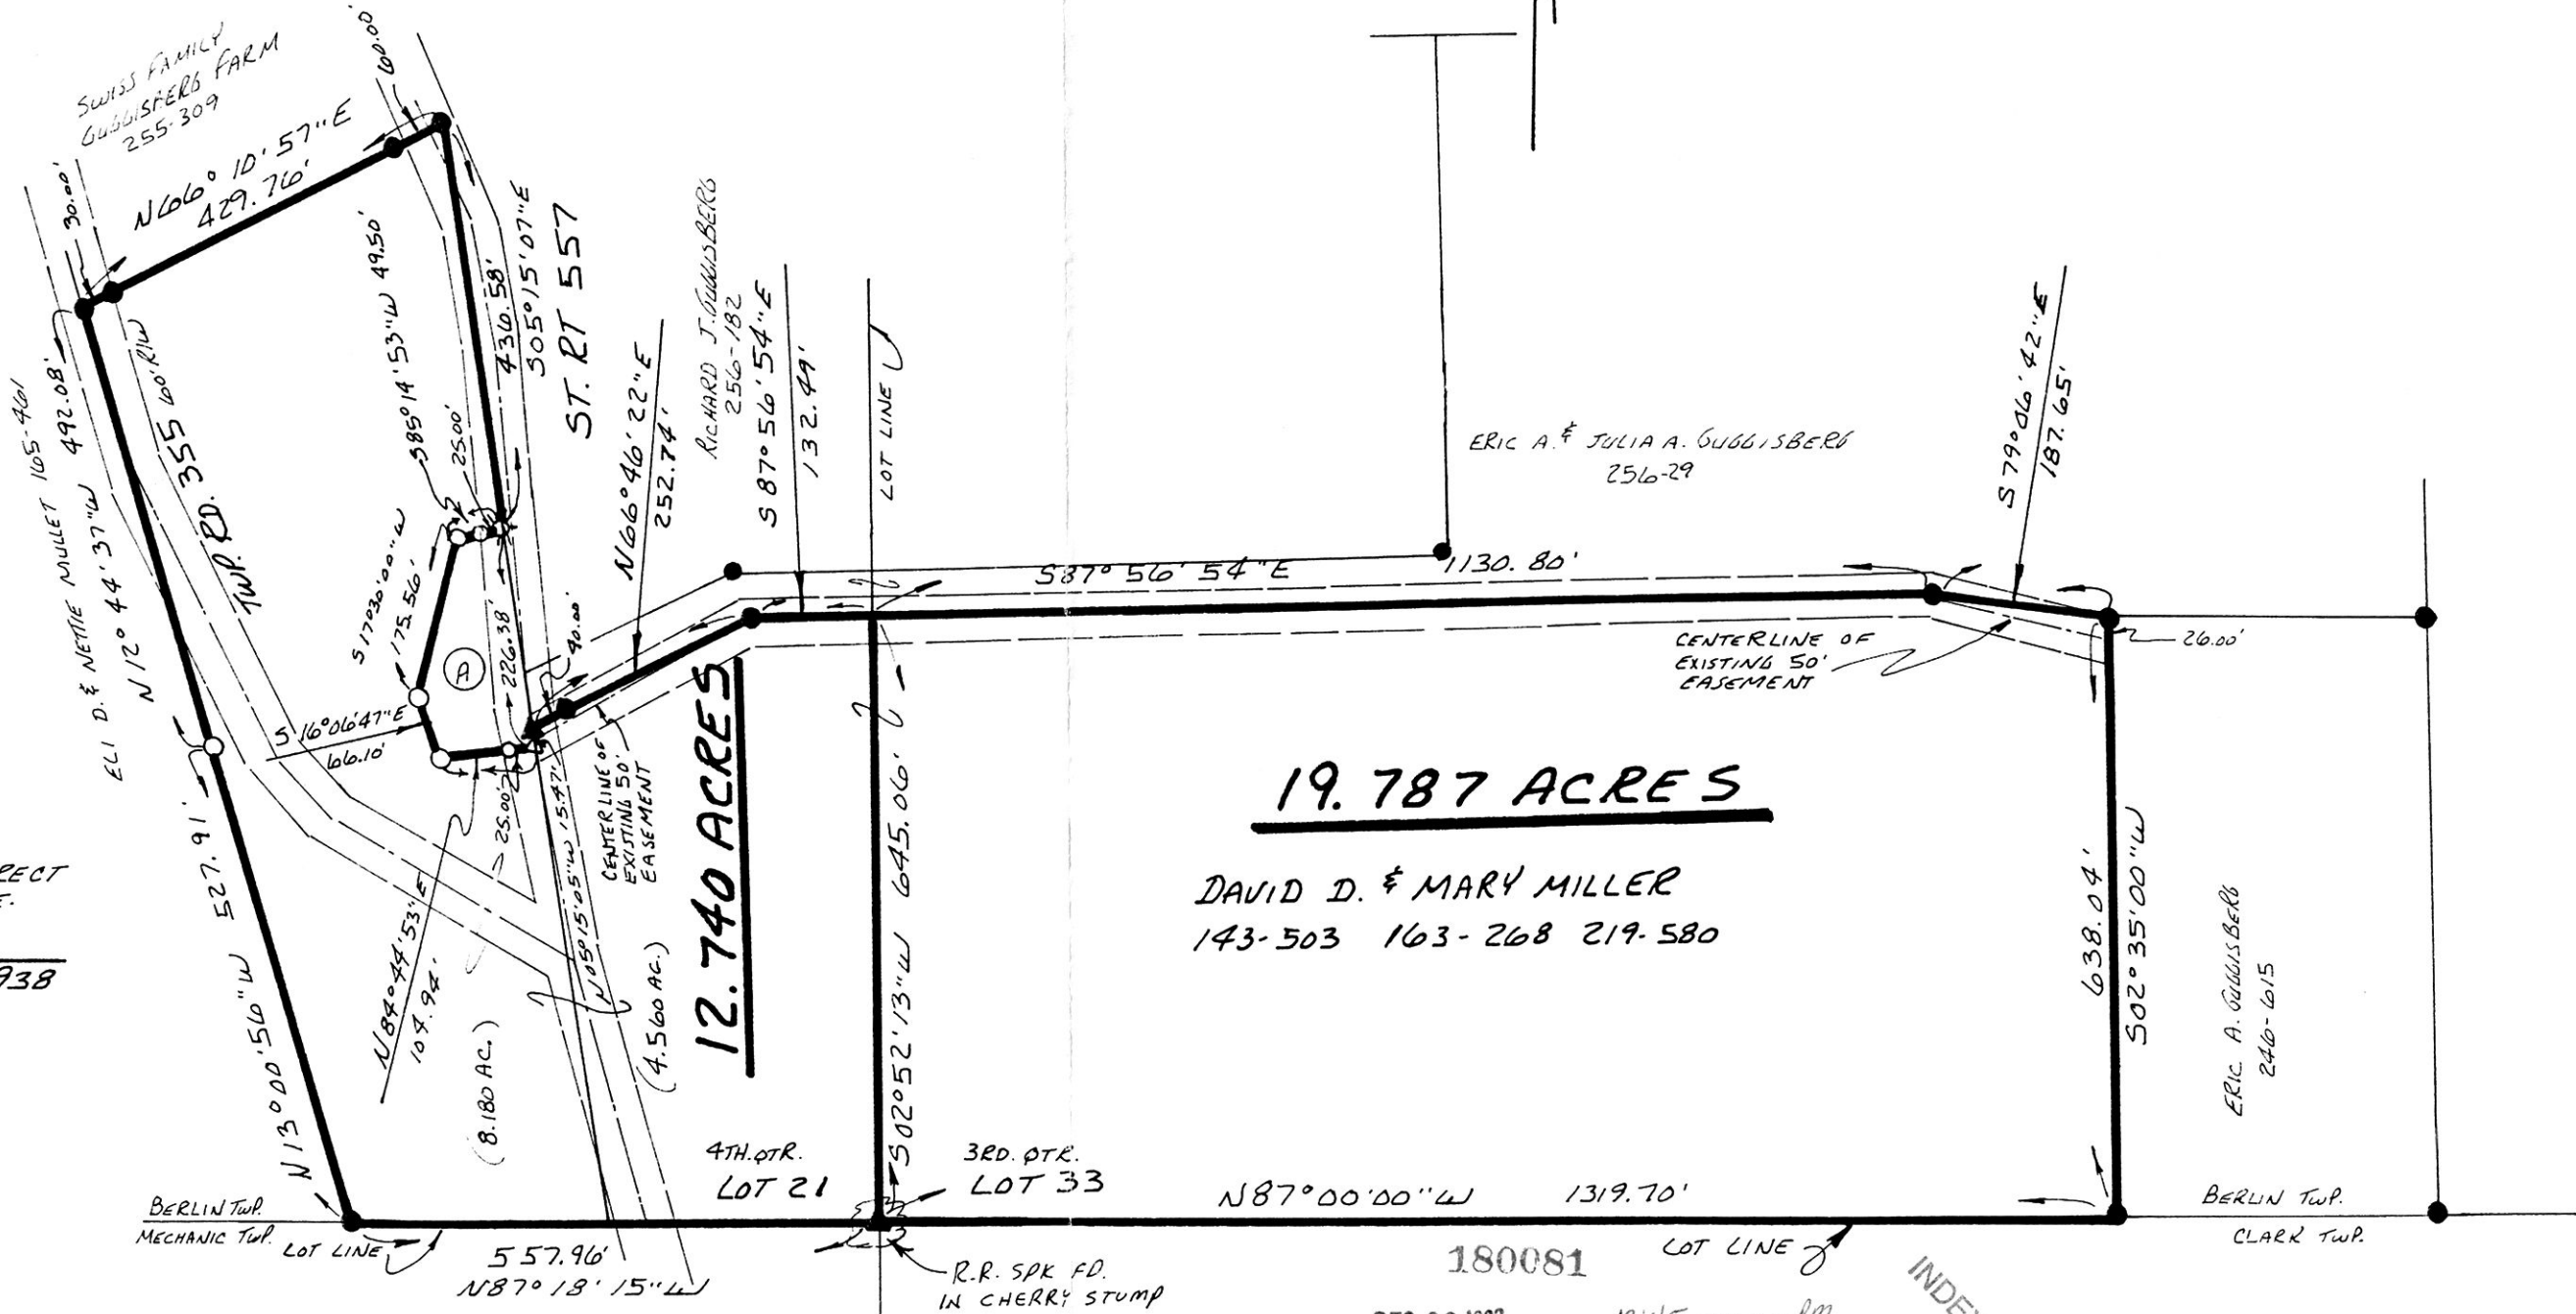

19.787 ACRES

DAVID D. & MARY MILLER
143-503 163-268 219-580

12.740 ACRES

REC'D. DEC 23 1992

Recorded DEC 24 1992

Plat Vol 14
Deed vol 258 pg 311

12:45 PM

Holmes Co. Ohio Fee: \$9.85

Pg 115 Recorder

INDEXED
Mary Ellen Sigrist
Recorder

PLAT APPROVED
12/22/92 b