


CLARK TOWNSHIP
N.W. & S.W. QTR. SEC. 6
T-8N R-4W
HOLMES COUNTY, OHIO

REFERENCES:

- PLAT VOL. B PAGE 709
- PLAT VOL. 12 PAGE 8
- PLAT VOL. 10 PAGE 637
- SURVEY RECORD 3 PAGE 161
- SURVEY RECORD 5 PAGE 55
- DEED VOL. 244 PAGE 202
- DEED VOL. 253 PAGE 949
- DEED VOL. 254 PAGE 893
- DEED VOL. 227 PAGE 932

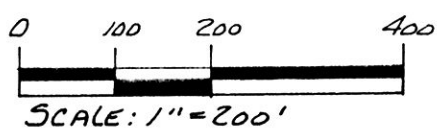


- ▲ R.R. SPIKE FOUND
- IRON PIN FOUND
- △ R.R. SPIKE SET
- 5/8" RE BAR WITH I.D. CAPSET
I.D. CAP MARKED "BAKER 6938"

BEARINGS FROM PLAT VOL. 12
PAGE 892

Recorded FEB 02 1993
Recorded FEB 03 1993
Deed Vol. 14 Pg. 143
Deed Vol. 258 pg. 794


AT 9/16 O'clock AM
Holmes Co. Ohio Fees: \$935
Recorder: Sally Shuman
Ayvalin

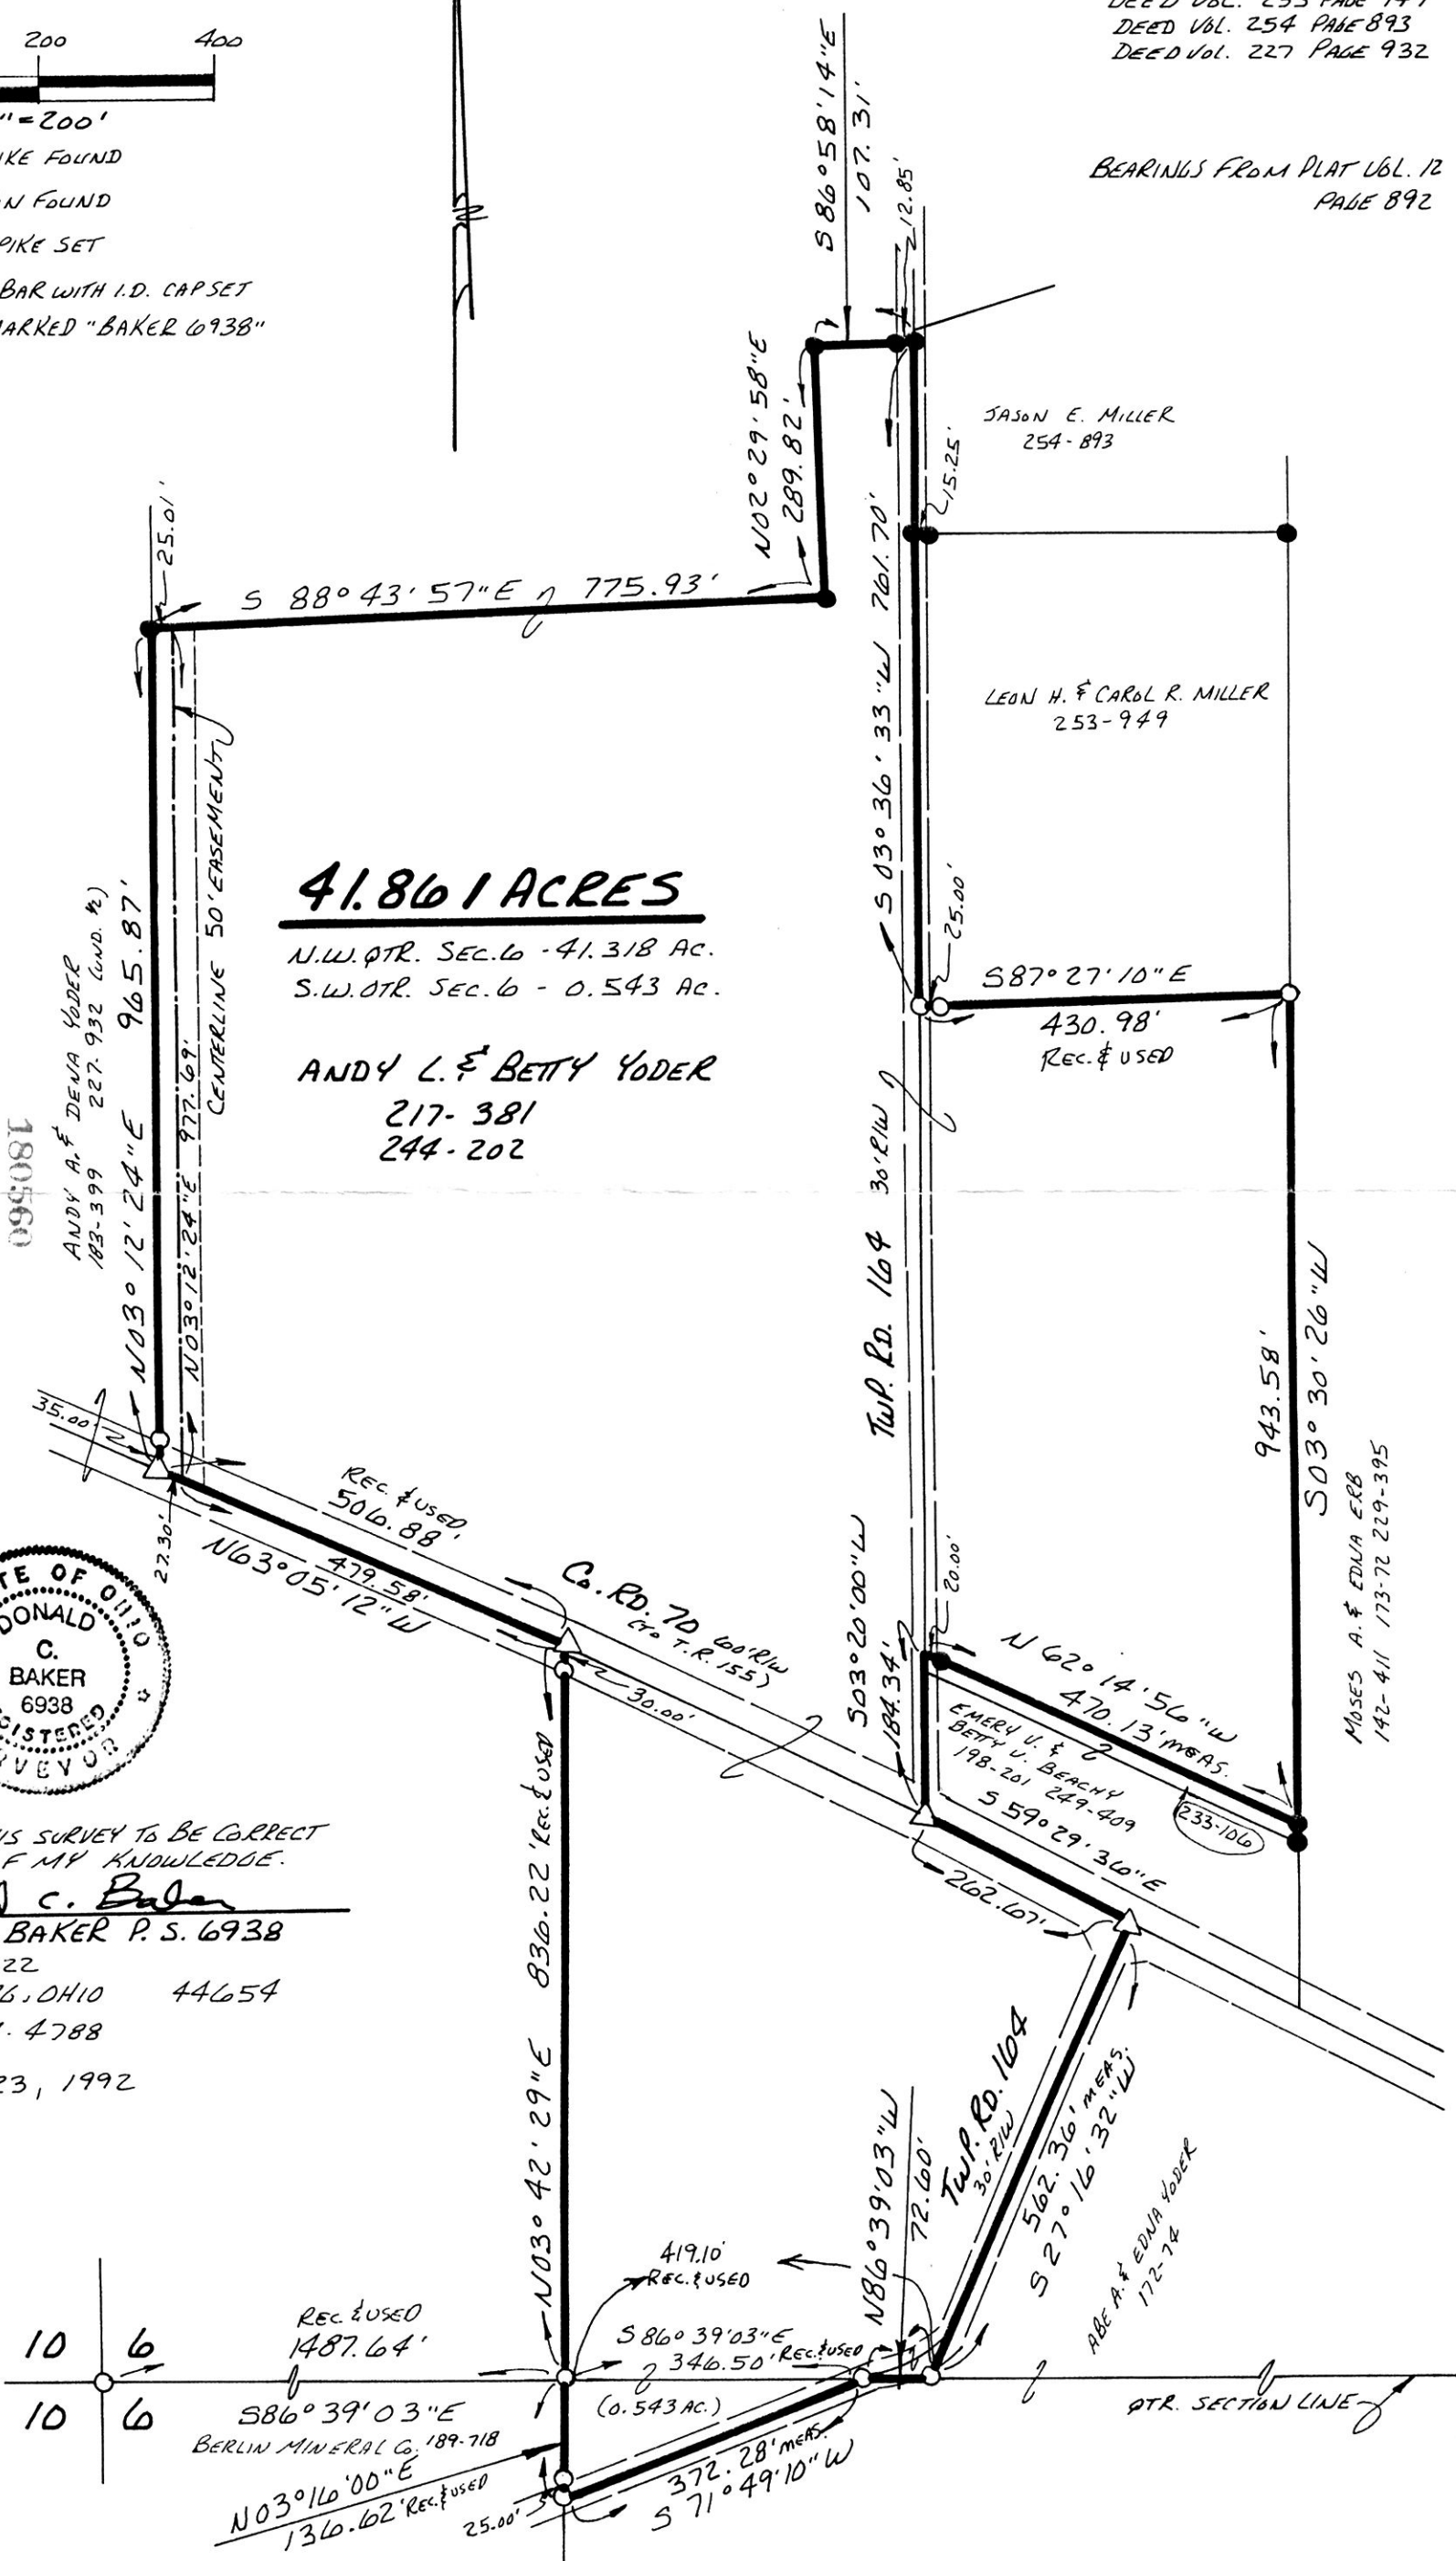

41.861 ACRES

N.W. QTR. SEC. 6 - 41.318 AC.
S.W. QTR. SEC. 6 - 0.543 AC.

ANDY L. & BETTY YODER
217-381
244-202

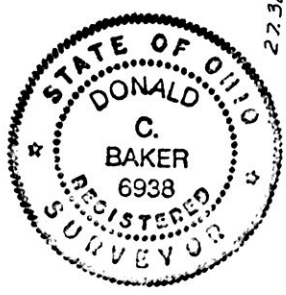


I CERTIFY THIS SURVEY TO BE CORRECT
TO THE BEST OF MY KNOWLEDGE.

Donald C. Baker
DONALD C. BAKER P.S. 6938
5958 T.R. 322
MILLERSBURG, OHIO 44654
PH. (216) 674-4788

DECEMBER 23, 1992

54392-MLS

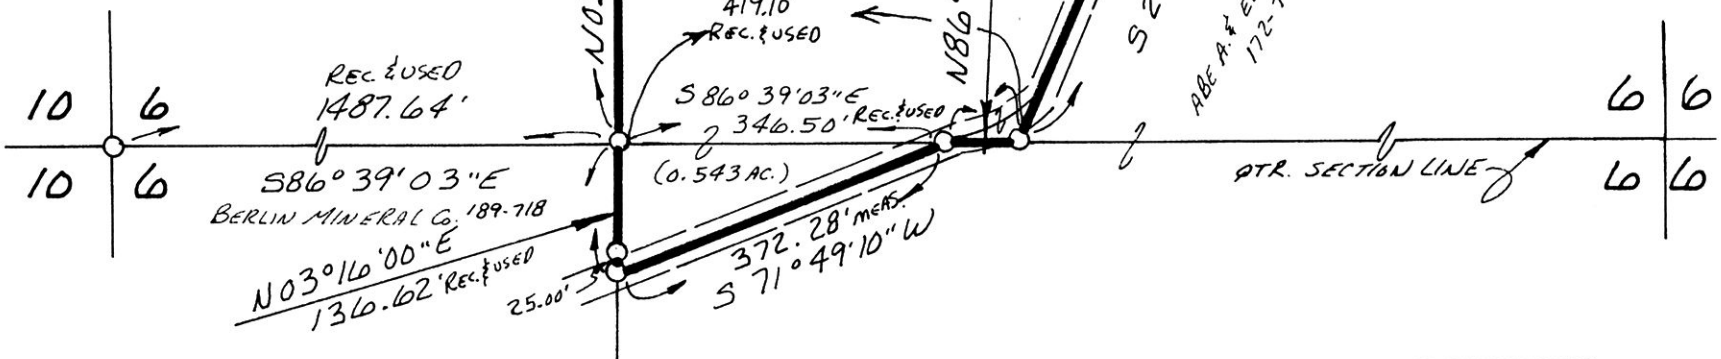

PLAT APPROVED
1-29-93 Rg

180560

6 6
6 6