


181624

MONROE TOWNSHIP
3RD. QTR. LOT 18
T-9N; R-8W
HOLMES COUNTY, OHIO

REFERENCES:

- PLAT VOL. 10 PAGE 63
- PLAT VOL. 9 PAGE 56
- PLAT VOL. 9 PAGE 77
- PLAT VOL. 10 PAGE 102
- PLAT VOL. 12 PAGE 206
- DEED VOL. 243 PAGE 155
- DEED VOL. 228 PAGE 527
- DEED VOL. 239 PAGE 91
- DEED VOL. 230 PAGE 166

Pg. 193

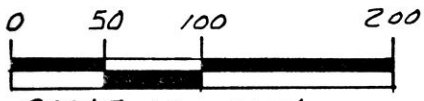

SCALE: 1" = 100'


- IRON PIN FOUND
- 5/8" RE BAR WITH I.D. CAP SET
- I.D. CAP MARKED "BAKER 6938"

This 6.770 acre parcel is not approved for any use that generates wastewater.

[Signature] 4/15/93
Sanitarian Date

NOTE:
IP FD 509°58'04"E 0.61'
FROM CORNER, AFTER
SURVEYING LOT LINE

MELVIN A. REINTHAL
208-263 239-91

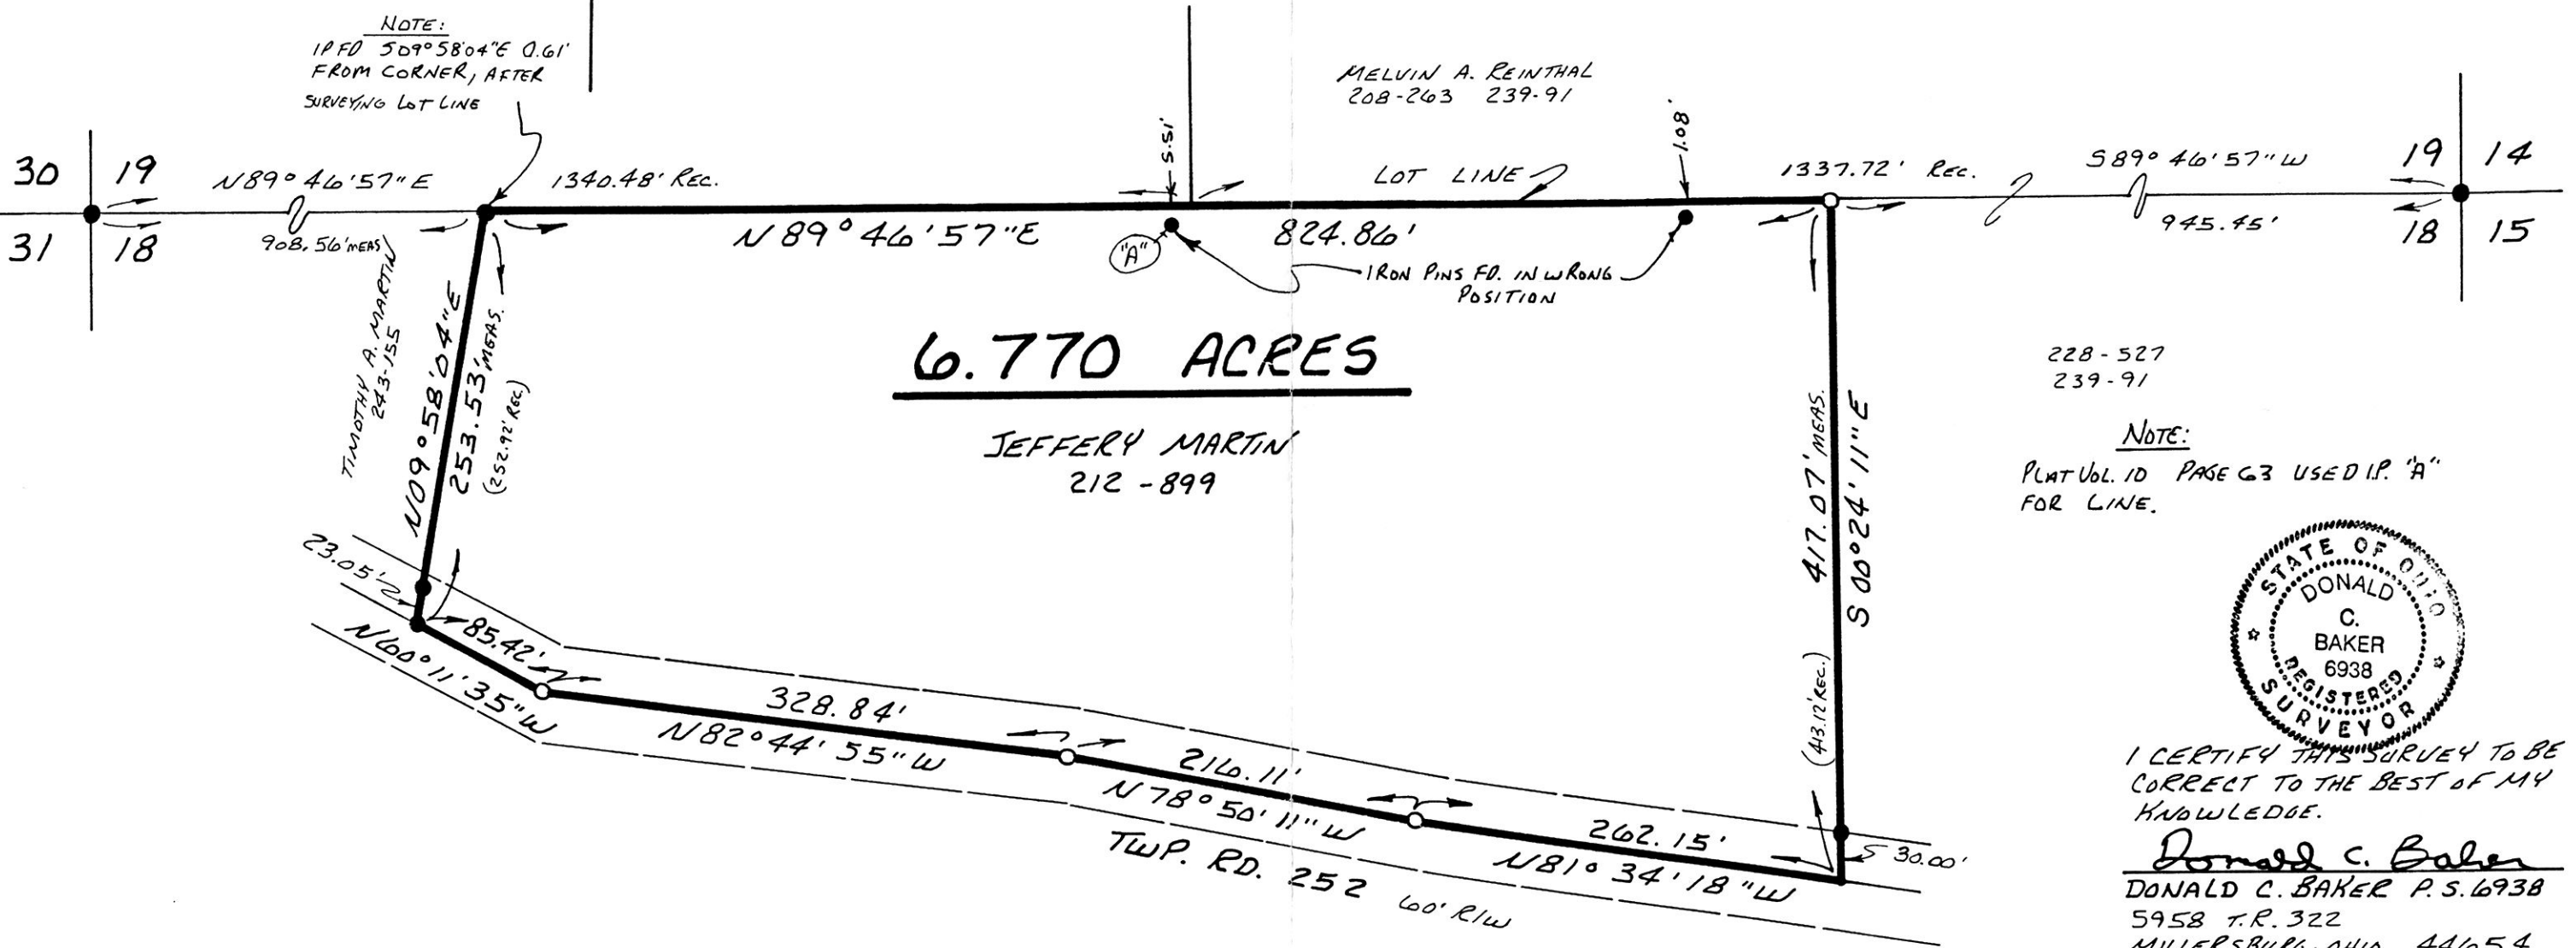

6.770 ACRES

JEFFERY MARTIN
212-899

228-527
239-91

NOTE:
PLAT VOL. 10 PAGE 63 USED I.P. 'A'
FOR LINE.



I CERTIFY THIS SURVEY TO BE
CORRECT TO THE BEST OF MY
KNOWLEDGE.

Donald C. Baker
DONALD C. BAKER P.S. 6938
5958 T.R. 322
MILLERSBURG, OHIO 44654
PH. (216) 674-4788

APRIL 6, 1993

181624

REC'D. APR 26 1993 AT 2:20 O'CLOCK PM
RECORDED APR 27 1993 Holmes Co. Ohio Fees \$9.35
Plat Vol. 14 Pg. 193 Recorder Sally Miller
Deed vol. 259 pg. 663 *[Signature]*

INDEXED

15193-MLS

PLAT APPROVED
4/23/93 *[Signature]*