



PAINT TOWNSHIP
4TH QTR. LOTS 17, 18 & 27
T-10N3 R-5W
HOLMES COUNTY, OHIO

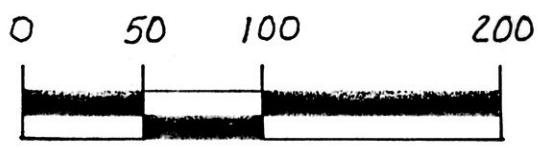

SCALE: 1" = 100'

- IRON PIN FOUND
- 5/8" REBAR WITH I.D. CAP SET
I.D. CAP MARKED "BAKER 6938"

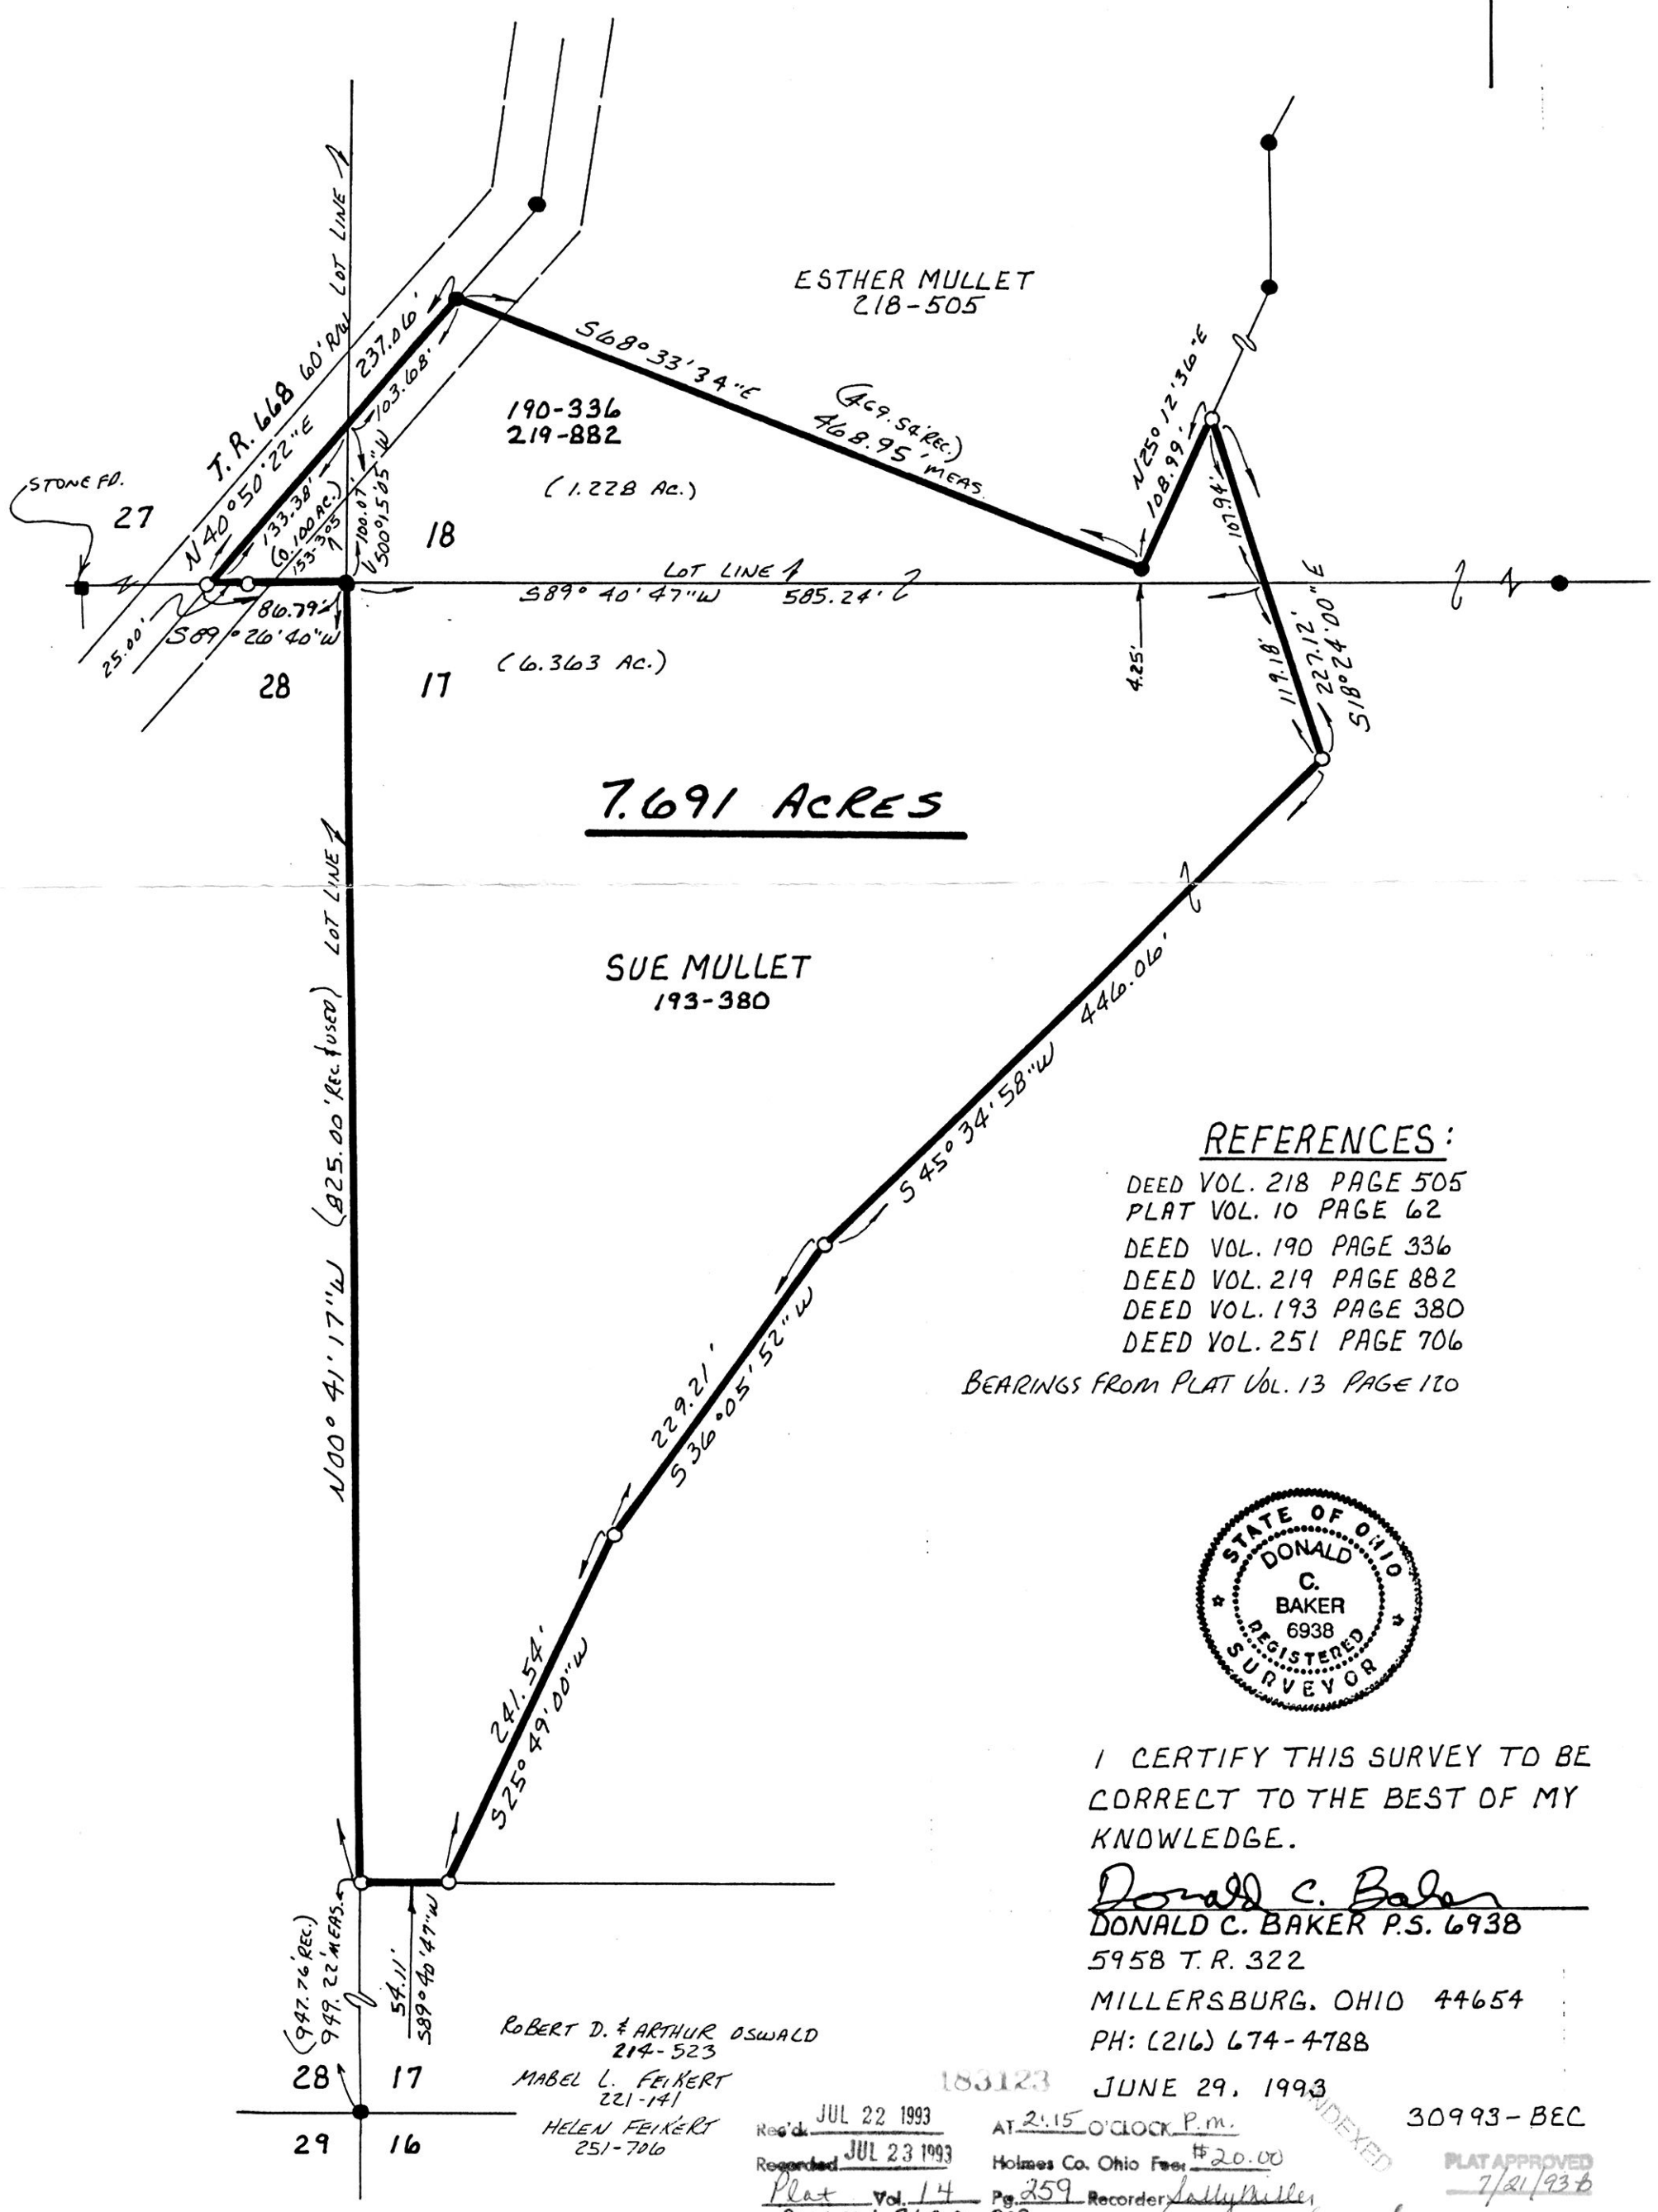

7.691 ACRES

REFERENCES:

- DEED VOL. 218 PAGE 505
- PLAT VOL. 10 PAGE 62
- DEED VOL. 190 PAGE 336
- DEED VOL. 219 PAGE 882
- DEED VOL. 193 PAGE 380
- DEED VOL. 251 PAGE 706




I CERTIFY THIS SURVEY TO BE CORRECT TO THE BEST OF MY KNOWLEDGE.

Donald C. Baker
 DONALD C. BAKER P.S. 6938
 5958 T.R. 322
 MILLERSBURG, OHIO 44654
 PH: (216) 674-4788

183123

JUNE 29, 1993

30993-BEC

Reg'd JUL 22 1993

AT 2:15 O'CLOCK P.M.

Recorded JUL 23 1993

Holmes Co. Ohio Fees \$20.00

Plat Vol. 14 Pg. 259

Recorder Jody Miller

PLAT APPROVED 7/21/93