


VOL 14 PAGE 362

WALNUT CREEK TOWNSHIP
S.E. QTR. SECTION 23
T-9N j R-5W
HOLMES COUNTY, OHIO

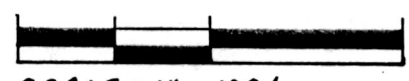

0 50 100 200




SCALE: 1" = 100'

REFERENCES:

- DEED VOL. 173 PAGE 431
- DEED VOL. 221 PAGE 485
- DEED VOL. 227 PAGE 331
- DEED VOL. 134 PAGE 27
- DEED VOL. 227 PAGE 333
- PLAT VOL. 10 PAGE 412

BEARINGS FROM PLAT VOL. 13 PAGE 149

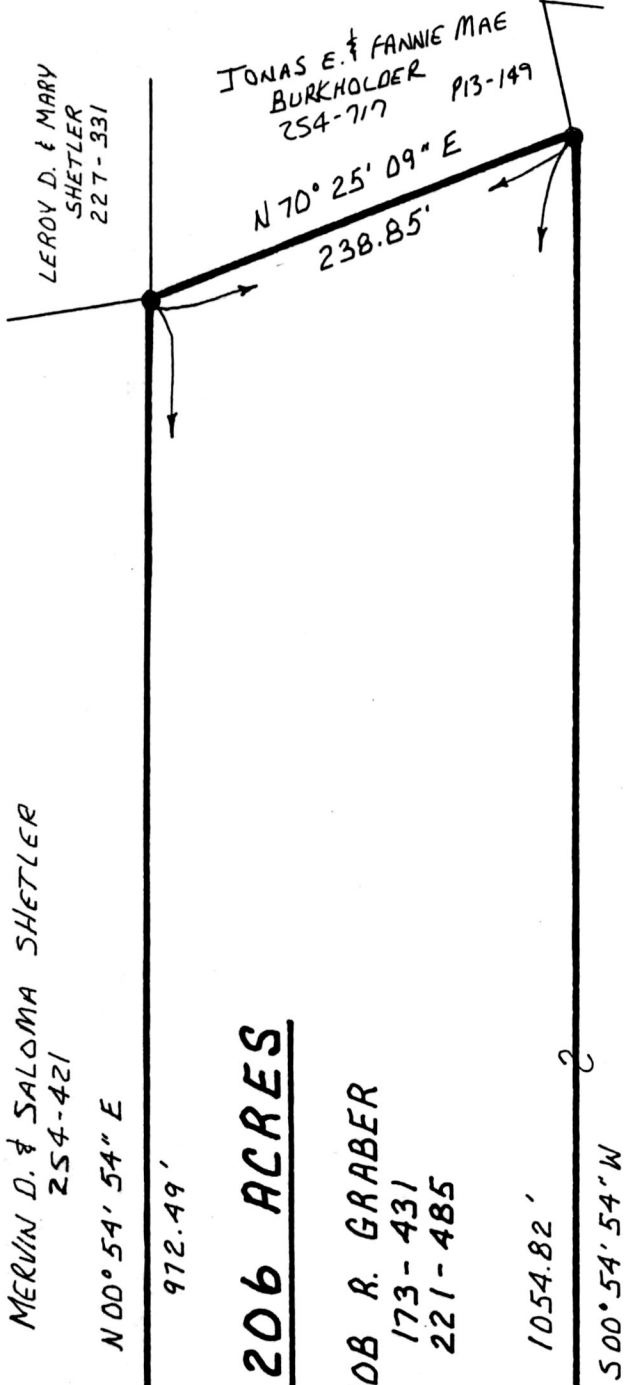


I CERTIFY THIS SURVEY TO BE CORRECT TO THE BEST OF MY KNOWLEDGE.

Donald C. Baker
 DONALD C. BAKER P.S. 6938
 5958 T.R. 322
 MILLERSBURG, OHIO 44654
 PH: (216) 674-4788
 OCTOBER 18, 1993

184786

INDEXED

Rec'd NOV 12 1993 AT 9:26 O'CLOCK A.M.
 Registered NOV 15 1993 Holmes Co. Ohio Fee \$20.00
 Plat No. 14 Pgs 362 Recorder Sally Miller S.S.
 Deed vol. 262 pg 280

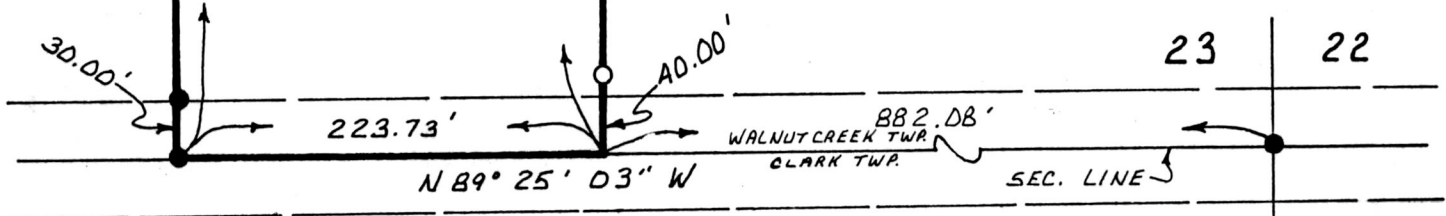

TWP. RD. 157

55493-BEC

PLAT APPROVED
11/10/93-b