
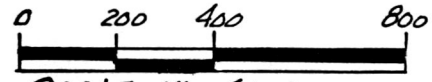


(RESURVEY OF A 5.0 ACRE PARCEL, 34.0 ACRE PARCEL & 40.0 ACRE PARCEL)  
AS DESCRIBED IN DEED VOL. 262 PG. 534

MONROE TOWNSHIP  
EAST HALF OF FRACTIONAL  
SECTION 20; T-17N; R-14W  
HOLMES COUNTY, OHIO

VOL 14 PAGE 414

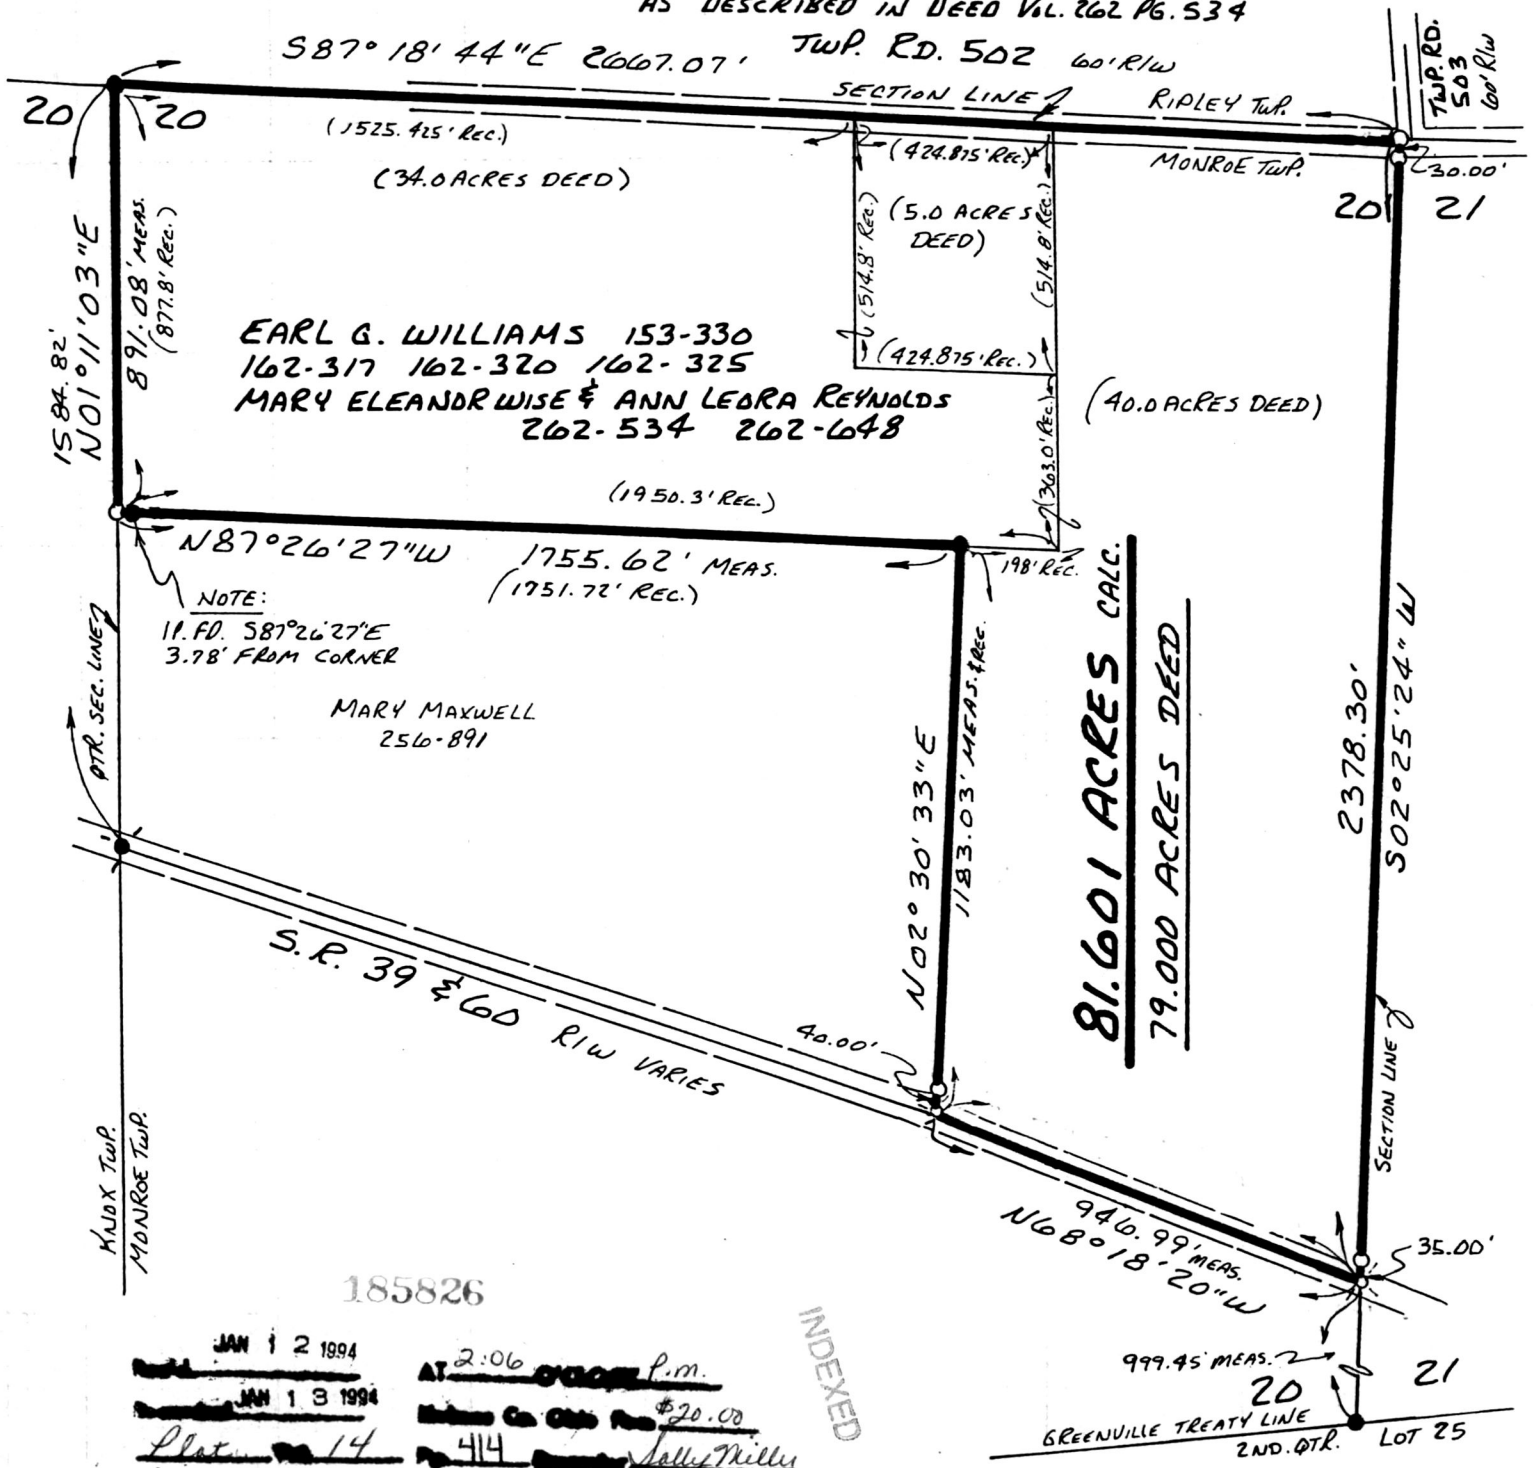

- SCALE: 1" = 400'
- BOAT SPIKE FOUND
  - IRON PIN FOUND
  - 5/8" RE BAR WITH I.D. CAP SET
  - I.D. CAP MARKED "BAKER 6938"
  - P.K. NAIL SET

REFERENCES:  
 DEED VOL. 262 PAGE 648  
 DEED VOL. 262 PAGE 534  
 DEED VOL. 250 PAGE 891  
 DEED VOL. 162 PAGE 325  
 PLAT VOL. 7 PAGE 805  
 BEARINGS FROM PLAT VOL. 8 PG. 27



I CERTIFY THIS SURVEY TO BE CORRECT TO THE BEST OF MY KNOWLEDGE.  
 Donald C Baker  
 DONALD C. BAKER P.S. 6938  
 5958 T.R. 322  
 MILLERSBURG, OHIO 44654  
 PH. (216) 274-4788  
 JANUARY 6, 1994

694-MLS

185826

JAN 12 1994  
 AT 2:06 P.M.  
 JAN 13 1994  
 INDEXED  
 Plat 14  
 Deed vol. 263 pg 116

GREENVILLE TREATY LINE  
2ND. QTR. LOT 25

PLAT APPROVED  
1/11/94 B