

RICHLAND TOWNSHIP
S.W. QTR. SECTION 13
T-8N; R-9W
HOLMES COUNTY, OHIO

0 150 300 600

SCALE: 1" = 300'

- ▲ R.R. SPIKE FOUND
- P.K. NAIL FOUND
- IRON PIN FOUND
- △ R.R. SPIKE SET
- 5/8" RE BAR WITH I.D. CAP SET
- I.D. CAP MARKED "BAKER 6938"

REFERENCES:

- DEED VOL. 225 PAGE 415
- DEED VOL. 251 PAGE 299
- PLAT VOL. 12 PAGE 544
- PLAT VOL. 10 PAGE 245

BEARINGS FROM DEED VOL. 251 PAGE 299

187405

REC'D
AT 2:58 o'clock P.m.

RECORDED
FEE \$20.00

APR 29 '94

MAY 02 '94

INDEXED

Plat.
VOL 14 PAGE 499
Deed vol. 264 pg 272-274

I CERTIFY THIS SURVEY TO BE CORRECT
TO THE BEST OF MY KNOWLEDGE.

Donald C. Baker
DONALD C. BAKER P.S. 6938
5958 T.R. 322
MILLERSBURG, OHIO 44654
PH. (216) 074-4788

APRIL 13, 1994

18594-MLS




NOTE:
R.R. SPIKE FOUND
N06°17'40"E 8.02'
OF CORNER

EXISTING 50' EAS.
RECORDED IN PLAT
VOL. 10 PAGE 795

6" DIA X 5" HIGH
CONC. POST
SEE PLAT VOL. 10 PAGE 795

NOTE:
I HELD THIS CONC. POST
AS SHOWN ON PLAT VOL. 10
PAGE 795 & ORIGINALLY
SURVEYED IN S.R. 3 PAGE 63.
THIS CORNER FITS THE
LINE OF OCCUPATION.

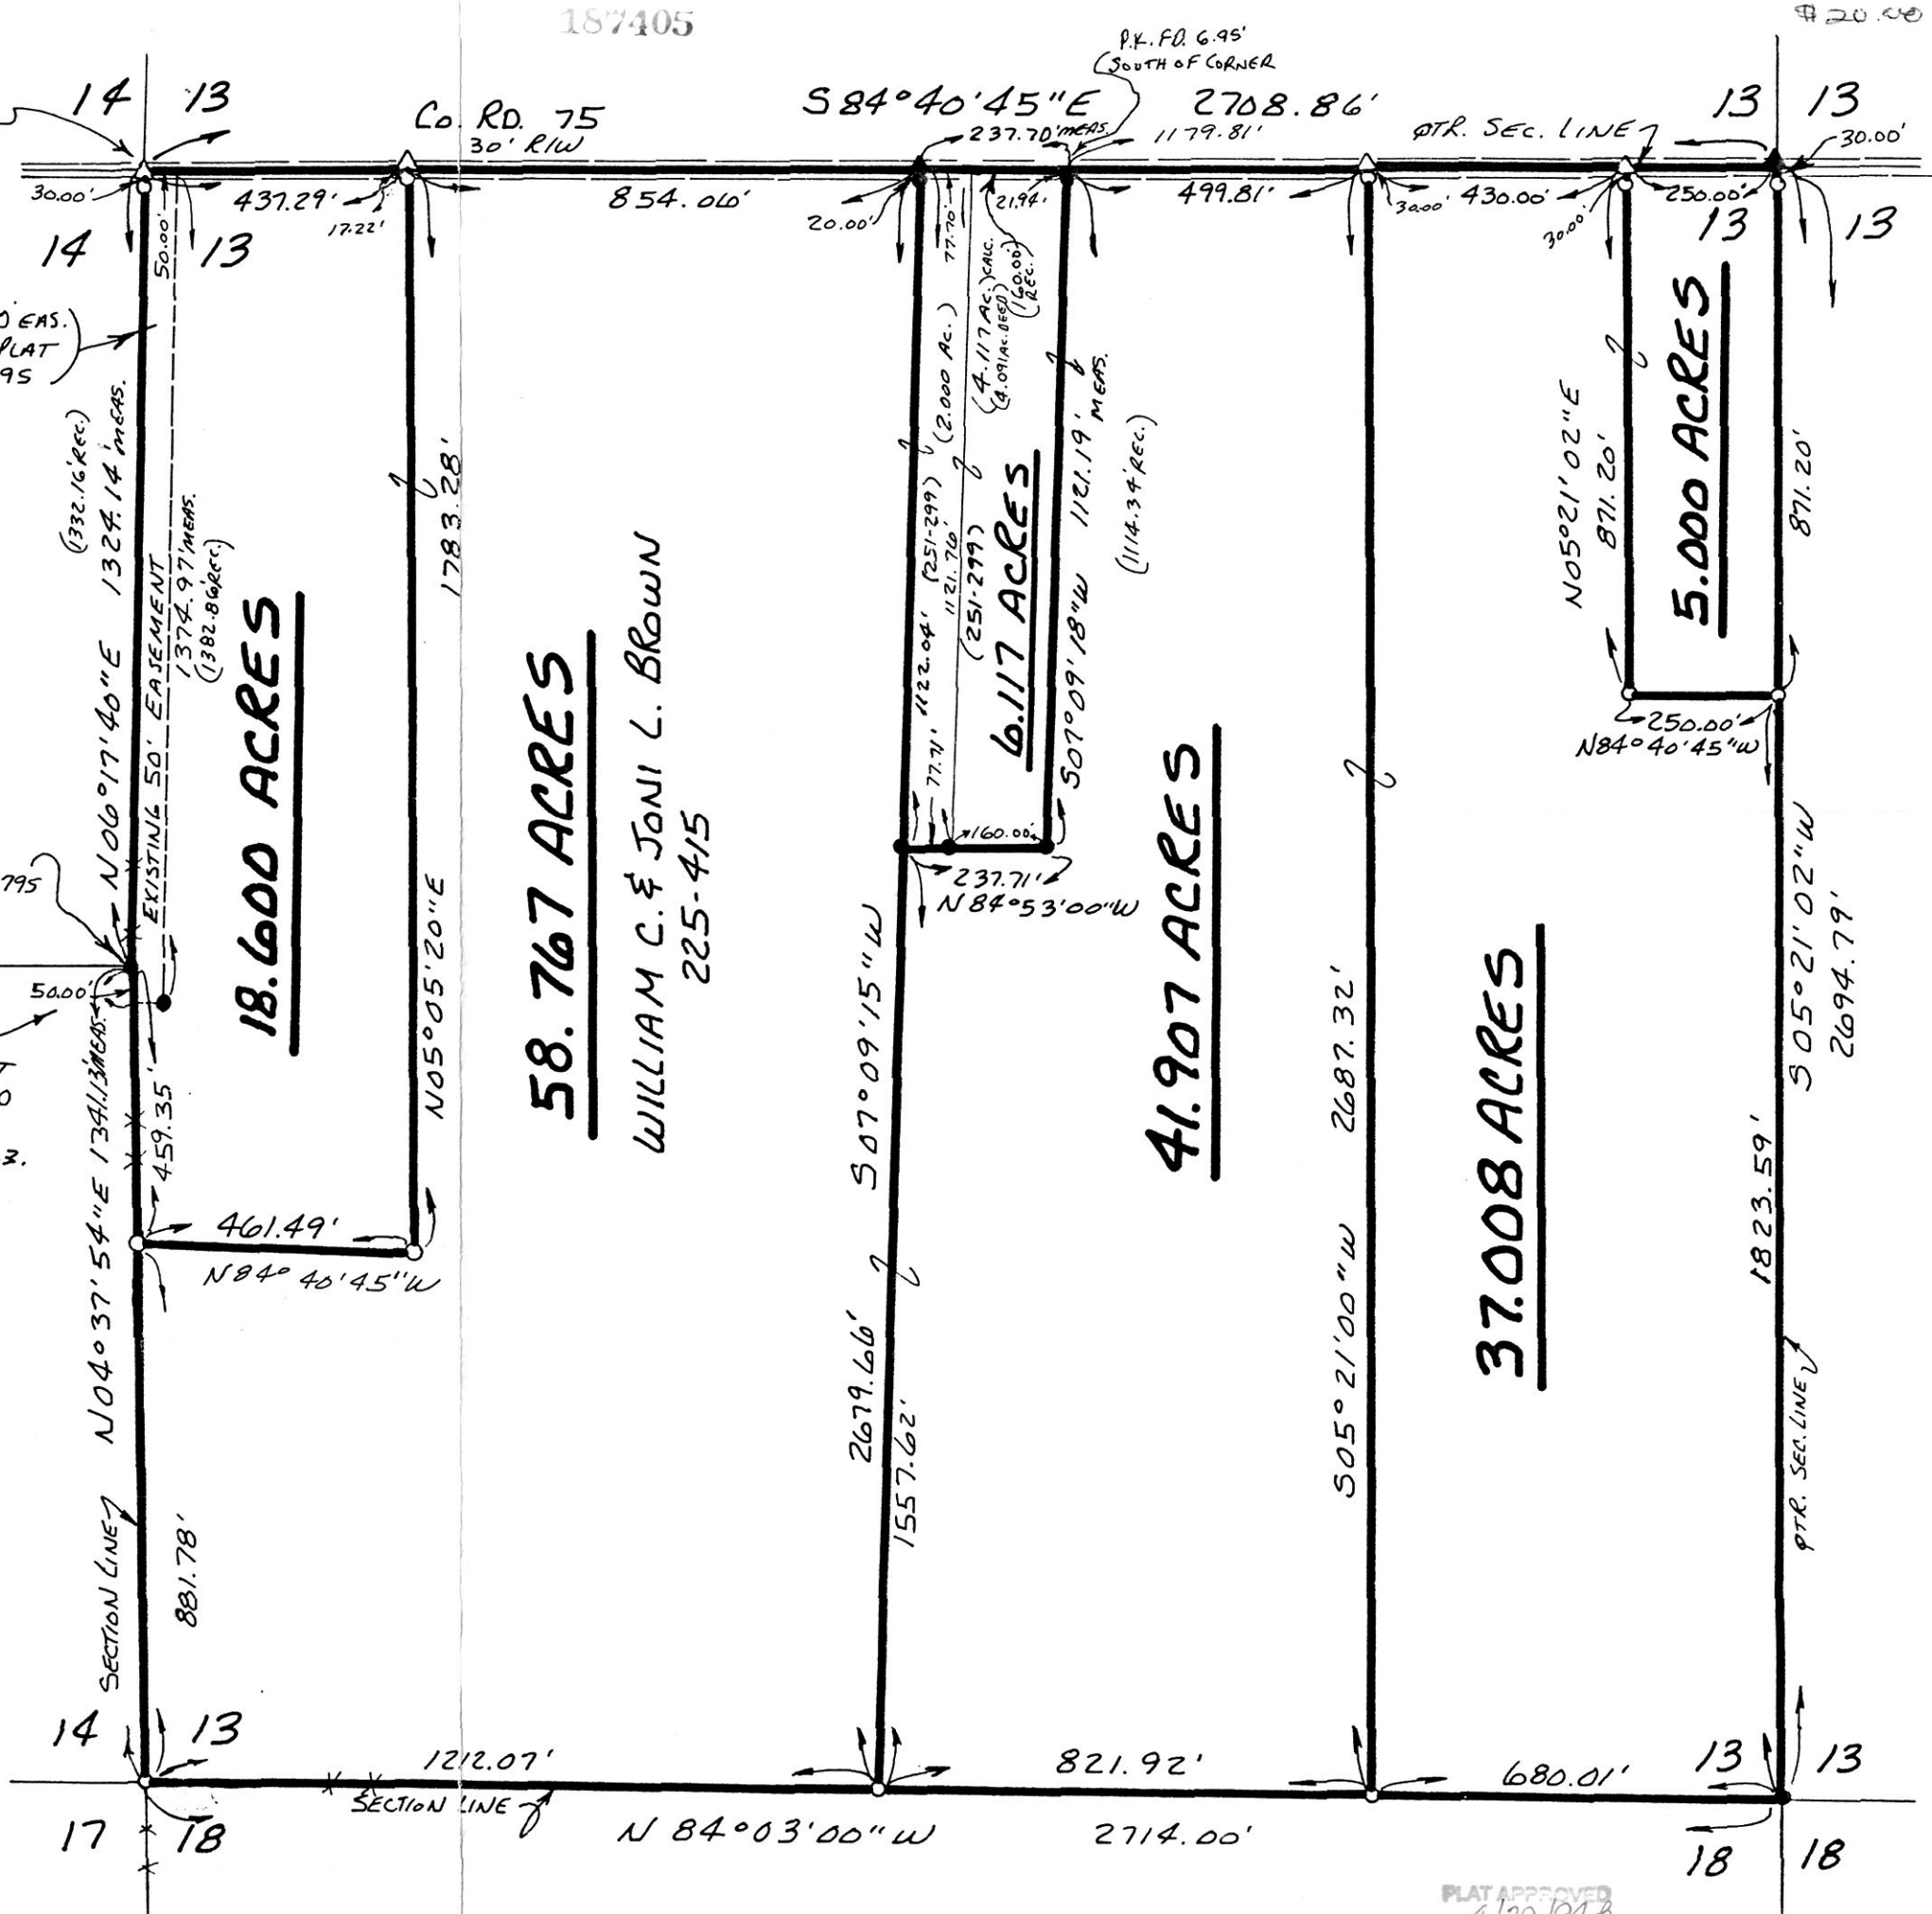

PLAT APPROVED
4/29/94B