



WALNUTCREEK TOWNSHIP  
1ST. QTR. LOT 14  
T-9N ; R-5W  
HOLMES COUNTY, OHIO

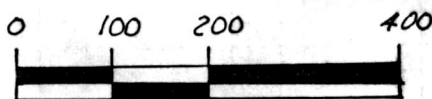

SCALE: 1" = 200'

- STONE FOUND.
- △ R. R. SPIKE SET.
- 5/8" REBAR WITH I.D. CAP SET.  
I.D. CAP MARKED "BAKER 6938."
- IRON PIN FOUND

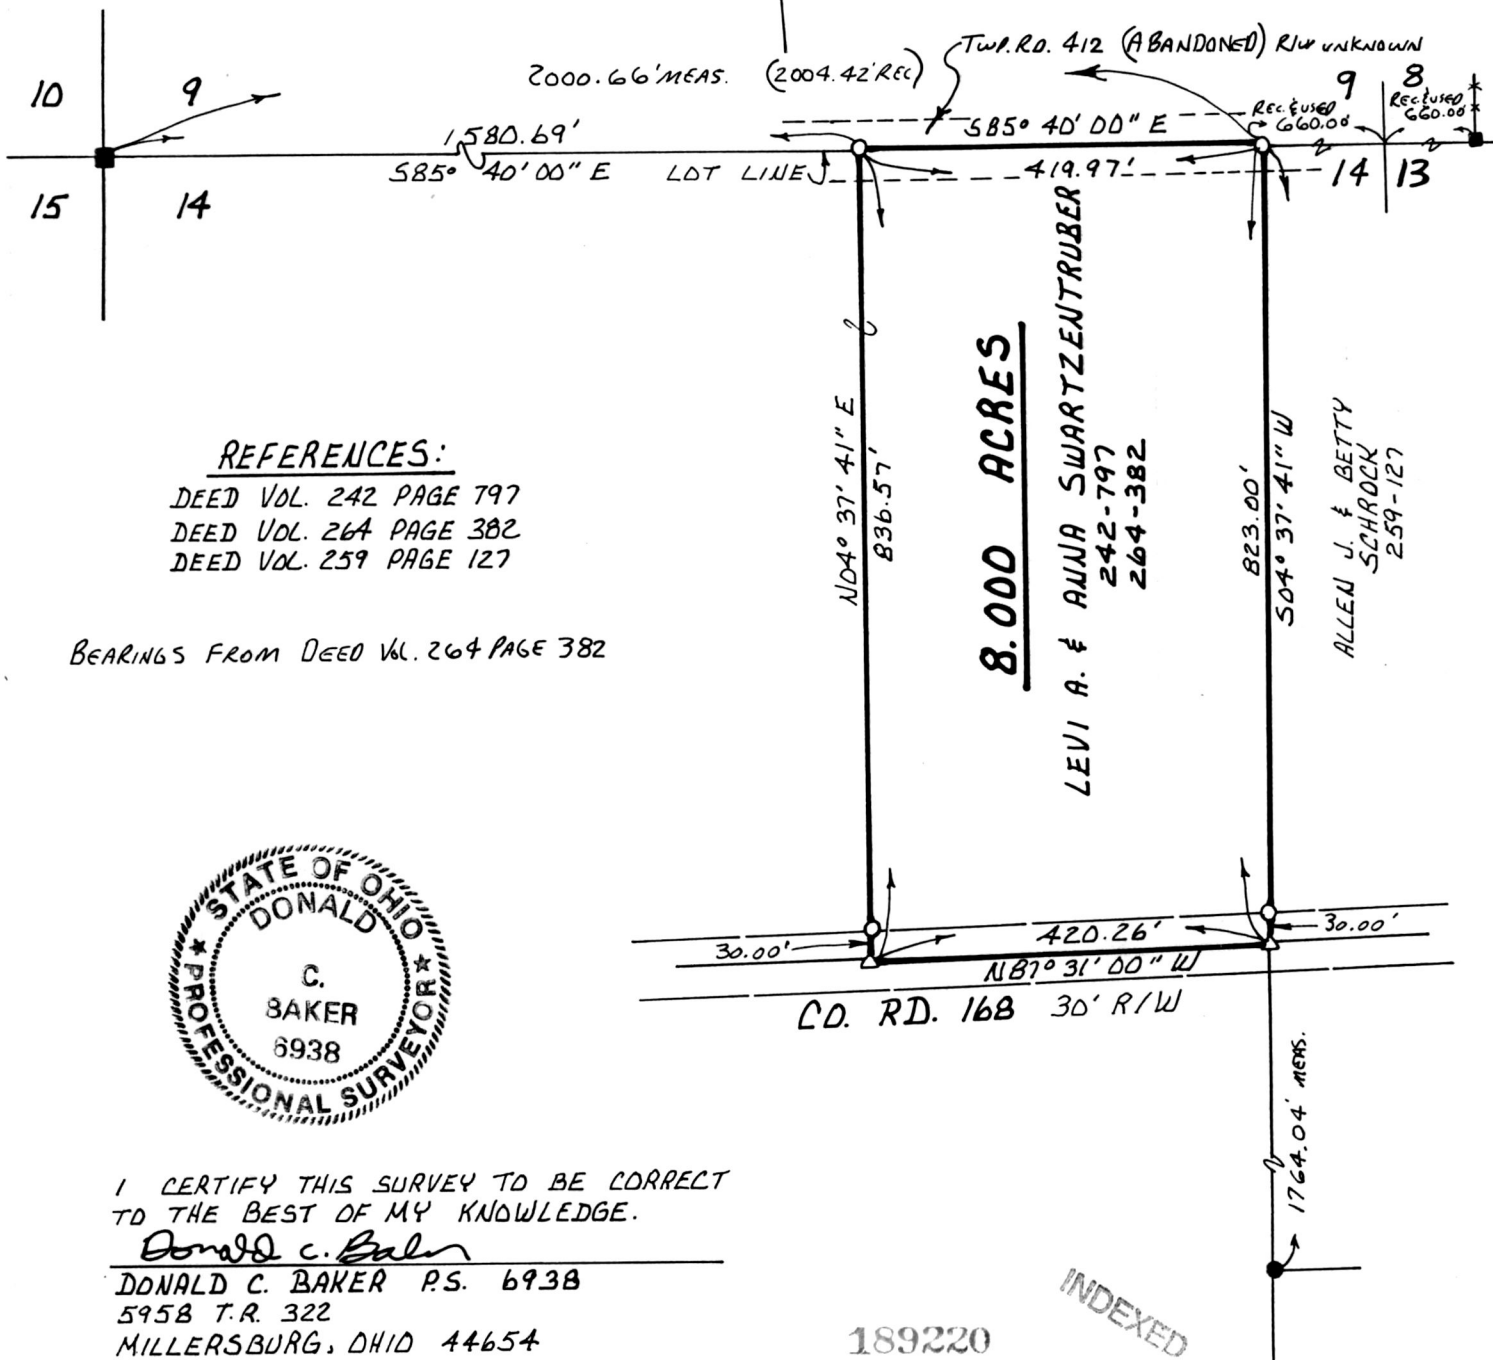

REFERENCES:

- DEED VOL. 242 PAGE 797
- DEED VOL. 264 PAGE 382
- DEED VOL. 259 PAGE 127

BEARINGS FROM DEED VOL. 264 PAGE 382



I CERTIFY THIS SURVEY TO BE CORRECT TO THE BEST OF MY KNOWLEDGE.

*Donald C. Baker*

DONALD C. BAKER P.S. 6938  
5958 T.R. 322  
MILLERSBURG, OHIO 44654  
PH: (216) 674-4788

AUGUST 2, 1994

189220

INDEXED

REC'D  
AT 1:52 o'clock P.M.

RECORDED  
FEE \$20.00

43094-BEC

SEP 01 '94

SEP 02 '94

Plat  
VOL 14 PAGE 595  
Deed vol. 265 pg 798

*Sally Miller* RECORDER

PLAT APPROVED  
8/31/94 B