

KNOX TOWNSHIP
S.E. QTR. SECTION 23
T-19 N; R-15 W
HOLMES COUNTY, OHIO




SCALE: 1"=100'

- P.K. NAIL FOUND
- IRON PIN FOUND
- 5/8" RE BAR WITH I.D. CAP SET
- I.D. CAP MARKED "BAKER 6938"

REFERENCES:

- PLAT VOL. 14 PAGE 211
- PLAT VOL. 14 PAGE 303
- DEED VOL. 260 PAGE 6
- DEED VOL. 183 PAGE 736
- DEED VOL. 261 PAGE 629
- DEED VOL. 186 PAGE 420

BEARINGS FROM SURVEY RECORD 4 PAGE 37

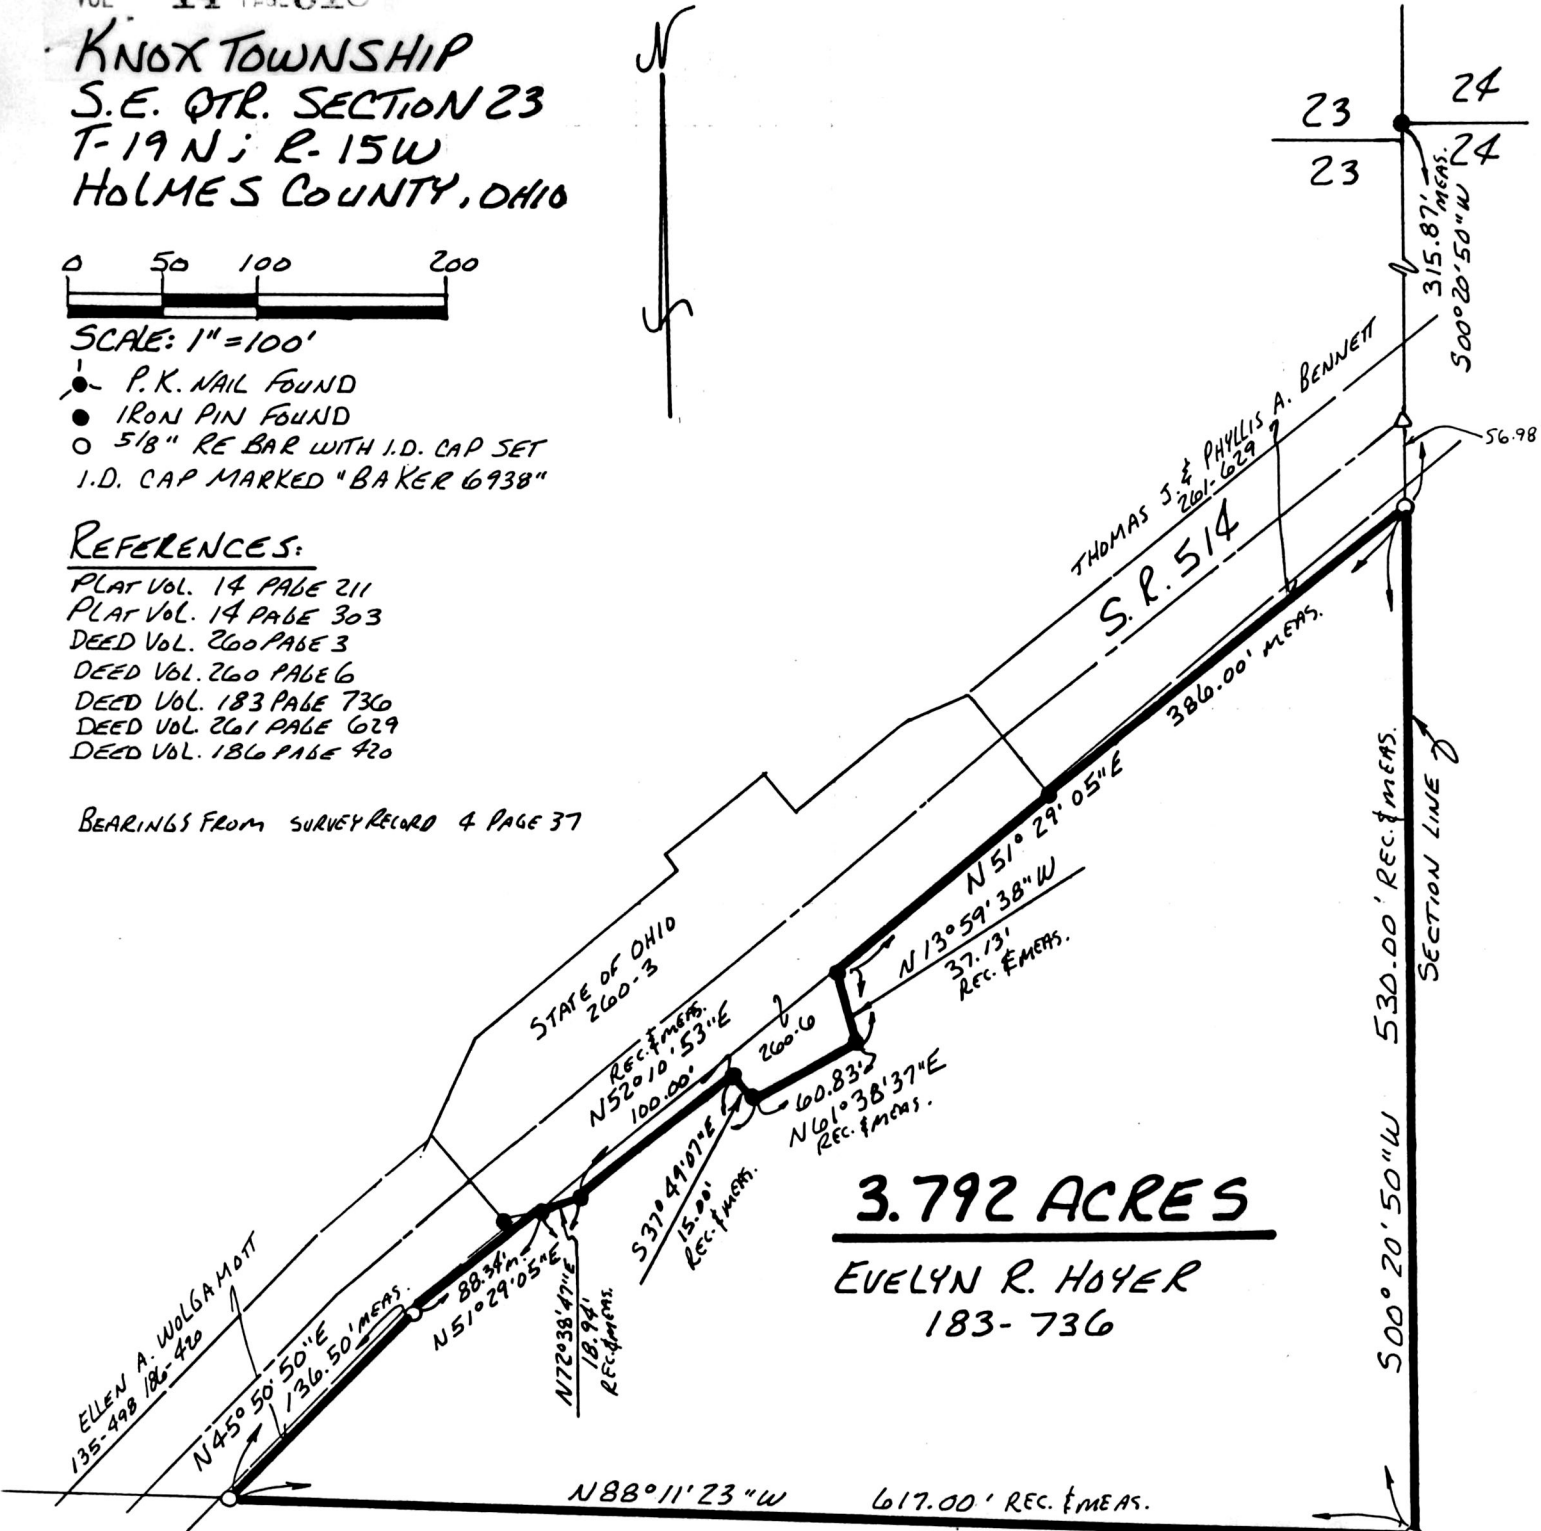

3.792 ACRES

EVELYN R. HOYER
183-736

WARREN H. & ELLEN E. MASSIE
137-65 189-597 208-303 208-306 261-694

I CERTIFY THIS SURVEY TO BE CORRECT
TO THE BEST OF MY KNOWLEDGE.

Donald C. Baker

DONALD C. BAKER P.S. 6938
5958 T.R. 322
MILLERSBURG, OHIO 44654
PH. (216) 674-4788
JULY 8, 1994
36494B-MCS



189563

REC'D
AT 4:29 o'clock P.M.

SEP 27 '94

Plat
VOL 14 PAGE 618
Deed vol. 261 pg 138

RECORDED
FEE \$20.00

SEP 28 '94

Sally Miller RECORDER
B.B.

PLAT APPROVED
9-27-94

INDEXED