


189927

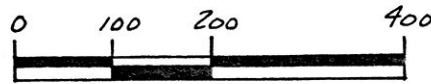

SCALE: 1" = 200'


- IRON PIN FOUND
- △ R.R. SPIKE SET
- 5/8" RE BAR WITH I.D. CAP SET
- I.D. CAP MARKED "BAKER 6938"



RIPLEY TOWNSHIP
S.W. QTR. SECTION 5
S.E. QTR. SECTION 6
T-17N; R-14W
HOLMES COUNTY, OHIO

REFERENCES:
 DEED VOL. 234 PAGE 162
 DEED VOL. 149 PAGE 413
 DEED VOL. 193 PAGE 446
 PLAT VOL. 7 PAGE 586
 PLAT VOL. 11 PAGE 133
 PLAT VOL. 4 PAGE 19
 PLAT VOL. 5 PAGE 25
 PLAT VOL. 10 PAGE 631

BEARINGS FROM PLAT VOL. 11 PG. 133

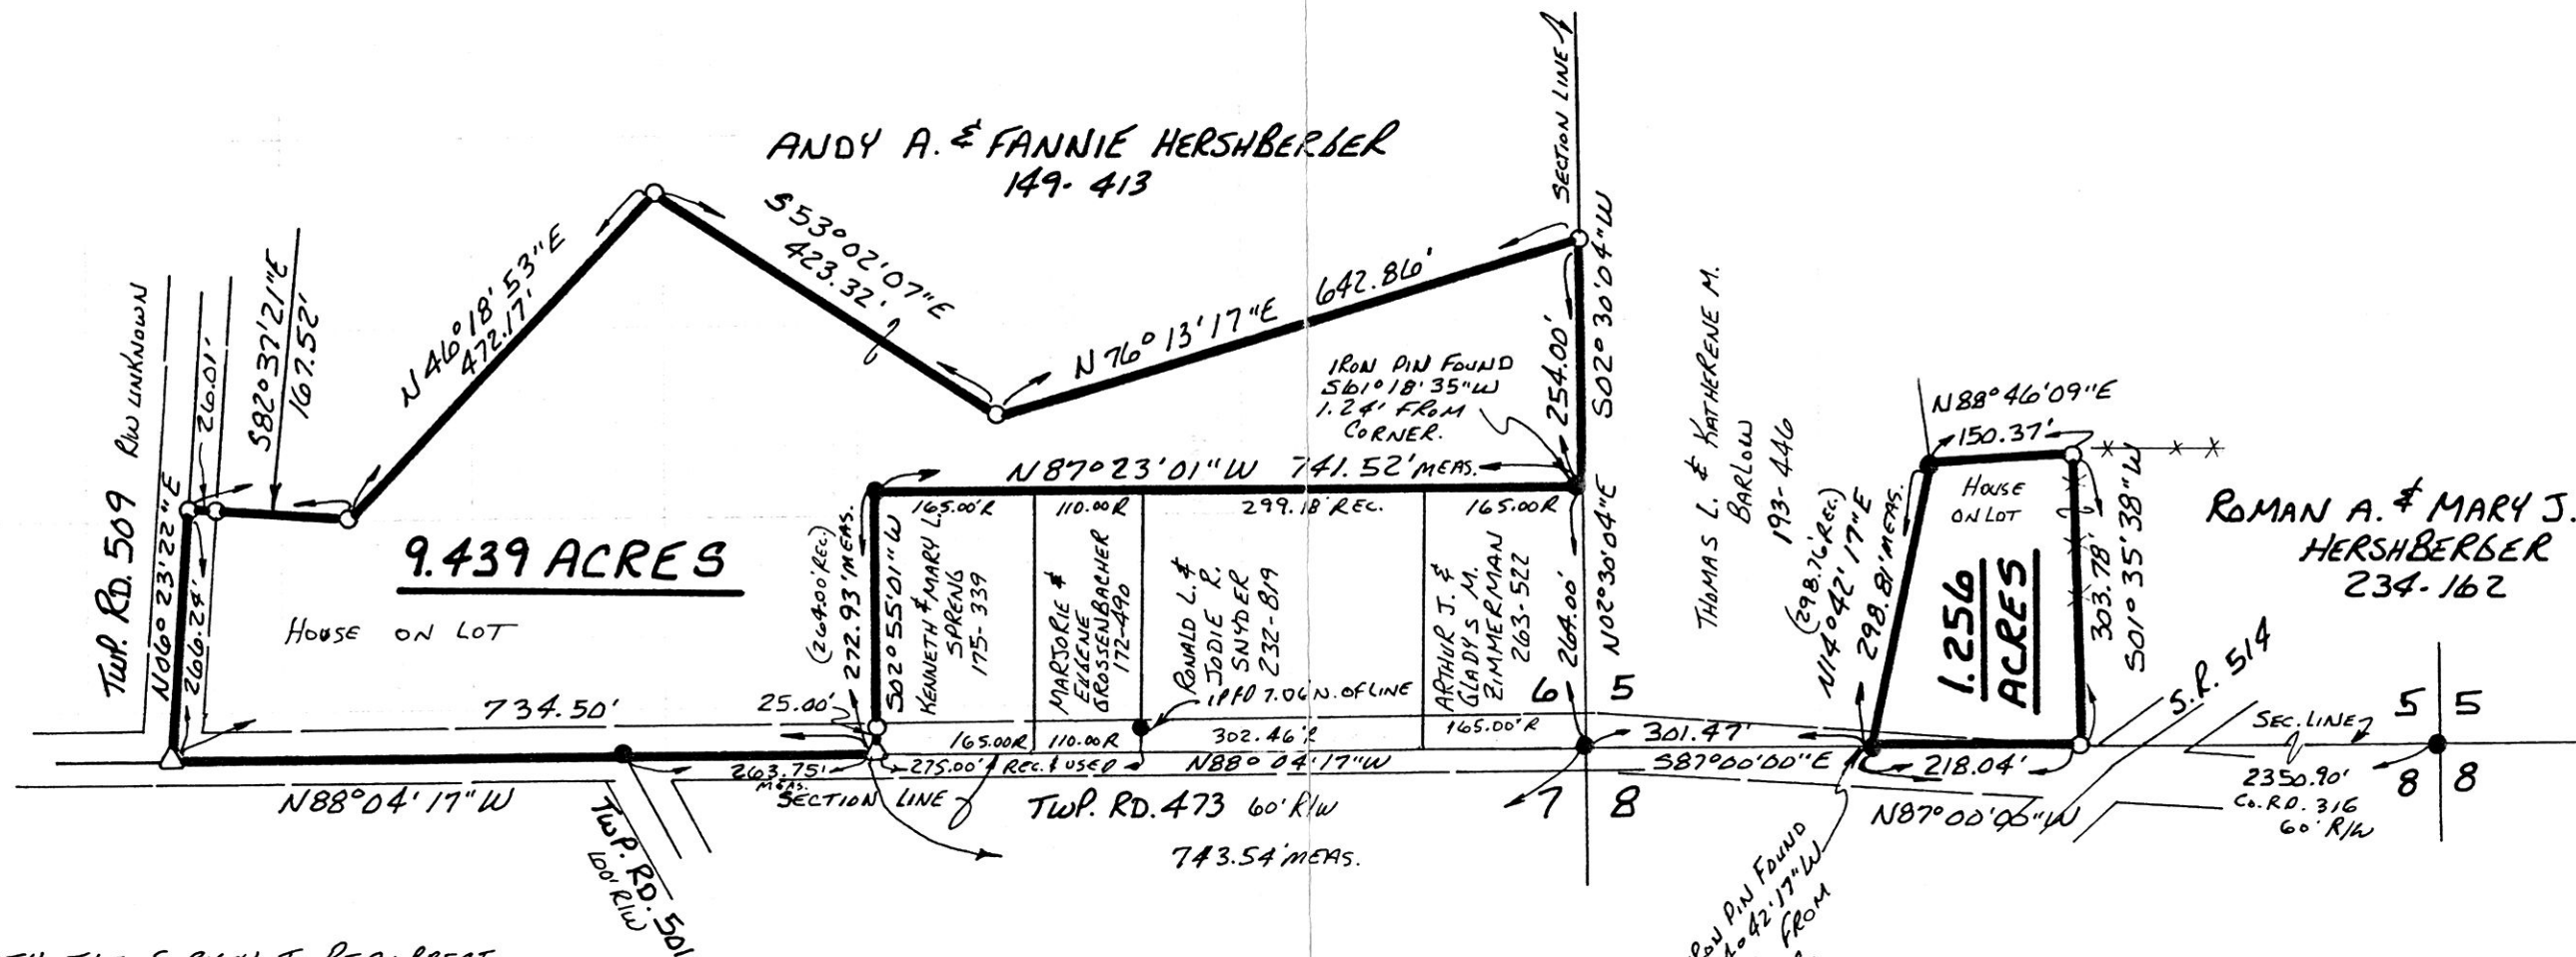

VOL 14 PAGE 638

I CERTIFY THIS SURVEY TO BE CORRECT TO THE BEST OF MY KNOWLEDGE.

Donald C. Baker
 DONALD C. BAKER P. S. 6938
 5958 T.R. 322
 MILLERSBURG, OHIO 44654
 PH. (216) 674-4788

AUGUST 2, 1994

41694-MLS



189927

REC'D
 AT 11:45 o'clock A.M.

RECORDED
 FEE \$20.00

OCT 27 '94

OCT 28 '94

Plat.
 VOL 14 PAGE 638 Sally Miller RECORDER
 Deed vol. 266 pg 491

INDEXED

R.I.R.