

190514

PAINT TOWNSHIP
N.W. QTR. SEC. 4
T-14N ; R-11W
HOLMES CO., OHIO

REFERENCES:

- DEED VOL. 262 PAGE 684
- DEED VOL. 178 PAGE 698
- DEED VOL. 239 PAGE 318
- PLAT VOL. 12 PAGE 9

BEARINGS FROM DEED VOL. 262
PAGE 684



SCALE: 1" = 200'

- STONE FOUND
- IRON PIN FOUND
- 5/8" REBAR WITH I.D. CAP SET.
I.D. CAP MARKED "BAKER
6938."


940211
APPROVED FOR TRANSFER ONLY
NO SUBDIVISION PLAT REQUIRED
(O.R.C. 711.001 & 711.131)
Lot(s) not for building unless
approved by Board of Health.
HOLMES CO. PLANNING COMM.
By TPM Date 12-14-94

HARVEY S. & NETTIE BOWMAN


2.209
ACRES

14.753 ACRES

MYRON A. & FRIEDA MAST
265-640 (TRANSFERRED 4-2-74)

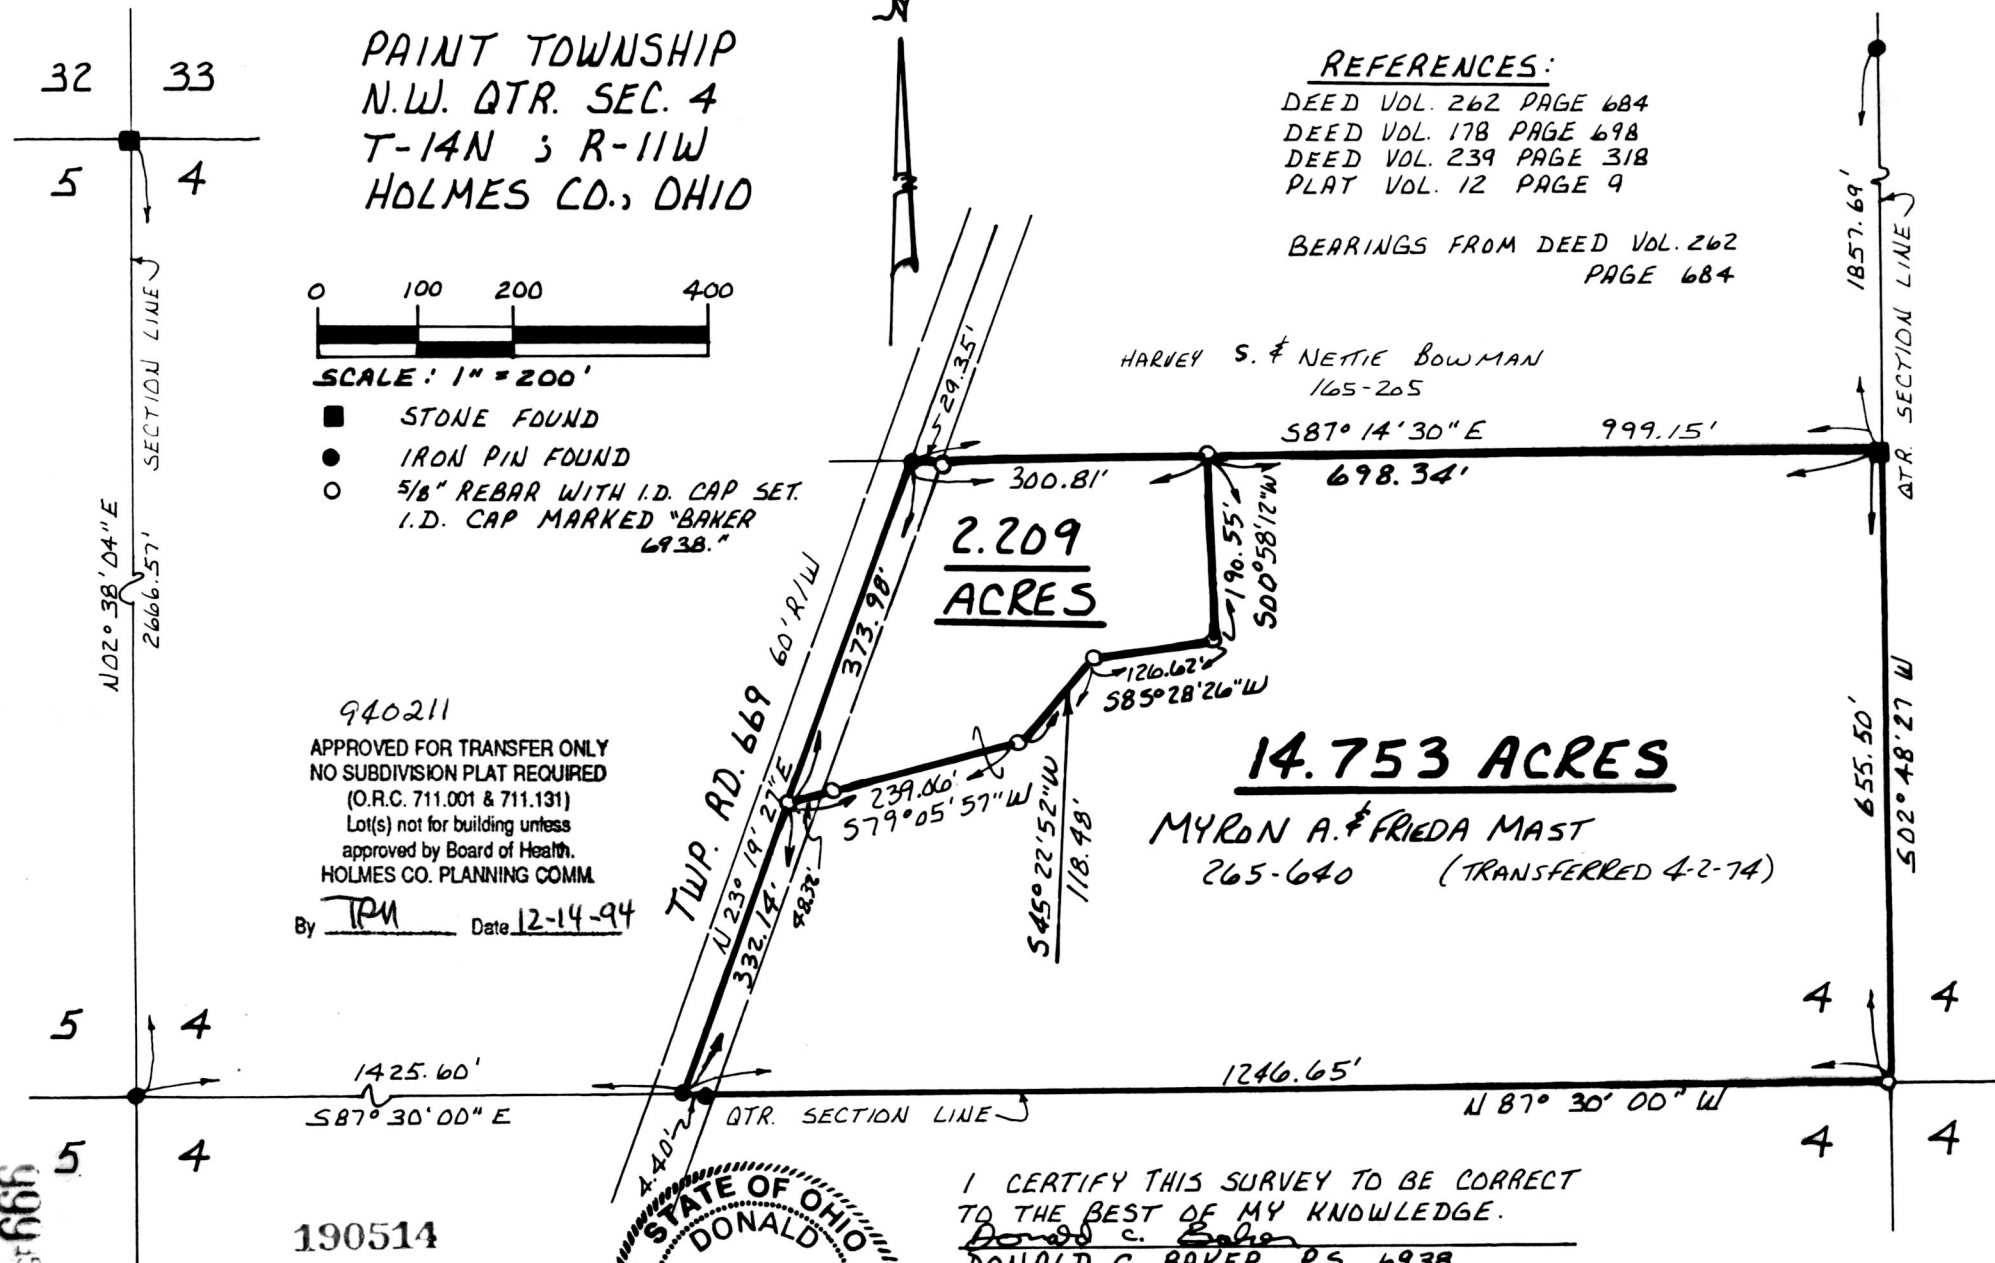

190514

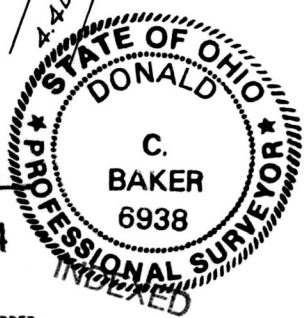

I CERTIFY THIS SURVEY TO BE CORRECT
TO THE BEST OF MY KNOWLEDGE.

Donald C. Baker
DONALD C. BAKER P.S. 6938
5958 T. R. 322
MILLERSBURG, OHIO 44654
PH: (216) 674-4788

JUNE 8, 1994
REVISED NOVEMBER 18, 1994

33094-BEL
63194-MU

PLAT APPROVED
12/14/94

VOL 14 PAGE 666

REC'D
AT 10:15 o'clock A.M.

RECORDED
FEE \$20.00

DEC 15 '94

DEC 16 '94

Plat.
VOL 14 PAGE 666 Sally Miller RECORDER
Deed vol. 266 pg 970 Janet