


VILLAGE OF MILLERSBURG OUT LOT 81

HARDY TOWNSHIP
SECTION 19, T-9N; R-7W
HOLMES COUNTY, OHIO

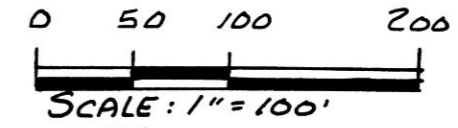


- ▲ R.R. SPIKE FOUND
- IRON PIN FOUND
- 5/8" RE BAR WITH I.D. CAP SET
I.D. CAP MARKED "BAKER 6938"

REFERENCES:

DEED Vol. 102 PAGE 115
 DEED Vol. 247 PAGE 869
 DEED Vol. 30 PAGE 246
 DEED Vol. 218 PAGE 316
 PLAT Vol. 5 PAGE 33

NOTE:

OUTLOT LINE ESTABLISHED
 FROM DEED Vol. 2 PG. 622

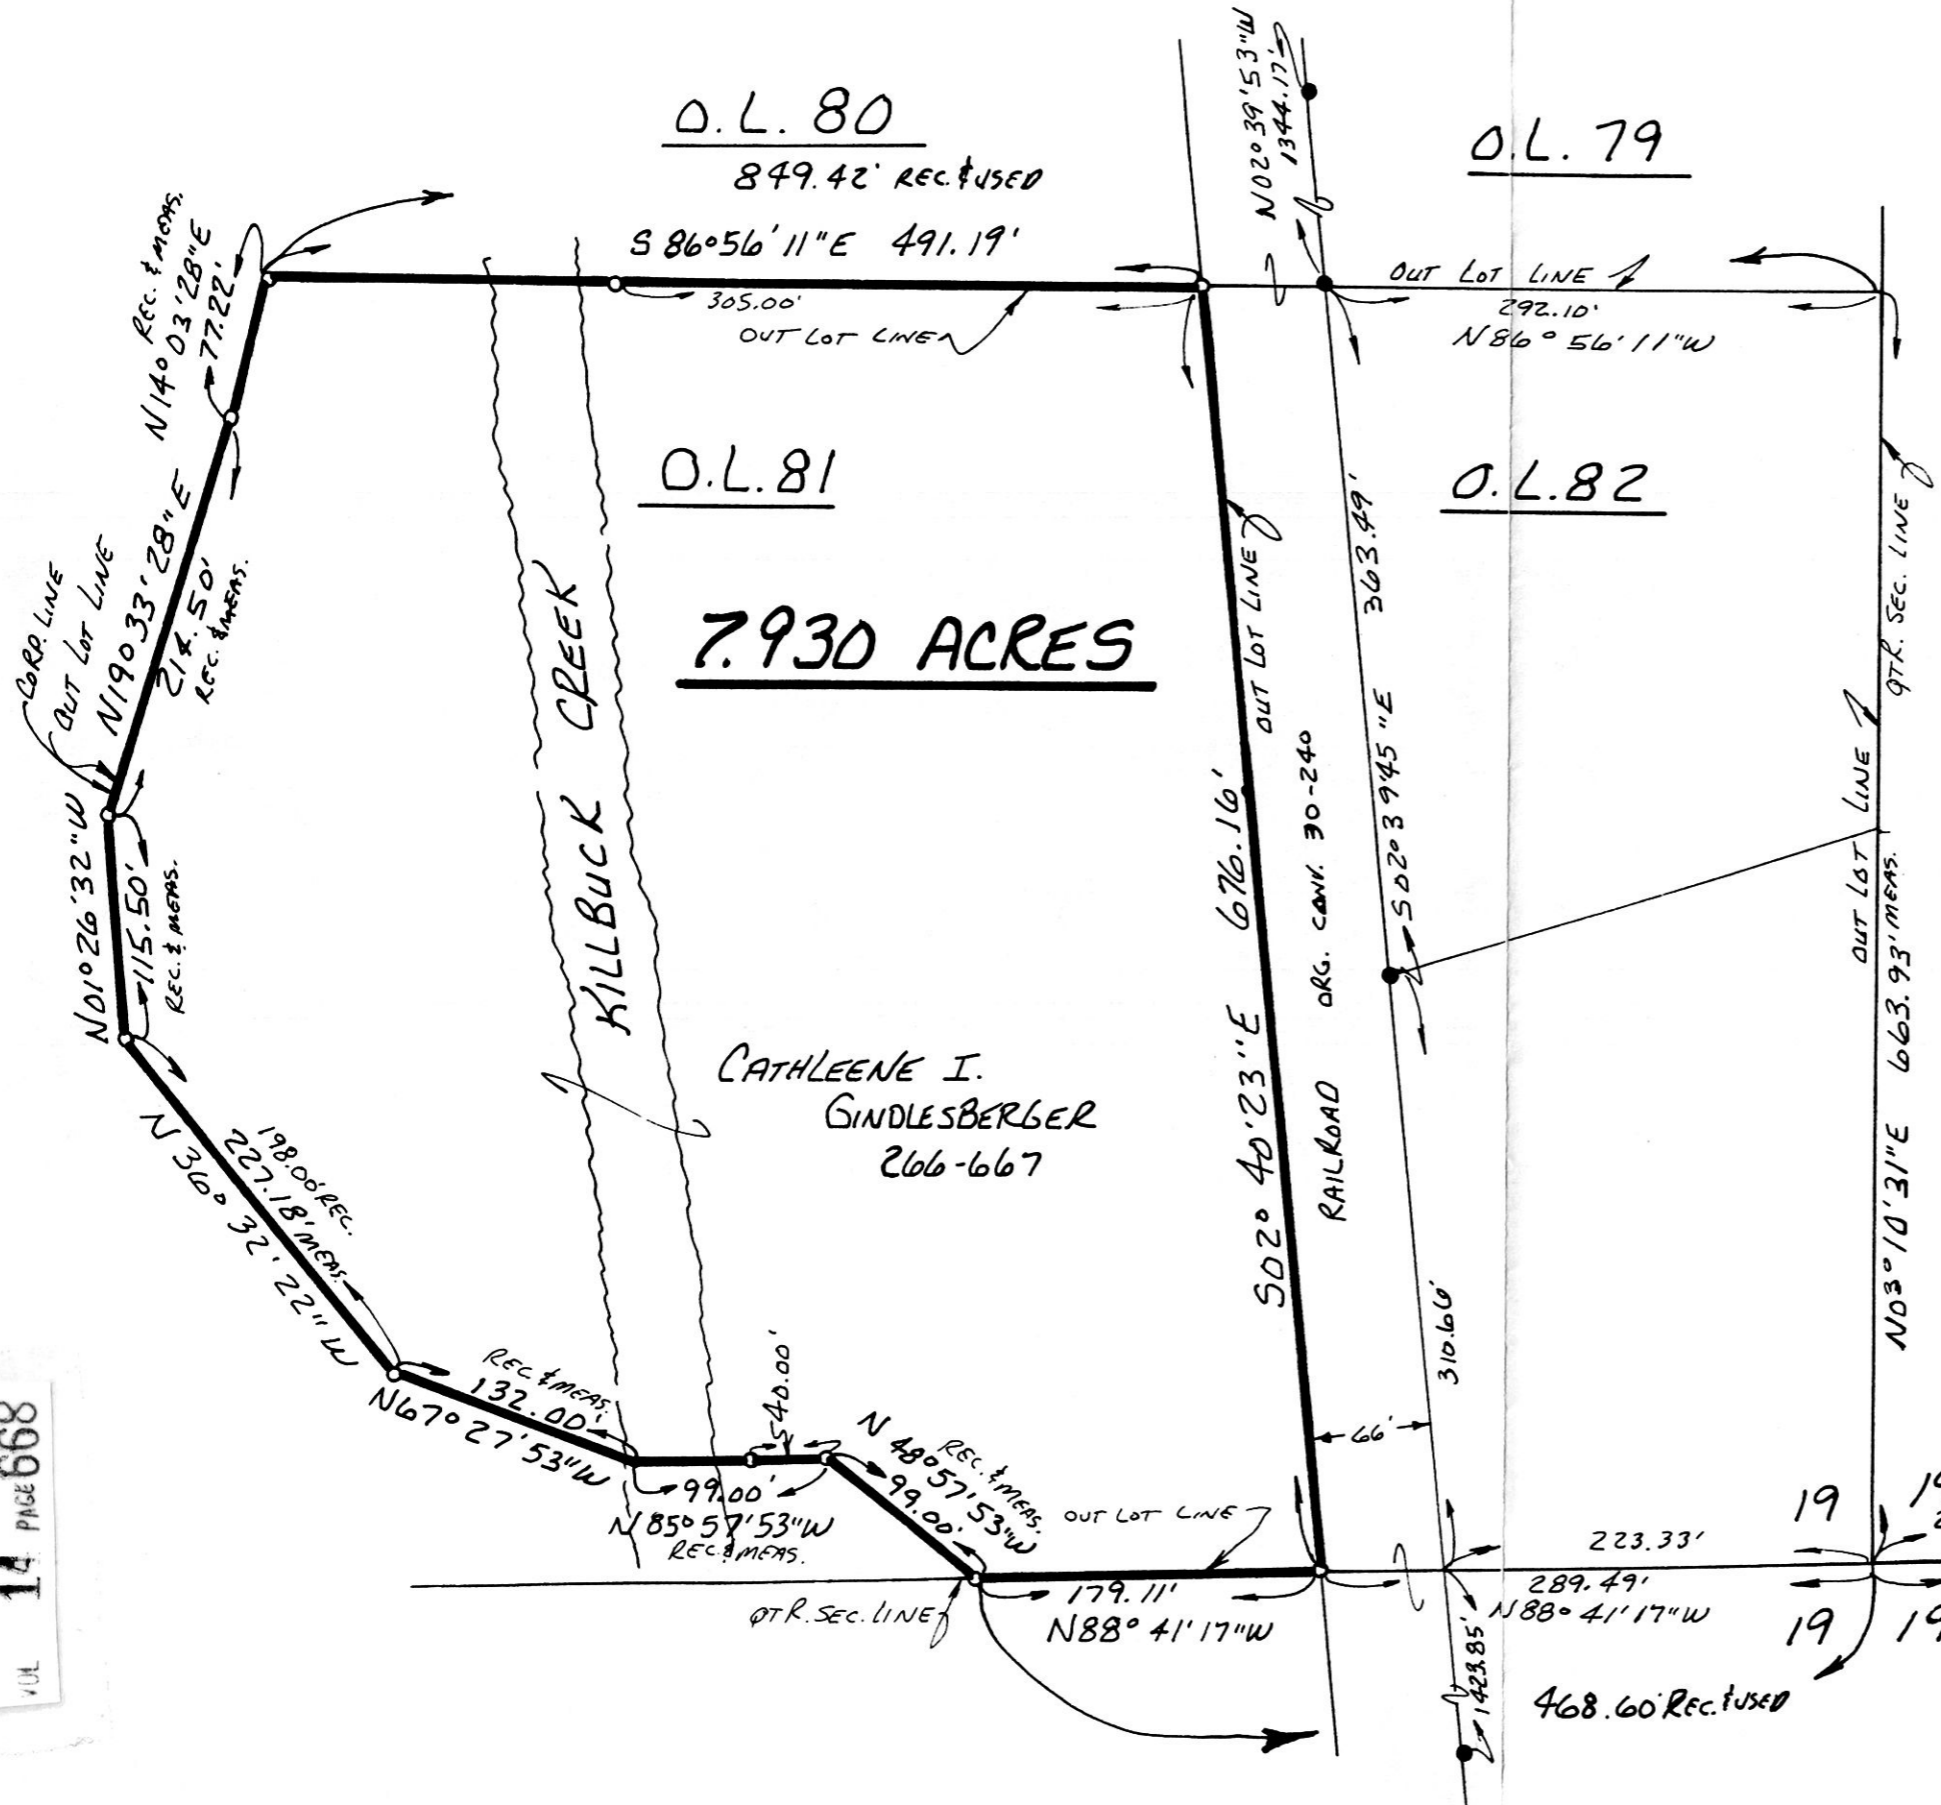

7.930 ACRES

CATHLENE I.
 GINDLESBERGER
 266-667

REC'D 190548
 AT 4:11 o'clock P.M.
 DEC 19 '94
 PLAT VOL 14 PAGE 668
 DV 266 pg 93

RECORDED
 FEE \$20.00
 DEC 20 '94
 RECORDED
 B.B.



I CERTIFY THIS SURVEY TO BE CORRECT
 TO THE BEST OF MY KNOWLEDGE.

Donald C. Baker
 DONALD C. BAKER P.S. 6938
 595 B.T.R. 322
 MILLERSBURG, OHIO 44654
 PH. (216) 674-4788
 DECEMBER 8, 1994

64294-MLS

PLAT APPROVED
 12/19/94

VOL 14 PAGE 668