VOL 14 PAGE 709

CLARK TOWNSHIP
N.W. QTR. SECTION 18
T-8 N ; R-5 W
HOLMES COUNTY, OHIO

0 150 300 600

SCALE : 1" = 300'

- ● IRON PIN FOUND
- ■ STONE FOUND
- o 5/8" REBAR WITH I.D. CAP SET I.D. CAP MARKED "BAKER 6938"

REFERENCES:

DEED VOL. 263 PAGE 99
DEED VOL. 246 PAGE 110
DEED VOL. 264 PAGE 386
DEED VOL. 230 PAGE 125
DEED VOL. 252 PAGE 37
PLAT VOL. 12 PAGE 698

190918

INDEXED

REC'D	RECORDED
AT 10:20 o'clock A.m.	FEE $20.00
JAN 19 '95	JAN 20 '95

Plat.
VOL 14 PAGE 709 Sally Miller RECORDER
OV 267 pg 321

DONALD C. BAKER 6938 REGISTERED SURVEYOR PROFESSIONAL SURVEYOR

I CERTIFY THIS SURVEY TO BE CORRECT TO THE BEST OF MY KNOWLEDGE.

Donald C. Baker

DONALD C. BAKER P.S. 6938
5958 T.R. 322
MILLERSBURG, OHIO 44654
PH. (216) 674-4788
DECEMBER 30, 1994

6694-MLS

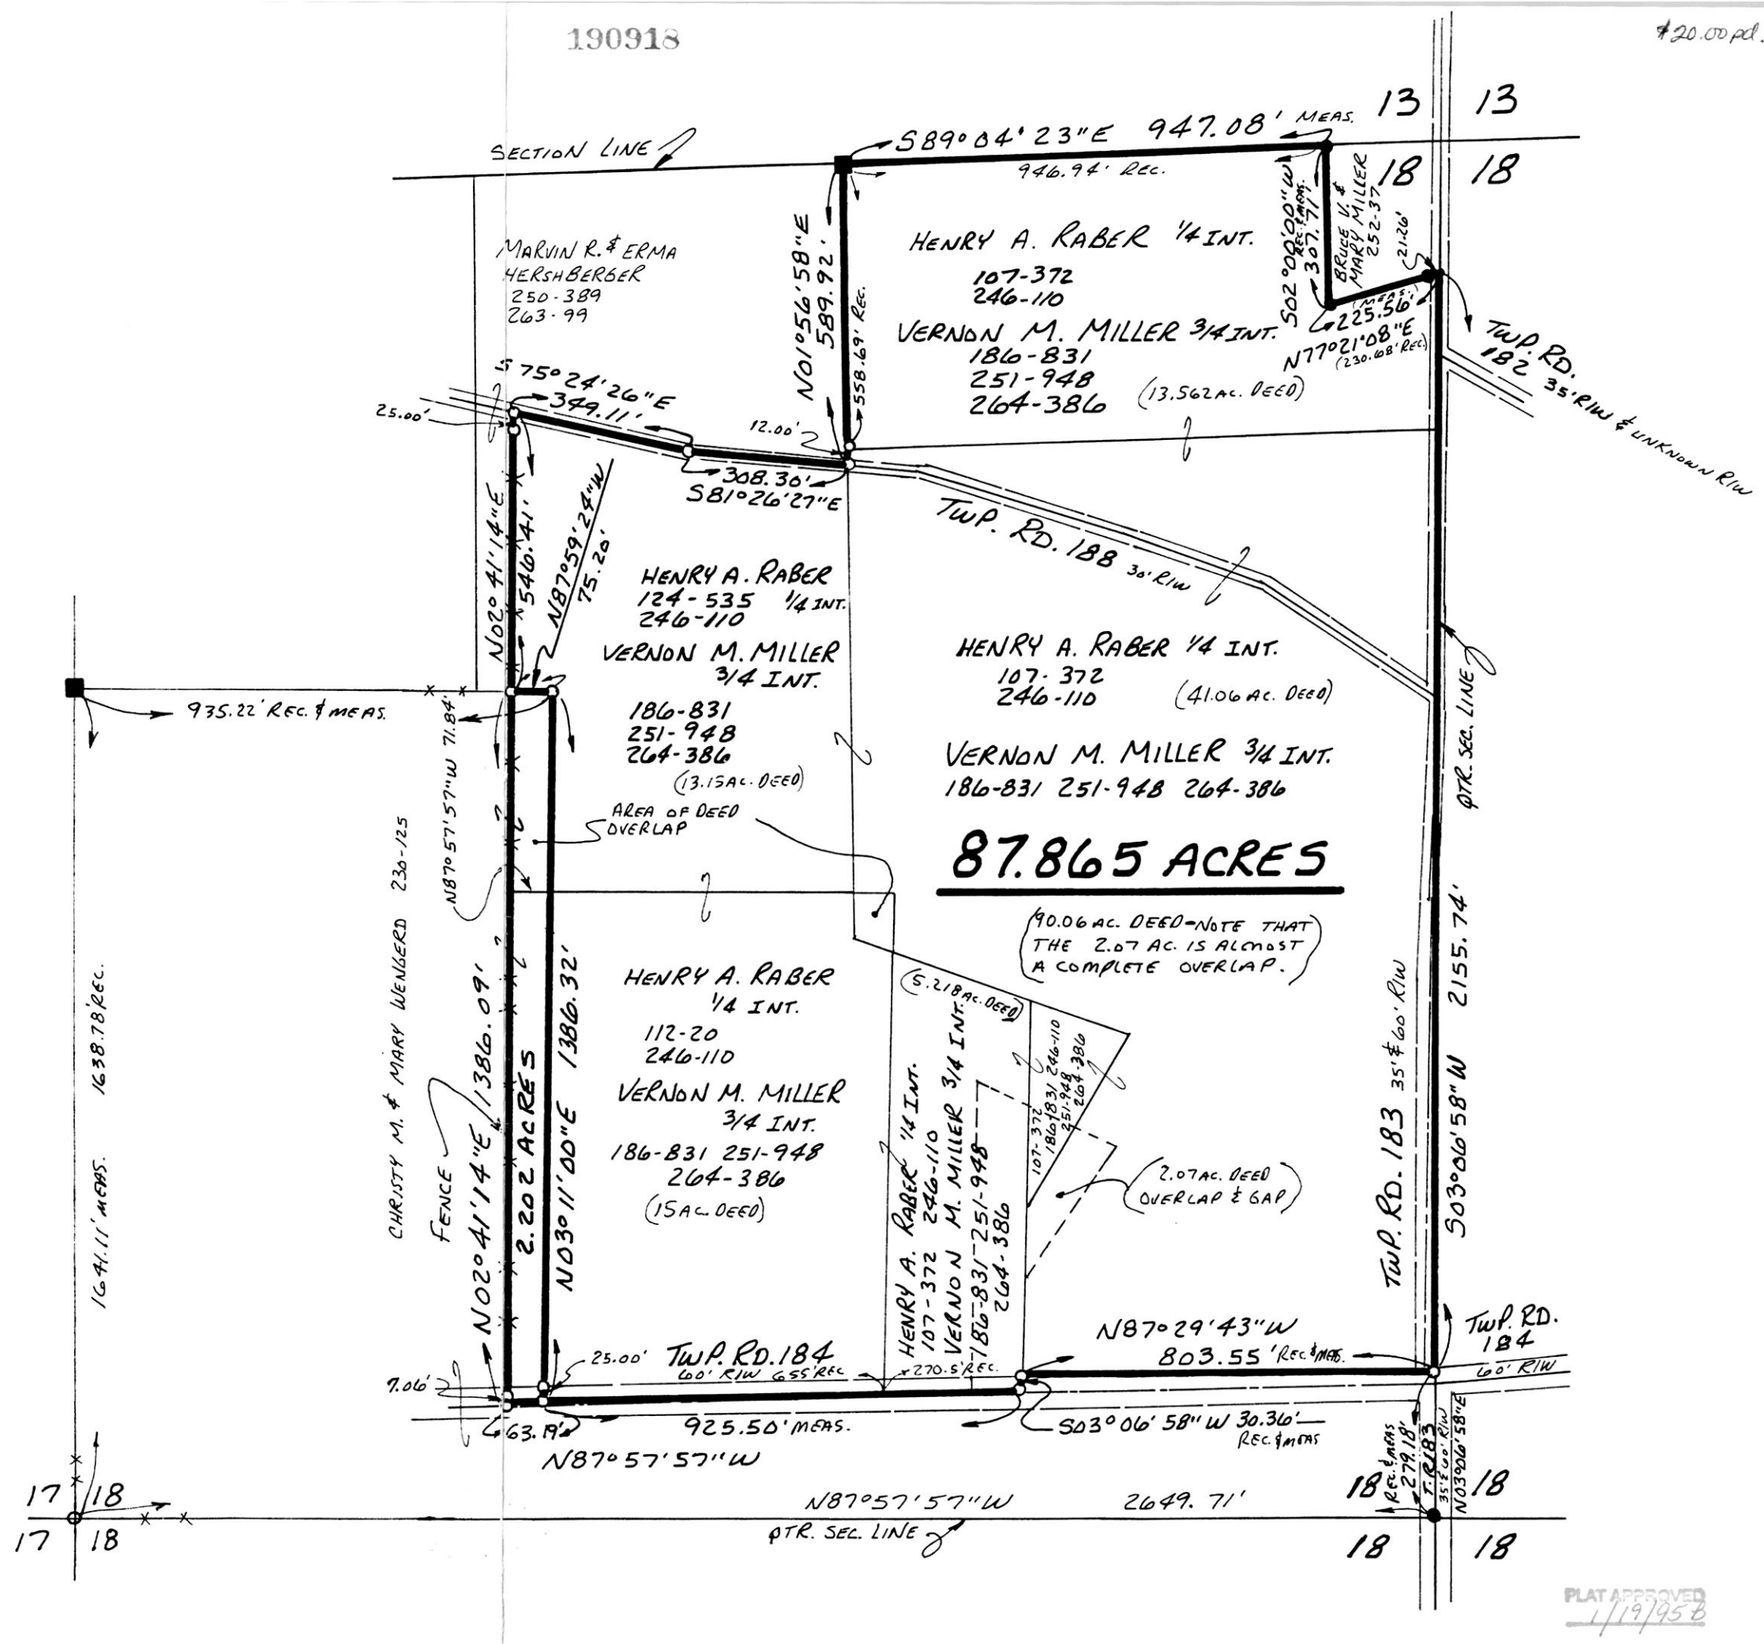

PLAT APPROVED 1/19/95 B