


191107

SALT CREEK TOWNSHIP N.E. QTR. SECTION 10 T-14 N ; R-12 W HOLMES COUNTY, OHIO

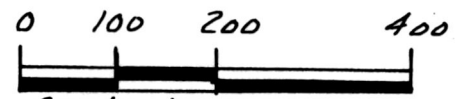


SCALE: 1" = 200'

- ▲ R.R. SPIKE FOUND
- IRON PIN FOUND
- 5/8" RE BAR WITH I.D. CAP SET
- I.D. CAP MARKED "BAKER 6938"

REFERENCES:

- DEED Vol. 234-541
- DEED Vol. 257 PAGE 578
- DEED Vol. 234 PAGE 537
- PLAT Vol. 10 PAGE 708

BEARINGS FROM DEED Vol. 75 PG. 55

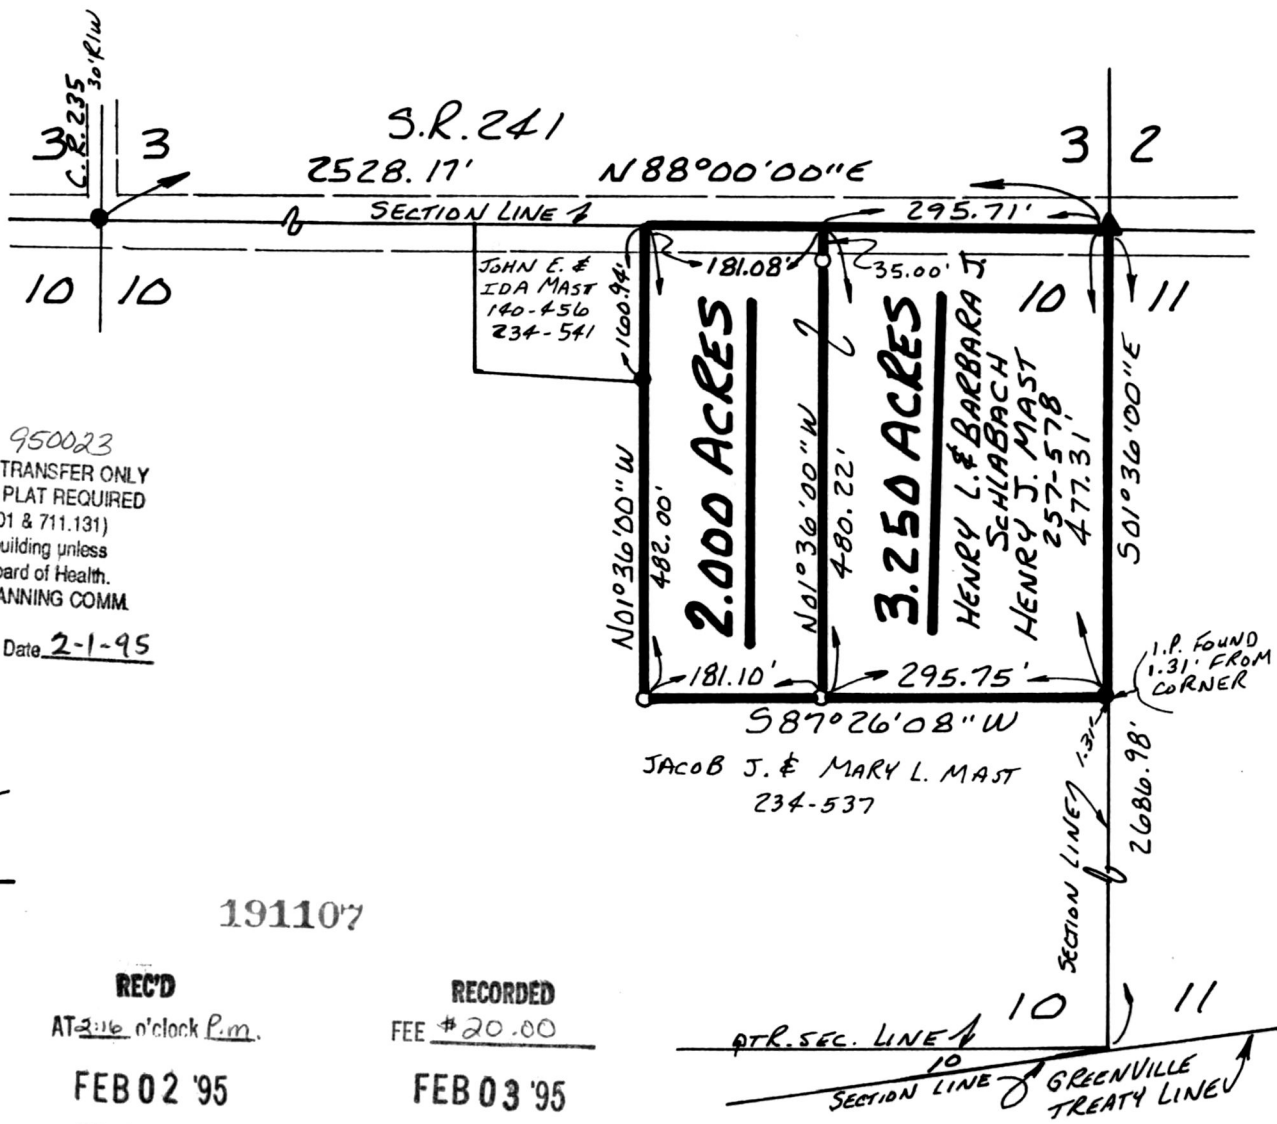

950022 950023
 APPROVED FOR TRANSFER ONLY
 NO SUBDIVISION PLAT REQUIRED
 (O.R.C. 711.001 & 711.131)
 Lot(s) not for building unless
 approved by Board of Health,
 HOLMES CO. PLANNING COMM.
 By TCM Date 2-1-95



I CERTIFY THIS SURVEY TO BE CORRECT
TO THE BEST OF MY KNOWLEDGE.

Donald C. Baker
 DONALD C. BAKER P.S. 6938
 5958 T.R. 322
 MILLERSBURG, OHIO 44654
 PH. (216) 674-4788
 DECEMBER 29, 1994

68694-MLS

191107

REC'D
AT 2:16 o'clock P.M.

FEB 02 '95

RECORDED
FEE \$20.00

FEB 03 '95

Plat
 VOL 14 PAGE 722 Sally Miller RECORDER
 by 267 pgs. 494-496 Laurel

PLAT APPROVED
2/2/95B

VOL 14 PAGE 722