


0 50 100 200

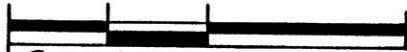


SCALE: 1" = 100'

- ▲ R. R. SPIKE FOUND
- IRON PIN FOUND
- 5/8" RE BAR WITH I.D. CAP SET
- I.D. CAP MARKED "BAKER 6938"

REFERENCES:

- DEED Vol. 201 PAGE 75
- " " 237 " 701
- " " 217 " 305
- PLAT Vol. 4 PAGE 116
- " " 3 " 48 B
- " " 3 " 20 B
- " " 12 " 56 2

BEARINGS FROM DEED Vol. 244 PAGE 422

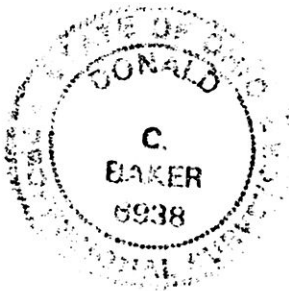

I CERTIFY THIS SURVEY TO BE CORRECT TO THE BEST OF MY KNOWLEDGE.

Donald C. Baker


DONALD C. BAKER P.S. 6938  
 5958 T.R. 322  
 MILLERSBURG, OHIO 44654  
 PH. (216) 674-4788  
 FEBRUARY 3, 1995  
 3895-MLS

191502

BERLIN TOWNSHIP  
 N.E. QTR. SECTION 6  
 T-9N ; R-5W  
 HOLMES COUNTY, OHIO

VILLAGE OF BUNKER HILL

RESURVEY OF DEED VOL.  
 201 PAGE 75

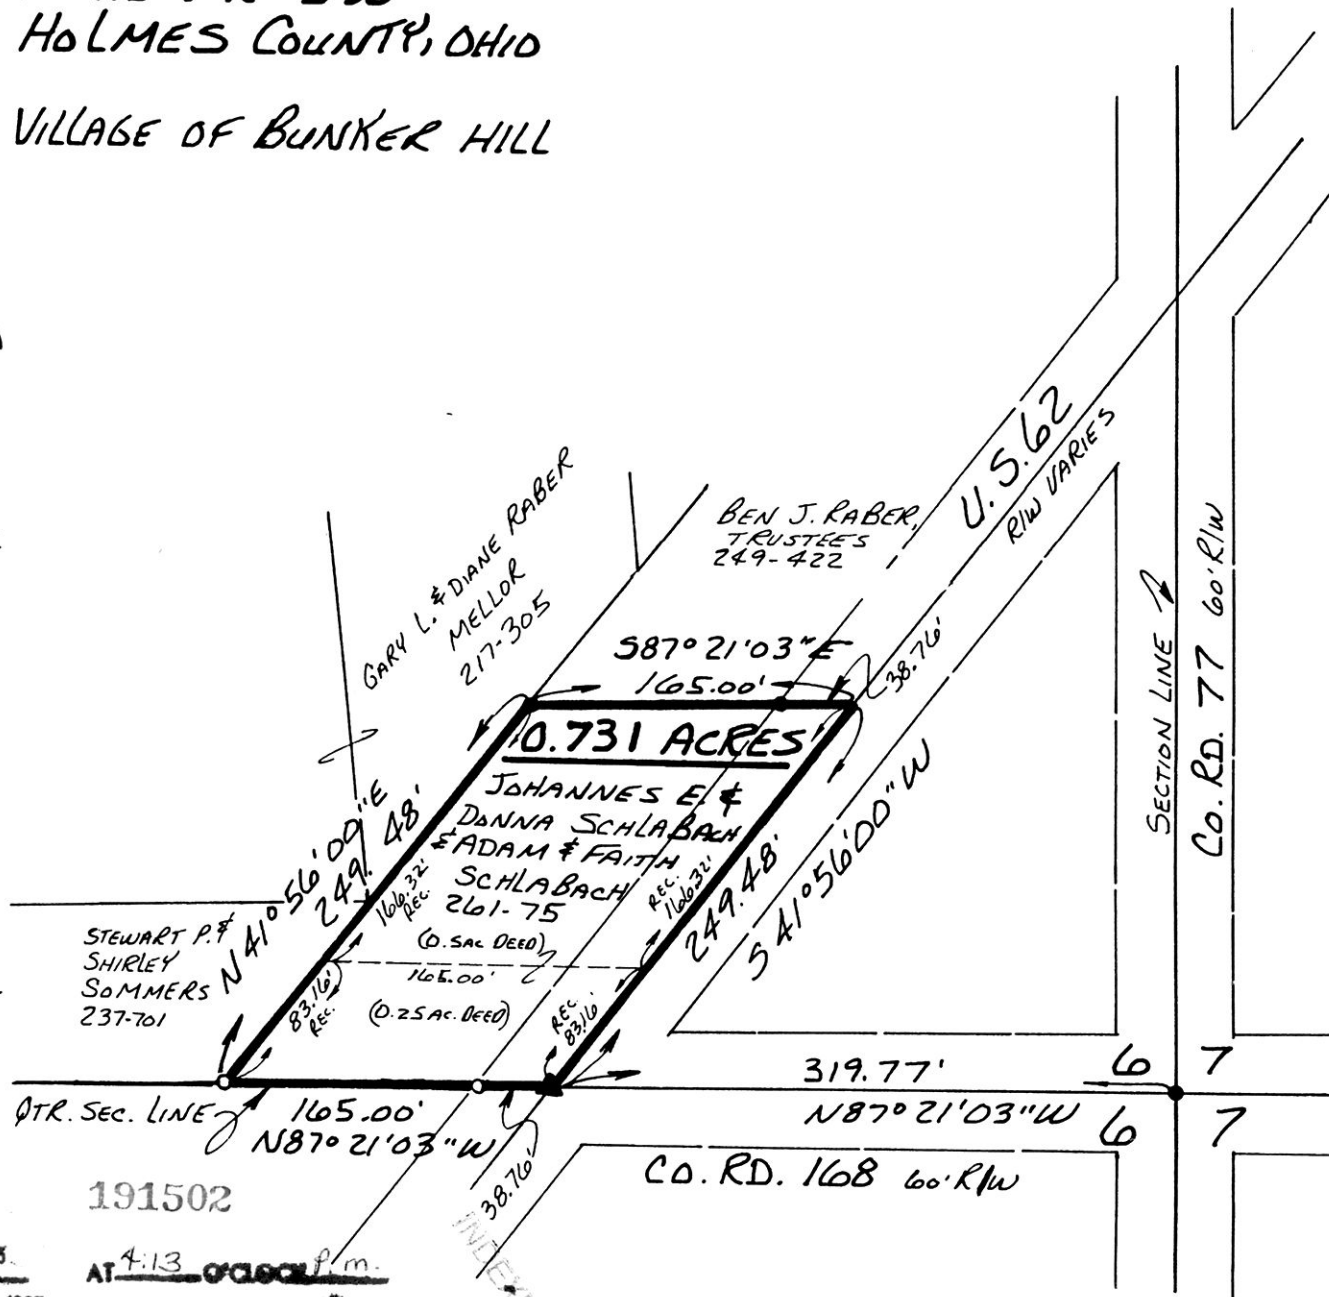

VOL 14 PAGE 754

Res'd. MAR 08 1995  
 Recorded MAR 09 1995

AT 4:13 O'CLOCK P.M.  
 Holmes Co. Ohio Fee \$20.00  
 Pg 754 Recorder Larry Miller

Plat Vol. 14  
 On 267 pg 816

PLAT APPROVED  
 3/8/95B