



PAINT TOWNSHIP
N.W. QTR. SECTION 31
T-15N R-11W
HOLMES COUNTY, OHIO

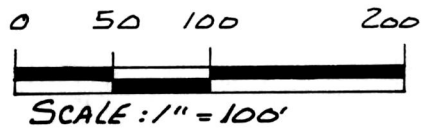

- SCALE: 1" = 100'
- ▲ R.R. SPIKE FOUND
 - P.K. NAIL FOUND
 - IRON PIN FOUND
 - 5/8" REBAR WITH I.D. CAP SET
 - I.D. CAP MARKED "BAKER 6938"

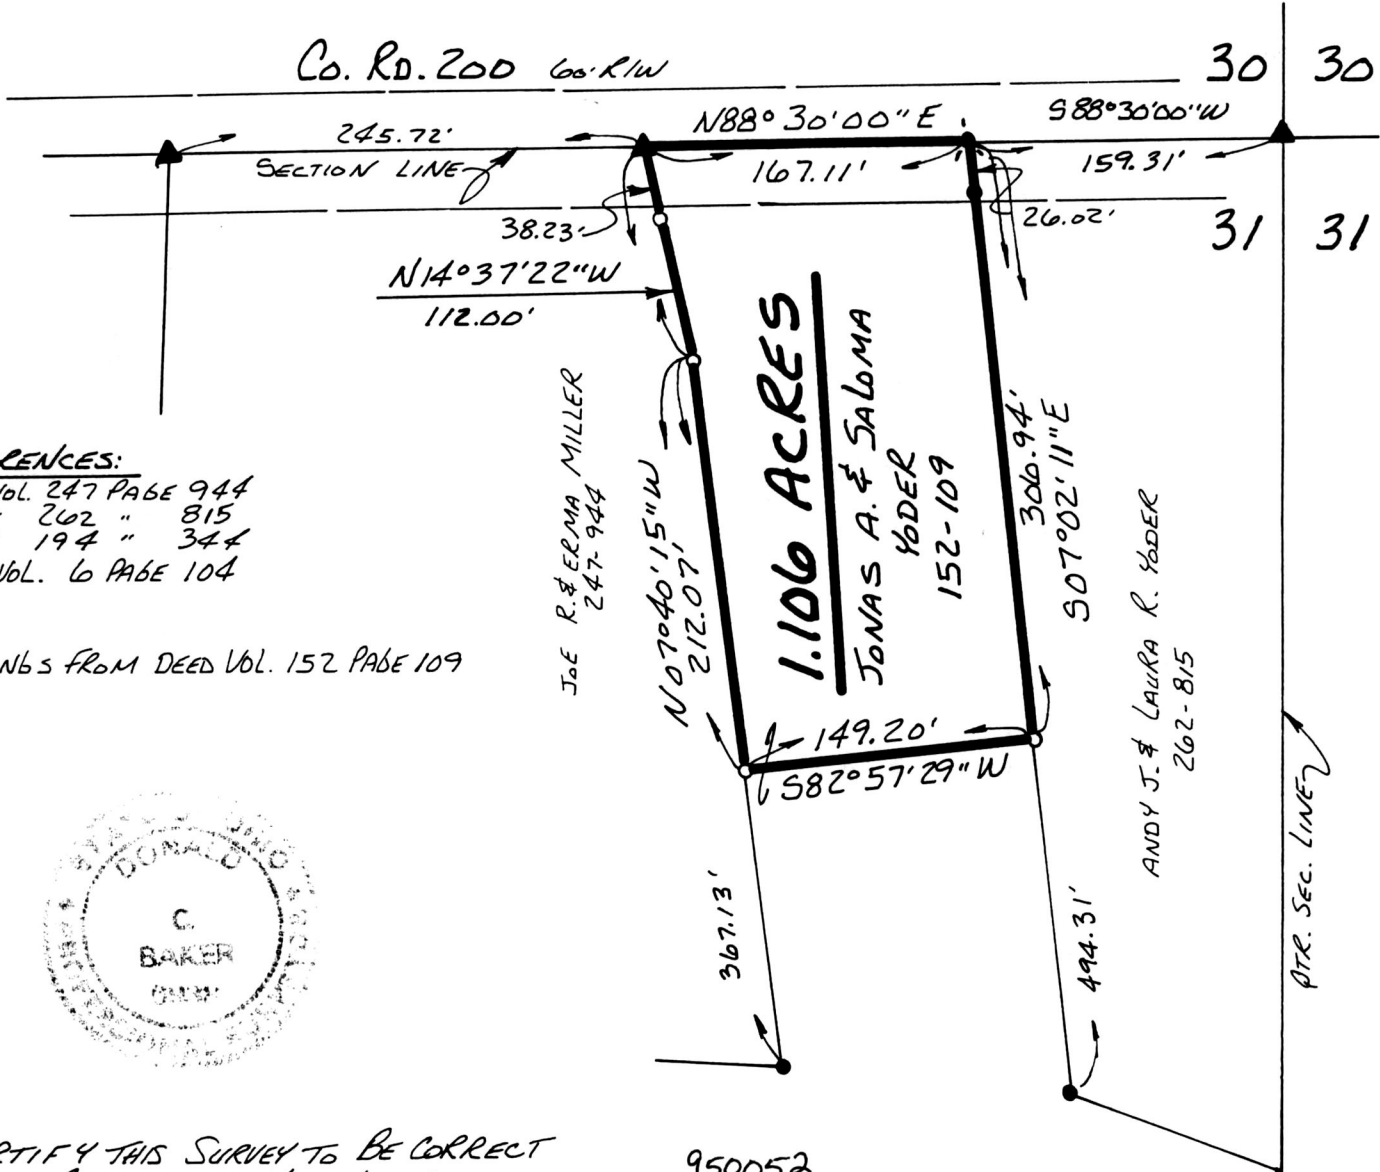

REFERENCES:
 DEED Vol. 247 PAGE 944
 " " 262 " 815
 " " 194 " 344
 PLAT Vol. 6 PAGE 104

BEARINGS FROM DEED Vol. 152 PAGE 109



I CERTIFY THIS SURVEY TO BE CORRECT TO THE BEST OF MY KNOWLEDGE.

Donald C. Baker
 DONALD C. BAKER P.S. 6938
 5958 T.R. 322
 MILLERSBURG, OHIO 44654
 PH. (216) 674-4788
 FEBRUARY 27, 1995

950052
 APPROVED FOR TRANSFER ONLY
 NO SUBDIVISION PLAT REQUIRED
 (O.R.C. 711.001 & 711.131)
 Lot(s) not for building unless
 approved by Board of Health.
 HOLMES CO. PLANNING COMM.
 By TPY Date 3-9-95

7995-MLS
 Res'd. MAR 10 1995 AT 3:00 P.M.
 Recorded MAR 13 1995 Holmes Co. Ohio Fee # 20.00
 Plat Vol. 14 Pg. 756 Recorder Sally Miller
 DV 267 pg 834

INDEXED

PLAT APPROVED
3/10/95