

WALNUT CREEK TOWNSHIP
1ST. QTR. LOT 13
T-9N ; R-5W
HOLMES COUNTY, OHIO



SCALE: 1" = 100'

- IRON PIN FOUND
- ▲ R. R. SPIKE FOUND
- △ R. R. SPIKE SET
- 5/8" REBAR WITH I.D. CAP SET.
I.D. CAP MARKED "BAKER 6938."


REFERENCES:

- DEED VOL. 259 PAGE 127
- DEED VOL. 222 PAGE 991
- DEED VOL. 246 PAGE 365
- DEED VOL. 197 PAGE 162
- PLAT VOL. 10 PAGE 234

APPROVED FOR TRANSFER ONLY
NO SUBDIVISION PLAT REQUIRED
(O.R.C. 711.001 & 711.131)
Lot(s) not for building unless
approved by Board of Health.
HOLMES CO. PLANNING COMM.

By TRM Date 6-28-95

BEARINGS FROM DEED VOL. 222 PAGE 991

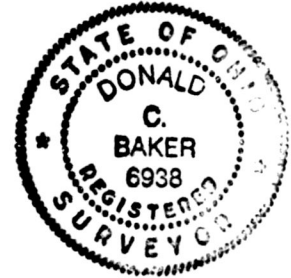

I CERTIFY THIS SURVEY TO
BE CORRECT TO THE BEST
OF MY KNOWLEDGE.


Donald C. Baker
DONALD C. BAKER P.S. 6938
595B T.R. 322
MILLERSBURG, OHIO 44654
PH: (216) 674-4788

DECEMBER 17, 1993
REVISED DECEMBER 21, 1994

69293-BEC

PLAT APPROVED

6/28/95

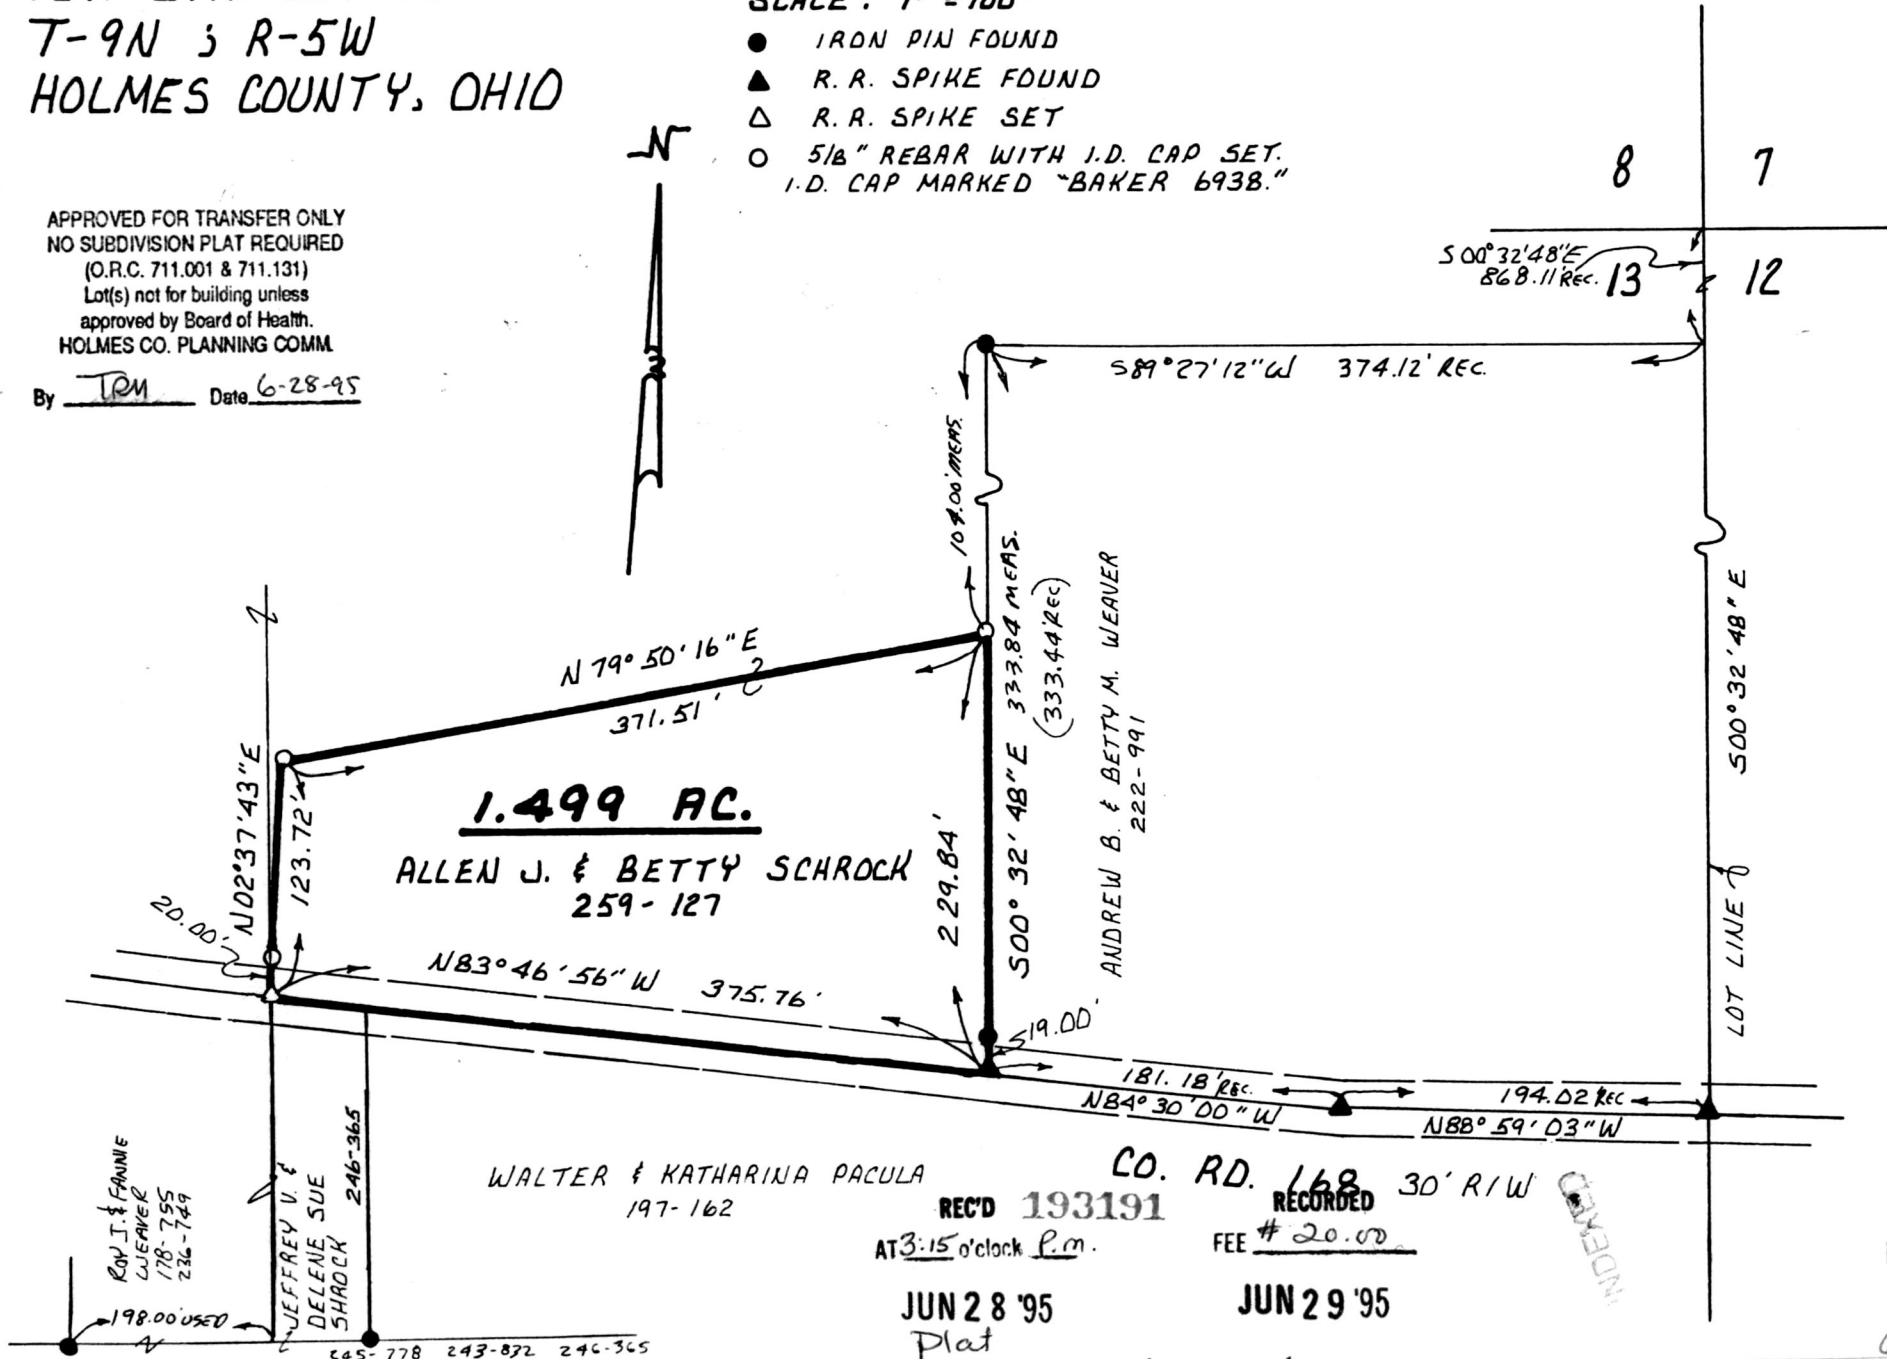

WALTER & KATHARINA PACULA
197-162

CO. RD. 168 30' R/W

REC'D 193191

RECORDED

AT 3:15 o'clock P.M.

FEE #20.00

JUN 28 '95

JUN 29 '95

Plat

VOL 14 PAGE 839
OV 269 P9 206

Sally Miller RECORDER

Laurel

INDEXED