

VOL 14 PAGE 927



SCALE: 1"=100'

- IRON PIN FOUND
- 5/8" RE BAR WITH I.D. CAP SET
- I.D. CAP MARKED "BAKER 6938"

WALNUT CREEK TOWNSHIP  
 S.E. QTR. SECTION 18  
 T-9N; R-5W  
 HOLMES COUNTY, OHIO



REFERENCES:

- DEED VOL. 218 PAGE 664
- " " 233 " 187
- " " 163 " 467
- " " 242 " 820
- PLAT VOL. 10 PAGE 825
- " " 12 " 179

BEARINGS FROM PLAT VOL. 10 PAGE 825.

194661

950195  
 APPROVED FOR TRANSFER ONLY  
 NO SUBDIVISION PLAT REQUIRED  
 (O.R.C. 711.001 & 711.191)  
 Lot(s) not for building unless  
 approved by Board of Health.  
 HOLMES CO. PLANNING COMM.

By TRM Date 9-22-95

DANIEL & FERN HOCHSTETLER 233-187

REC'D AT: 4:45 o'clock P.m. RECORDED FEE \$20.00

INDEXED


SEP 25 '95 SEP 26 '95  
 Plat  
 VOL 14 PAGE 927 Sally Miller REC'D BY  
 DV 270 pg 374 Laurel



I CERTIFY THIS SURVEY TO BE CORRECT TO THE BEST OF MY KNOWLEDGE.

Donald C. Baker  
 DONALD C. BAKER P.S. 6938  
 5958 T.R. 322  
 MILLERSBURG, OHIO 44654  
 PH. (216) 674-4788

AUGUST 7, 1995  
 39395-MLS

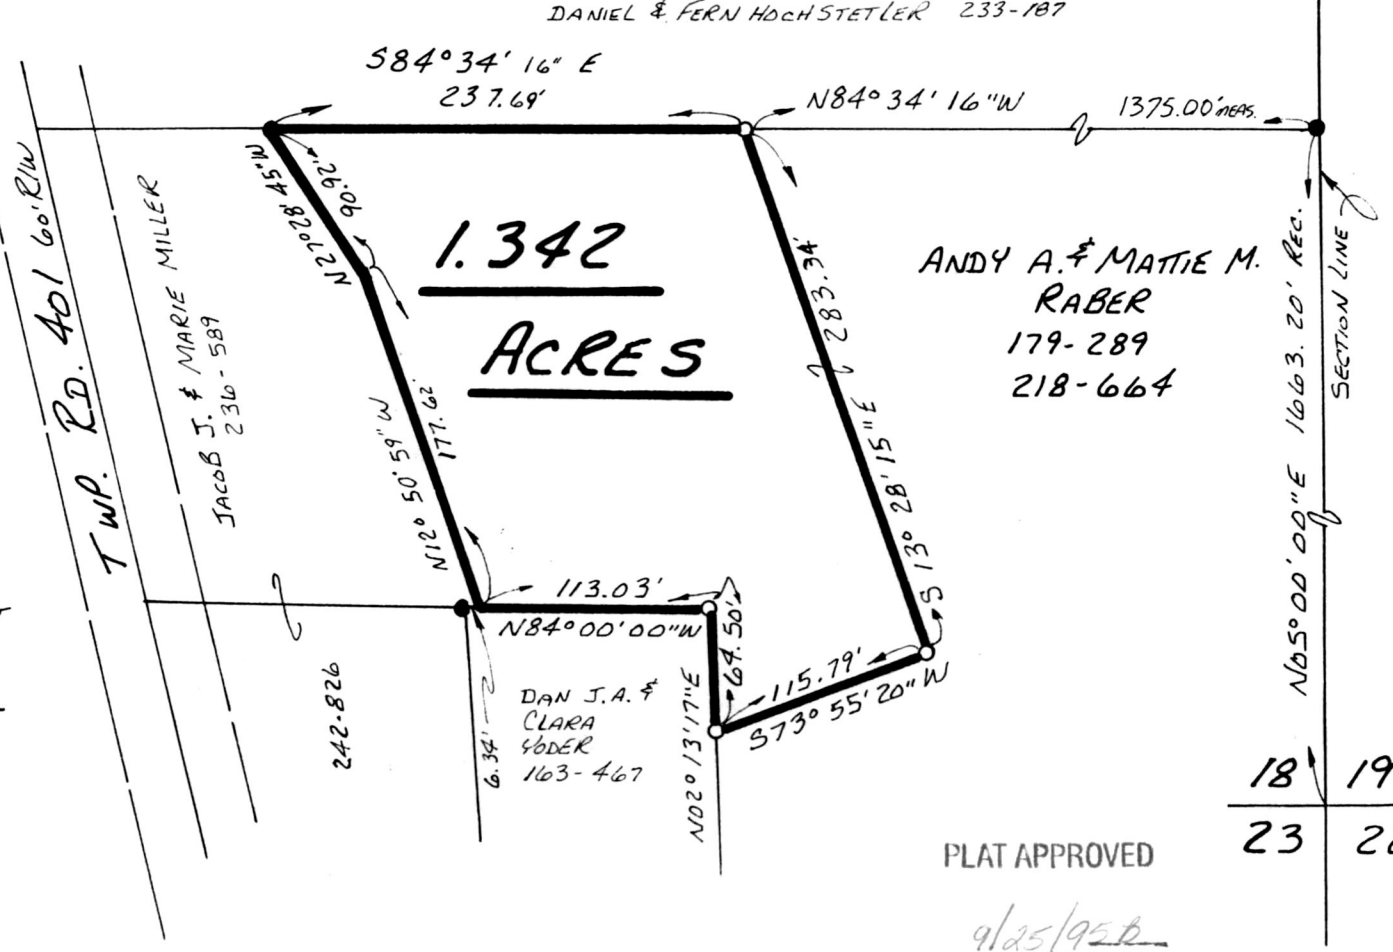

ANDY A. & MATTIE M.  
 RABER  
 179-289  
 218-664

DAN J.A. &  
 CLARA  
 SODER  
 163-467

PLAT APPROVED

9/25/95

18	19
23	22