


195442

#20.00

HARDY TOWNSHIP
3RD. QTR. LOT 7
T- 9N ; R- 7W
HOLMES COUNTY, OHIO

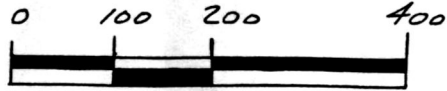

SCALE: 1" = 200'

- STONE FOUND
- IRON PIN FOUND
- △ R.R. SPIKE SET
- 5/8" RE BAR WITH I.D. CAP SET
- I.D. CAP MARKED "BAKER 6938"

REFERENCES:

- DEED Vol. 207 PAGE 637
- " " 207 " 524
- " " 263 " 692
- PLAT Vol. 10 PAGE 866
- " " 5 " 104
- " " 2 " 140

195442

REC'D

AT 2:01 o'clock P.m.

RECORDED

FEE \$20.00

NOV 17 '95

NOV 20 '95

Plat.

VOL 14 PAGE 958

BY 270 pg 982

Sally Miller RECORDER
Mark Baseman

INDEXED

I CERTIFY THIS SURVEY TO BE CORRECT
TO THE BEST OF MY KNOWLEDGE.

Donald C. Baker

DONALD C. BAKER P.S. 6938

5958 T.R. 322


MILLERSBURG, OHIO 44654

PH. (216) 674-4788

OCTOBER 31, 1995



BEARINGS FROM PLAT VOL. 10 PAGE 461

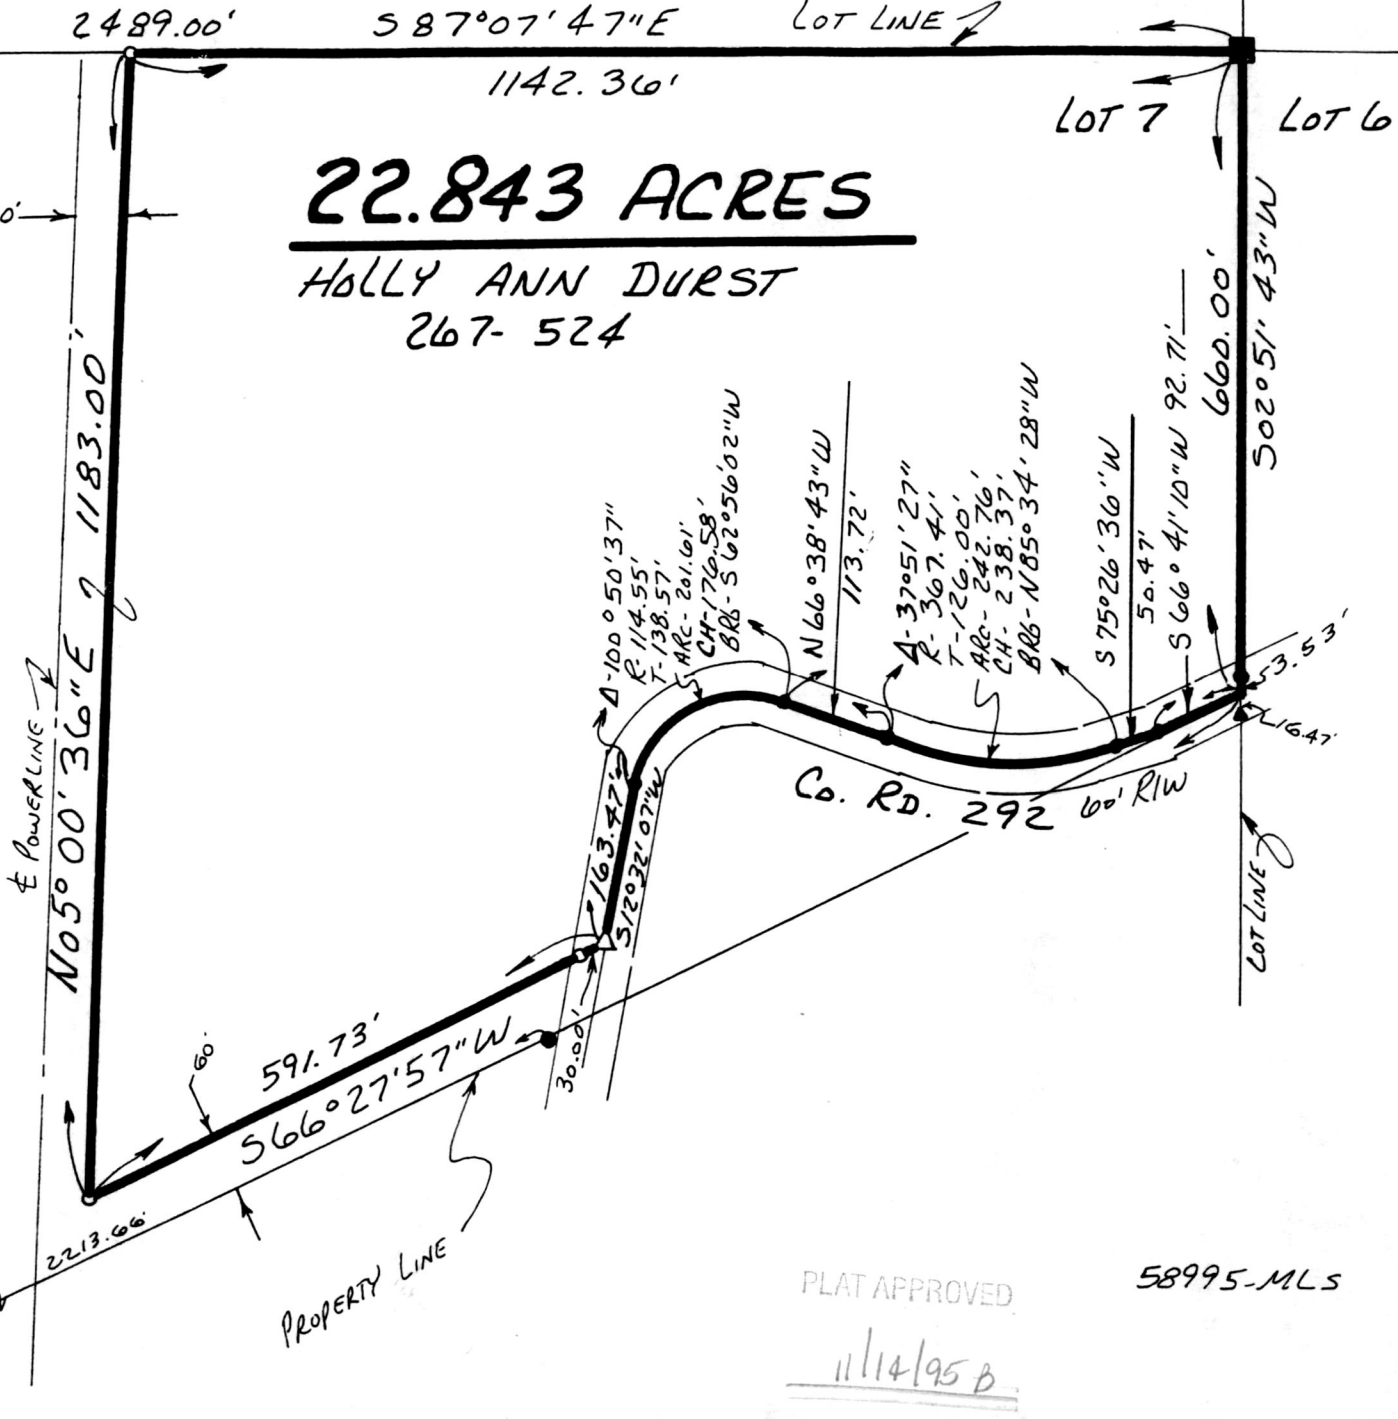

22.843 ACRES

HOLLY ANN DURST
267-524

PLAT APPROVED
11/14/95 B

58995-MLS

VOL 14 PAGE 958