

VOL 14 PAGE 967

WALNUT CREEK TOWNSHIP
NE. QTR. SECTION 19
T-9N; R-5W
HOLMES COUNTY, OHIO



SCALE: 1" = 200'

- STONE FOUND
- IRON PIN FOUND
- 5/8" RE BAR WITH I.D. CAP SET
I.D. CAP MARKED "BAKER 6938"

REFERENCES:

- DEED VOL. 201 PAGE 352
- DEED VOL. 198 PAGE 153
- DEED VOL. 222 PAGE 264
- PLAT VOL. 7 PAGE 815
- SURVEY RECD RD VOL. 1 PAGE 67
- PLAT VOL. 9 PAGE 266
- PLAT VOL. 13 PAGE 52



NOTE:

THE 0.932 AC. PARCEL IS NOT DESCRIBED BY ADEN E. & BETTY TROYER'S DEED, HOWEVER, THEY OCCUPY IT.



REC'D AT 4:15 o'clock PM
DEC 05 '95
Plat.

195668
RECORDED FEE 100.00
DEC 06 '95

VOL 14 PAGE 967
D.V. 271 pg 155-157
RECORDED
REC. & USED

I CERTIFY THIS SURVEY TO BE CORRECT TO THE BEST OF MY KNOWLEDGE.

Donald C. Baker
DONALD C. BAKER P. S. 6938
5958 T.R. 322
MILLERSBURG, OHIO 44654
PH. (216) 674-4788
DECEMBER 28, 1994

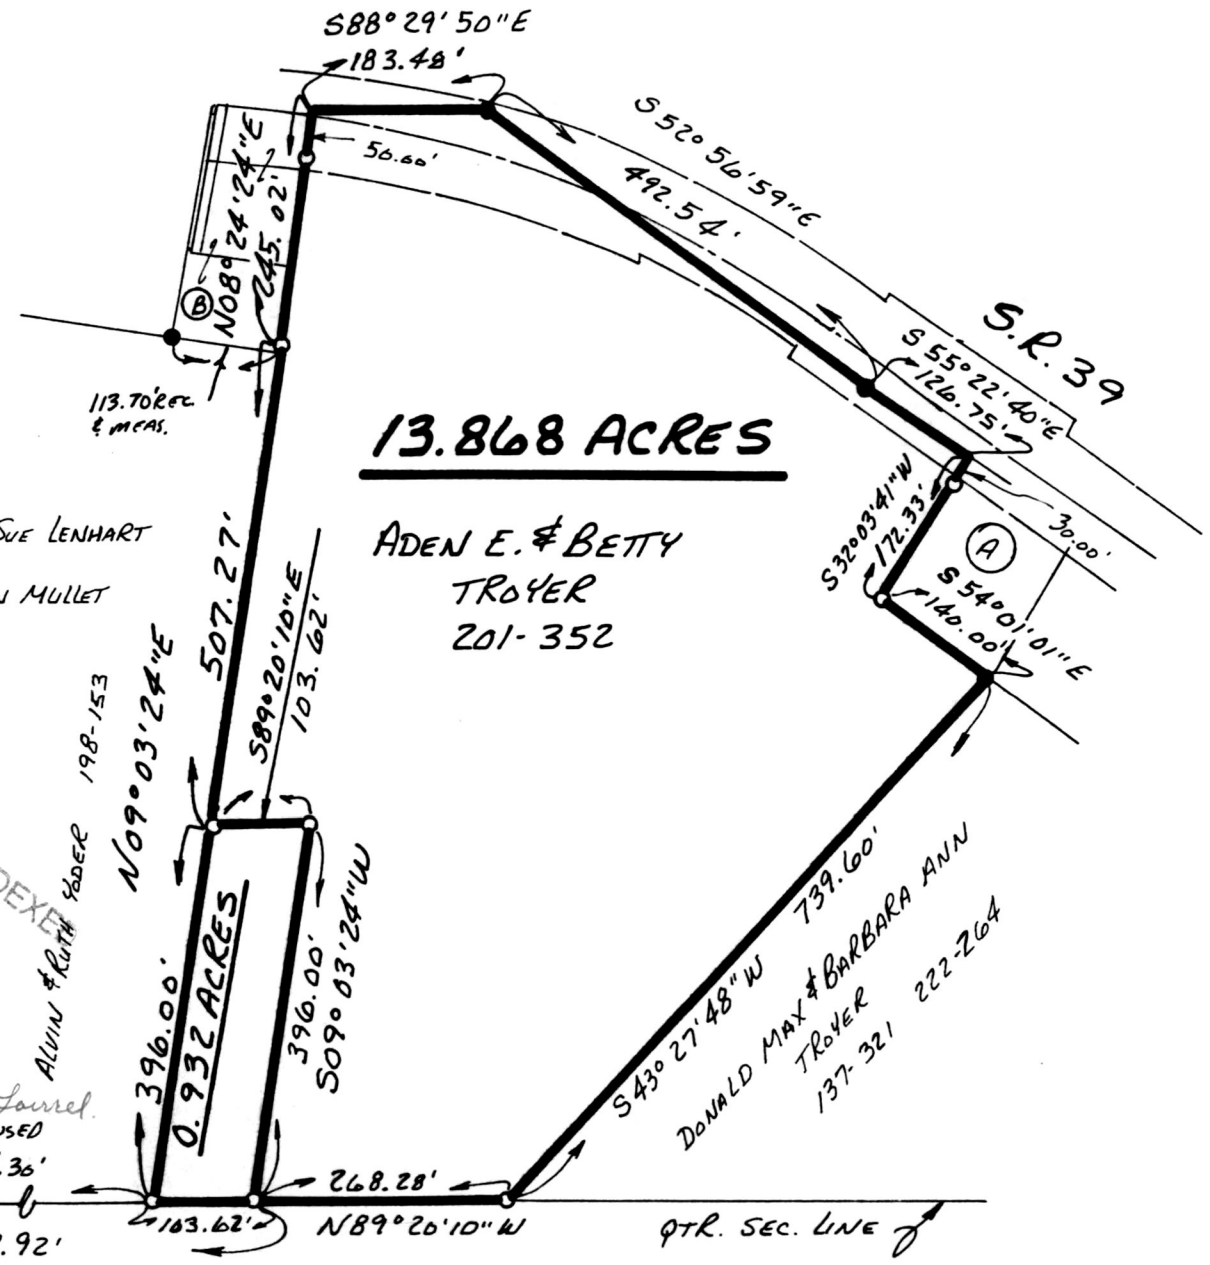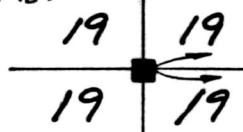

PLAT APPROVED

12/15/95