


PAINT TOWNSHIP
S.E. & S.W. QTR. SECTION 27
T-15N; R-11W
HOLMES COUNTY, OHIO

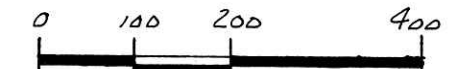

SCALE: 1" = 200'

- ▲ R.R. SPIKE FOUND
- IRON PIN FOUND
- △ R.R. SPIKE SET
- 5/8" RE BAR WITH I.D. CAP SET
- I.D. CAP MARKED "BAKER 6938"

REFERENCES:

- DEED VOL. 240 PAGE 209
- DEED VOL. 240 PAGE 727
- DEED VOL. 241 PAGE 287
- DEED VOL. 250 PAGE 724
- DEED VOL. 255 PAGE 951
- DEED VOL. 258 PAGE 604
- DEED VOL. 258 PAGE 546
- DEED VOL. 258 PAGE 1015
- PLAT VOL. 9 PAGE 216
- PLAT VOL. 12 PAGE 82
- PLAT VOL. 13 PAGE 22
- PLAT VOL. 13 PAGE 73
- PLAT VOL. 10 PAGE 458
- PLAT VOL. 14 PAGE 128
- PLAT VOL. 14 PAGE 16

BEARINGS FROM DEED VOL. 255 PAGE 951

SPLIT APPROVED # 930138

This 2.993 (Tract I) acre parcel is approved for residential wastewater treatment.


John D. ... 7/13/93
Sanitarian Date

These 2.993 & 3.069 acre parcels are not approved for any use that generates wastewater.

John D. ... 7/13/93
Sanitarian Date

SPLIT APPROVED # 930127

SPLIT APPROVED # 930135

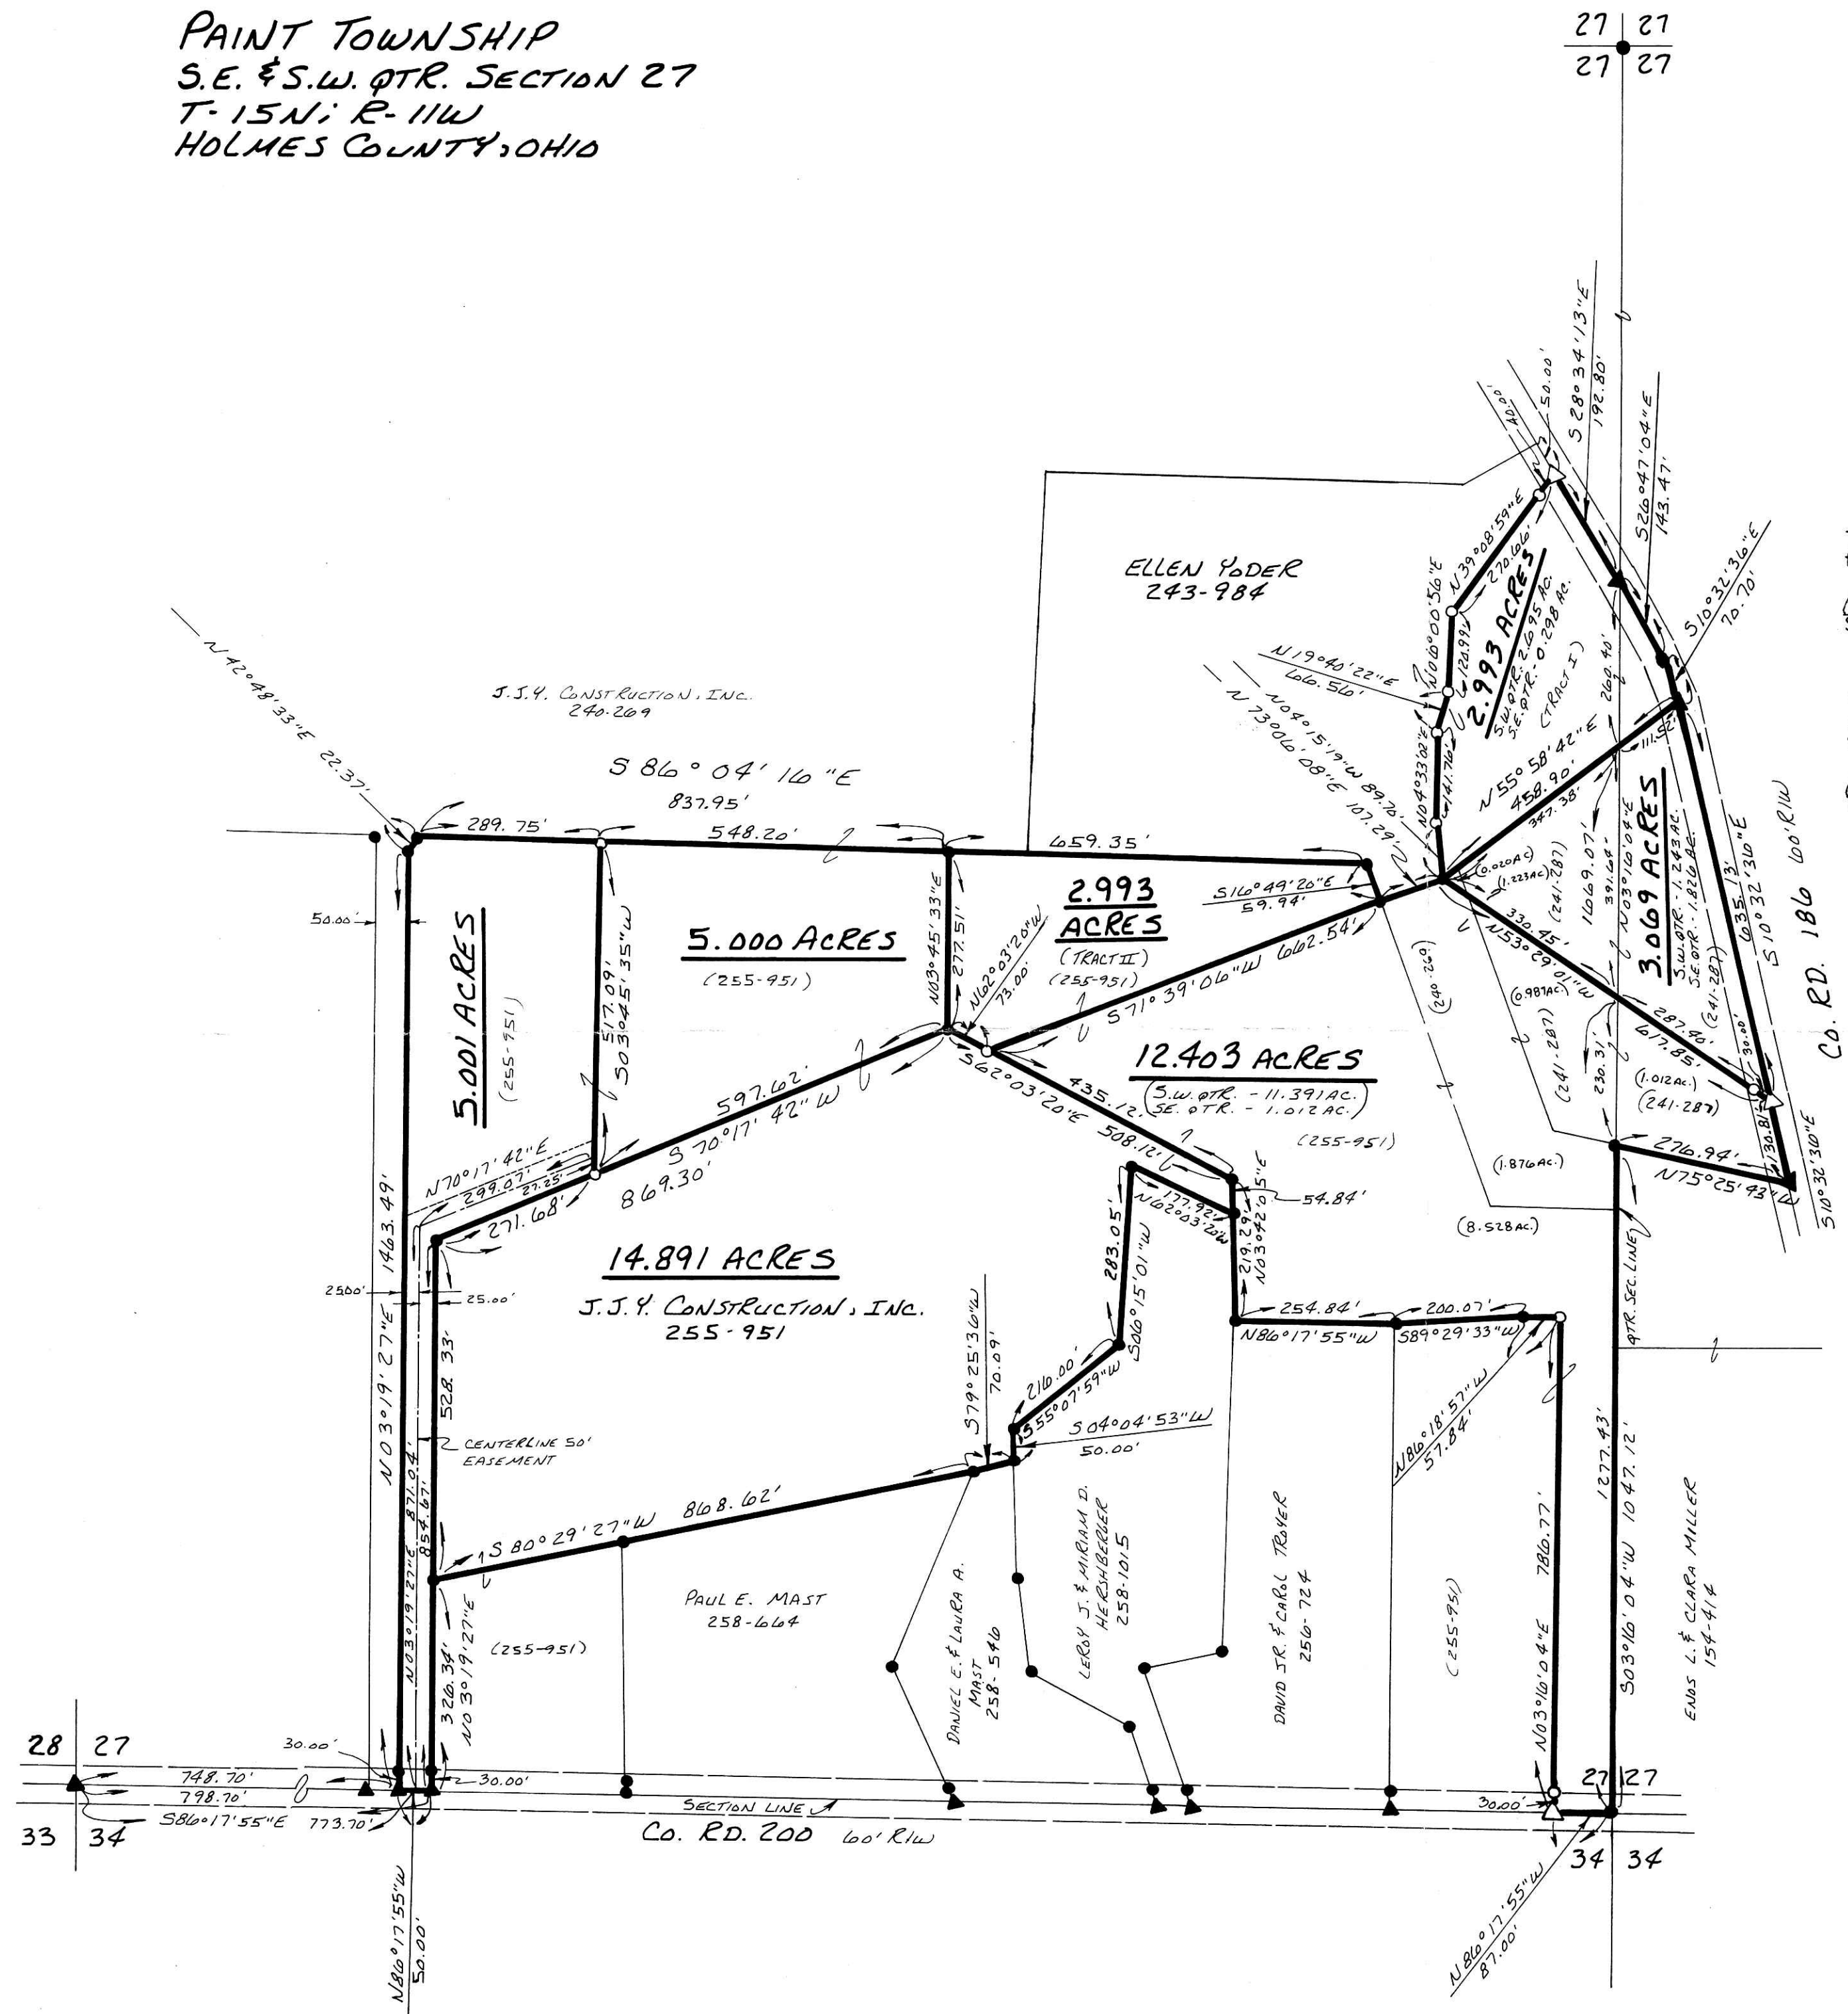

I CERTIFY THIS SURVEY TO BE CORRECT TO THE BEST OF MY KNOWLEDGE.

Donald C. Baker
DONALD C. BAKER P.S. 6938
5958 T.R. 322
MILLERSBURG, OHIO 44654
PH. (216) 674-4788

JUNE 15, 1993

28893-MLS

Rec'd. JUL 21 1993 AT 4:15 O'CLOCK P.M.
Recorded JUL 22 1993 Holmes Co. Ohio Fee \$21.60
Plat Vol. 15 Pg. 2
Deed vol. 260 Pgs. 809-812-814-817-820

PLAT APPROVED 7/20/93 B