


RIPLEY TOWNSHIP
S. W. QTR. SECTION 28
S. E. QTR. SECTION 29
T-18N; R-14W
HOLMES COUNTY, OHIO

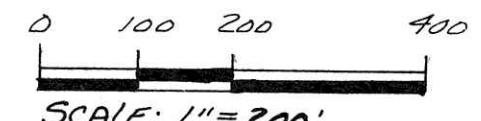

SCALE: 1" = 200'

- STONE FOUND
- ▲ R.R. SPIKE FOUND
- IRON PIN FOUND
- △ R.R. SPIKE SET
- 5/8" RE BAR WITH I.D. CAP SET
- ⊙ PK. NAIL SET

REFERENCES:

- DEED VOL. 251 PAGE 112
- DEED Vol. 242 PAGE 829
- DEED Vol. 257 PAGE 974
- DEED Vol. 167 PAGE 55
- DEED Vol. 257 PAGE 1009
- DEED Vol. 231 PAGE 199
- DEED Vol. 240 PAGE 757
- PLAT Vol. 12 PAGE 180
- PLAT Vol. 4 PAGE 85
- PLAT Vol. 7 PAGE 146
- PLAT Vol. 6 PAGE 7
- PLAT Vol. 8 PAGE 581
- SURVEY RECORD 4 PAGE 313
- PLAT Vol. 12 PAGE 625
- PLAT Vol. 12 PAGE 627

- (A) RICHARD H. & JANE LUCILLE REYNOLDS TRUSTEES 262-910
- (B) HARRY E. & MARJEAN M. McDANIEL 250-720


I CERTIFY THIS SURVEY TO BE CORRECT TO THE BEST OF MY KNOWLEDGE.

Donald C. Baker
 DONALD C. BAKER P.S. 6938
 5958 T.R. 322
 MILLERSBURG, OHIO 44654
 PH. (216) 674-4788

MAY 20, 1994



27094-MLS

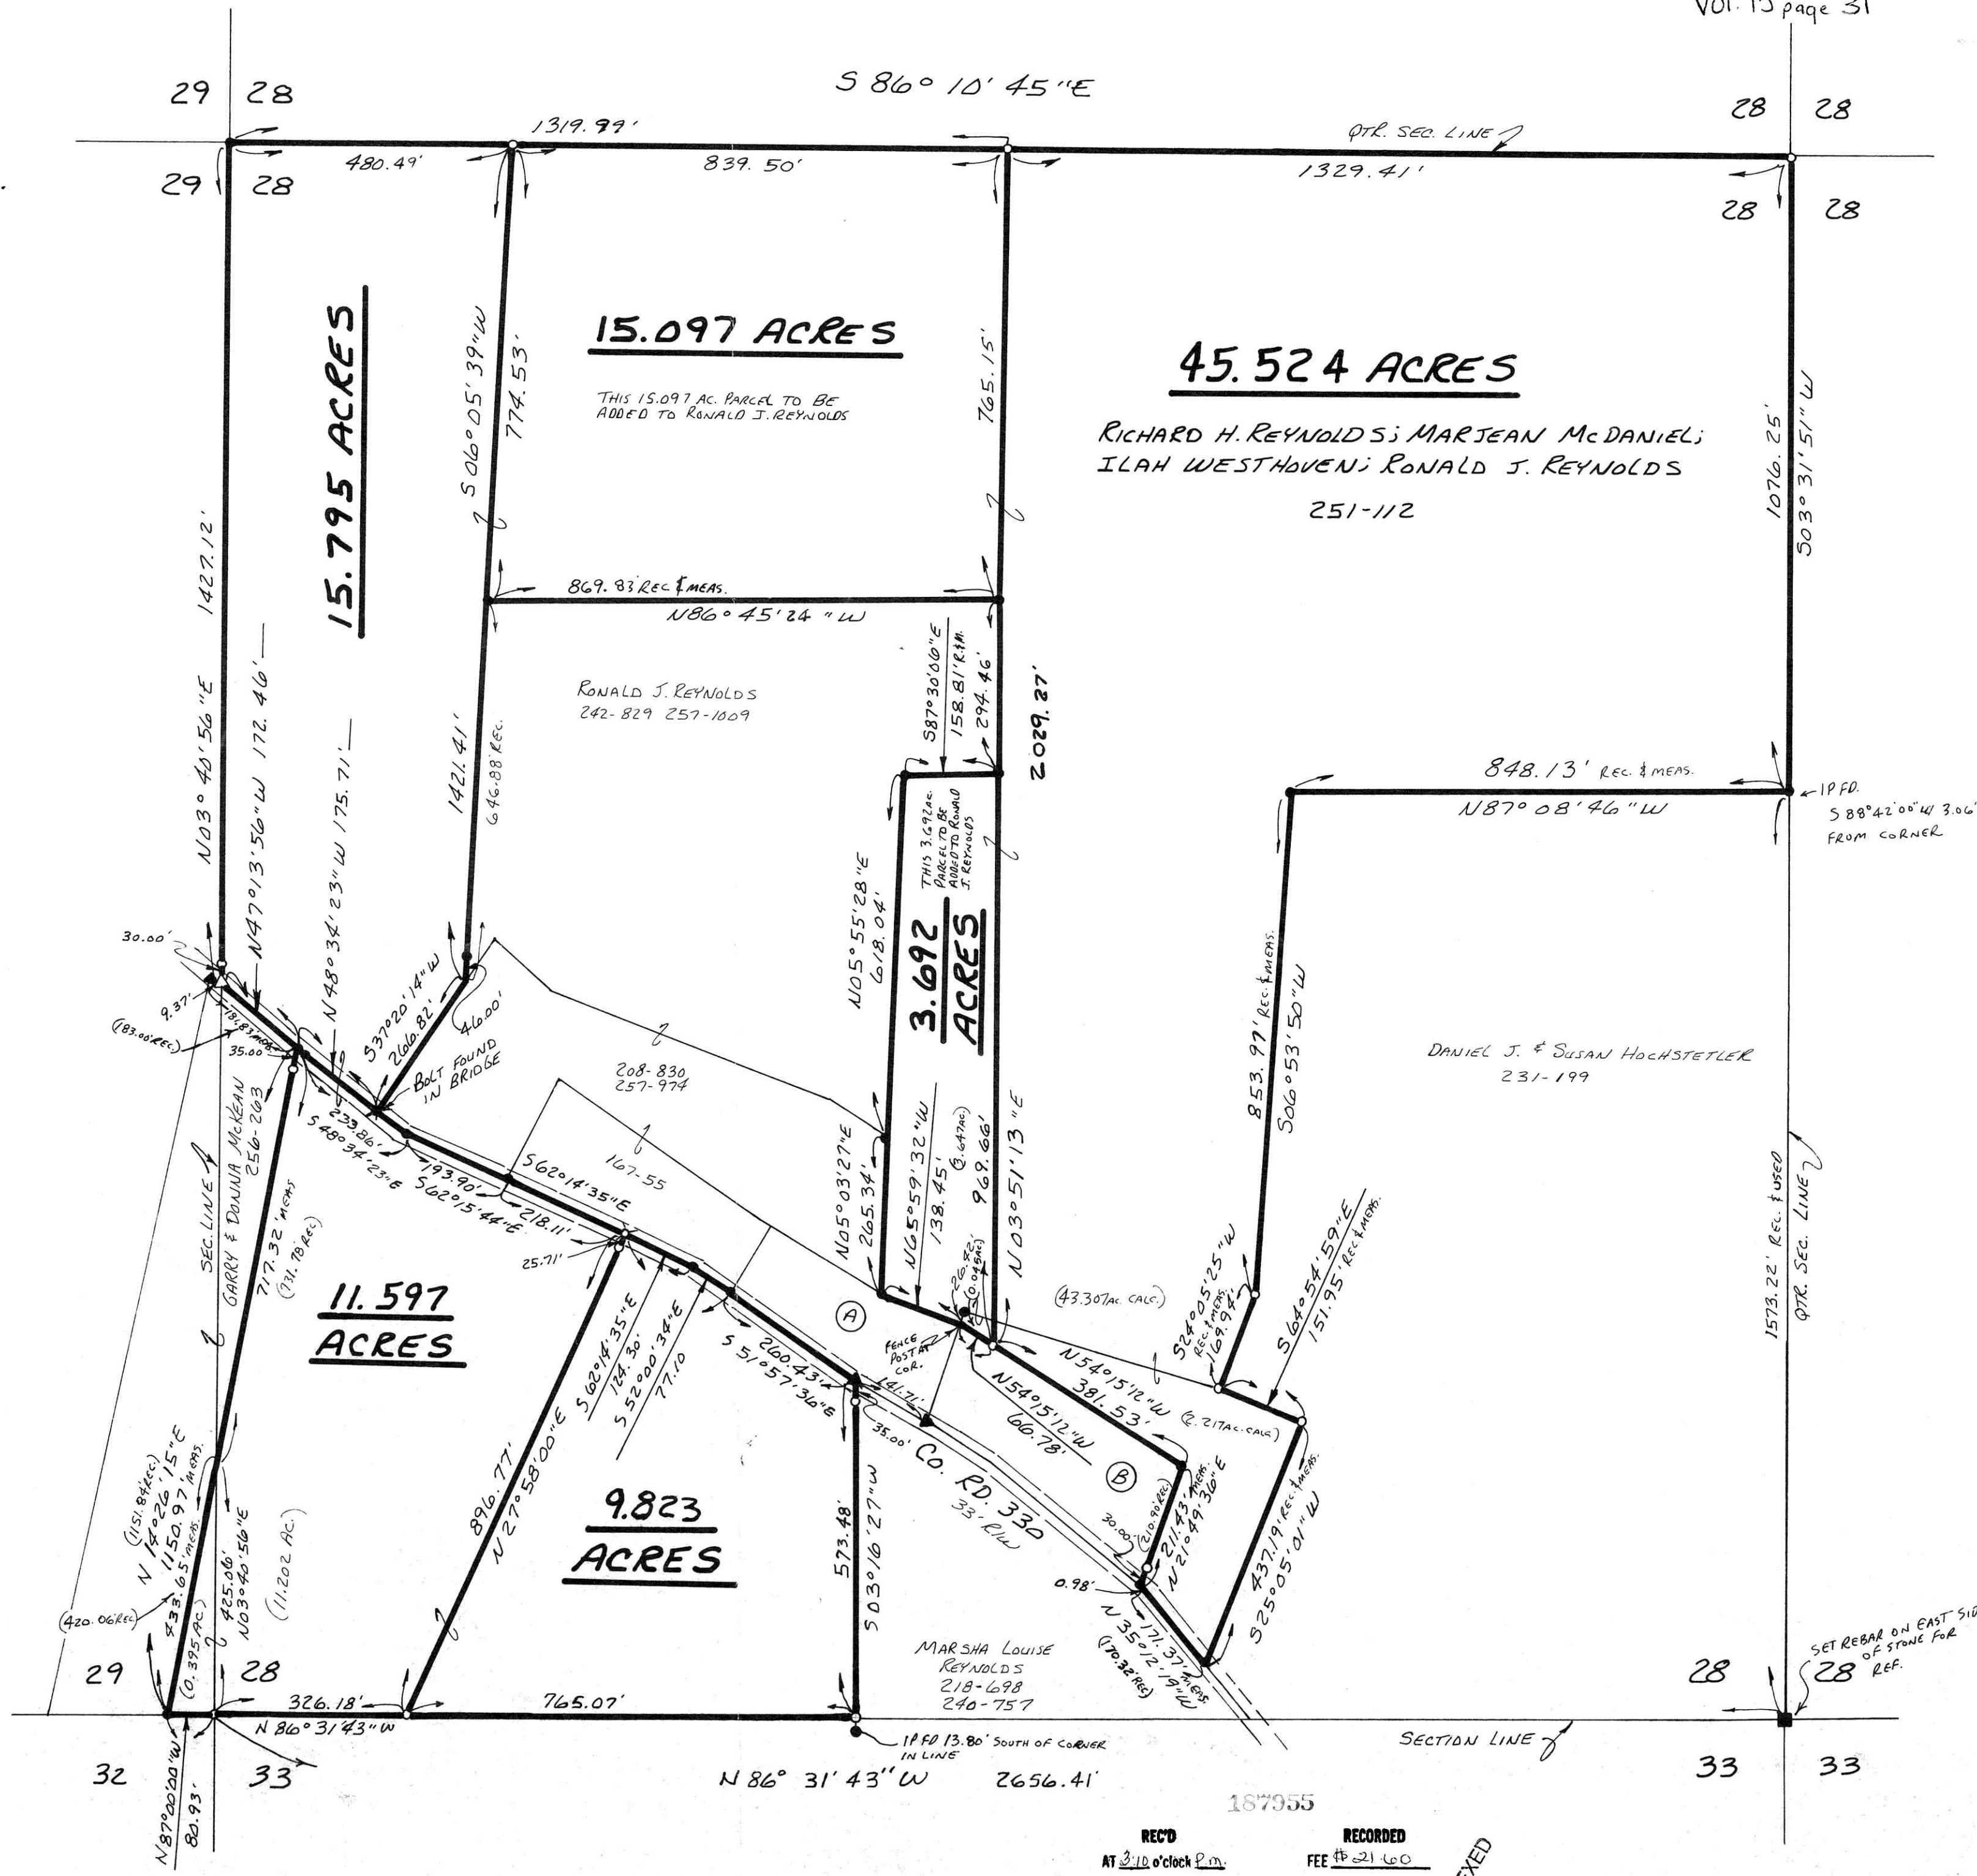

REC'D AT 3:10 o'clock P.M. JUN 06 '94
 RECORDED FEE \$21.60 JUN 07 '94
 Plat Vol. 15 PAGE 31 Deed vol. 264 pg 709
 Recorder: *Sally Miller*
 Recorder: Wayne Co. Title

PLAT APPROVED 6/6/94