

MONROE TOWNSHIP
2ND. QTR. LOTS 11 & 12
T-9N; R-8W
HOLMES COUNTY, OHIO

INDEXED
960000584
Filed for Record in
HOLMES COUNTY, OH
SALLY MILLER
On 04-11-1996 At 03:57 pm.
PLMD 21.60
Vol. 15 Page 82
ov 272 pgs 978-980-982



SCALE: 1" = 200'

- IRON PIN FOUND
- 5/8" RE BAR WITH I.D. CAP SET
- I.D. CAP MARKED "BAKER 6938"


REFERENCES:

DEED Vol. 260 PAGE 128
" " 220 " 327
" " 248 " 46
" " 207 " 81

PLAT Vol. 8 PAGE 473
" " 10 " 497

BEARINGS FROM PLAT Vol. 13 PAGE 191


NOTE: ALL OFFSET PINS ARE SET
AT 30.00' UNLESS MARKED
OTHERWISE.

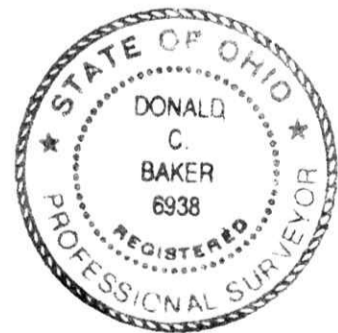

I CERTIFY THIS SURVEY TO BE CORRECT
TO THE BEST OF MY KNOWLEDGE.

Donald C. Baker
DONALD C. BAKER P.S. 6938
5958 T.R. 322
MILLERSBURG, OHIO 44654
PH. (330) 674-4788
MARCH 20, 1996

12996-MLS

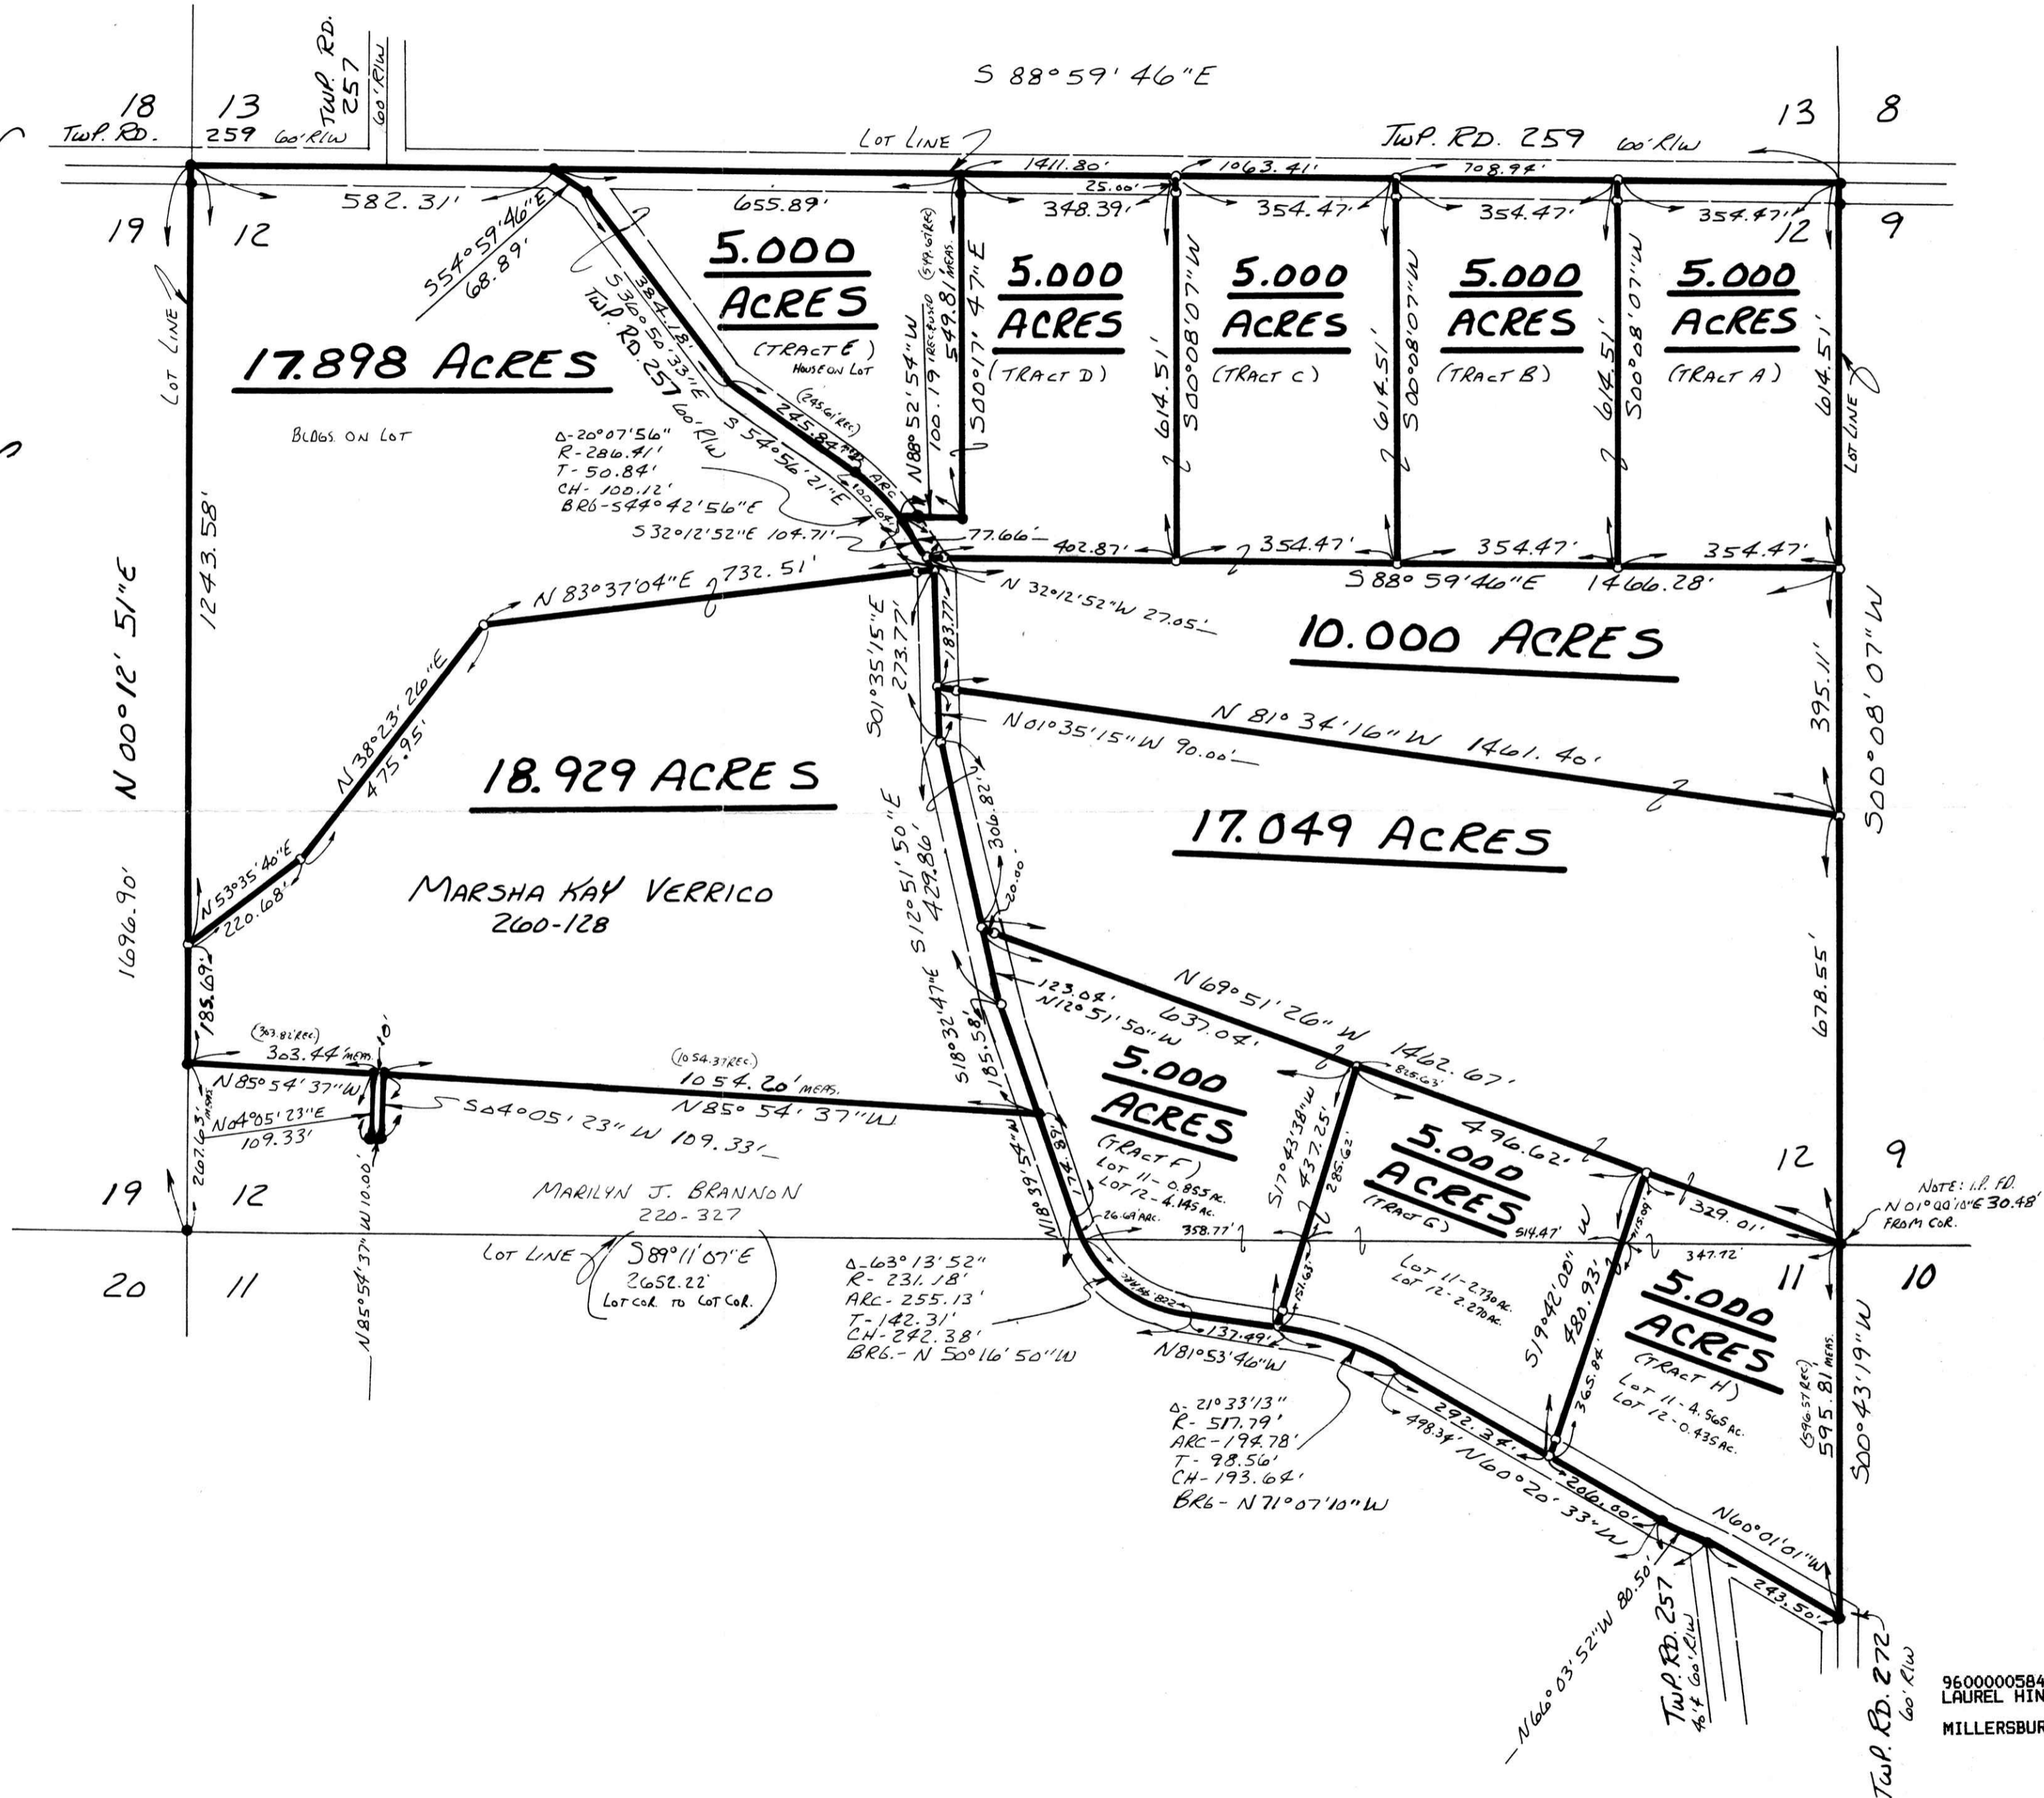

960000584
LAUREL HINES ATTY
MILLERSBURG,

PLAT APPROVED

4/11/96