


REFERENCES:

- DEED VOL. 193 PAGE 31
- DEED VOL. 241 PAGE 457
- DEED VOL. 184 PAGE 113
- DEED VOL. 243 PAGE 503
- DEED VOL. 182 PAGE 540

RIPLEY TOWNSHIP  
 N.E. QTR. SECTION 7  
 T-17N; R-14 W  
 HOLMES COUNTY, OHIO

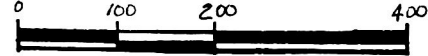

SCALE: 1" = 200'

- IRON PIN FOUND
- △ R.R. SPIKE SET
- 5/8" REBAR WITH I.D. CAP SET
- I.D. CAP MARKED "BAKER 6938"

196836

REC'D

RECORDED

AT 2:41 o'clock PM

FEE \$20.00

FEB 22 '96

FEB 23 '96

Plat

VOL 16 PAGE 27  
DV 272 pg 108

Sally Miller RECORDER

I CERTIFY THIS SURVEY TO BE CORRECT TO THE BEST OF MY KNOWLEDGE.

Donald C. Baker

DONALD C. BAKER P.S. 6938  
5958 T.R. 322  
MILLERSBURG, OHIO 44654

PH: (216) 674-4788


NOVEMBER 30, 1995

34795 FJM

PLAT APPROVED

2/21/96

BEARINGS FROM PLAT 16, 119, 133

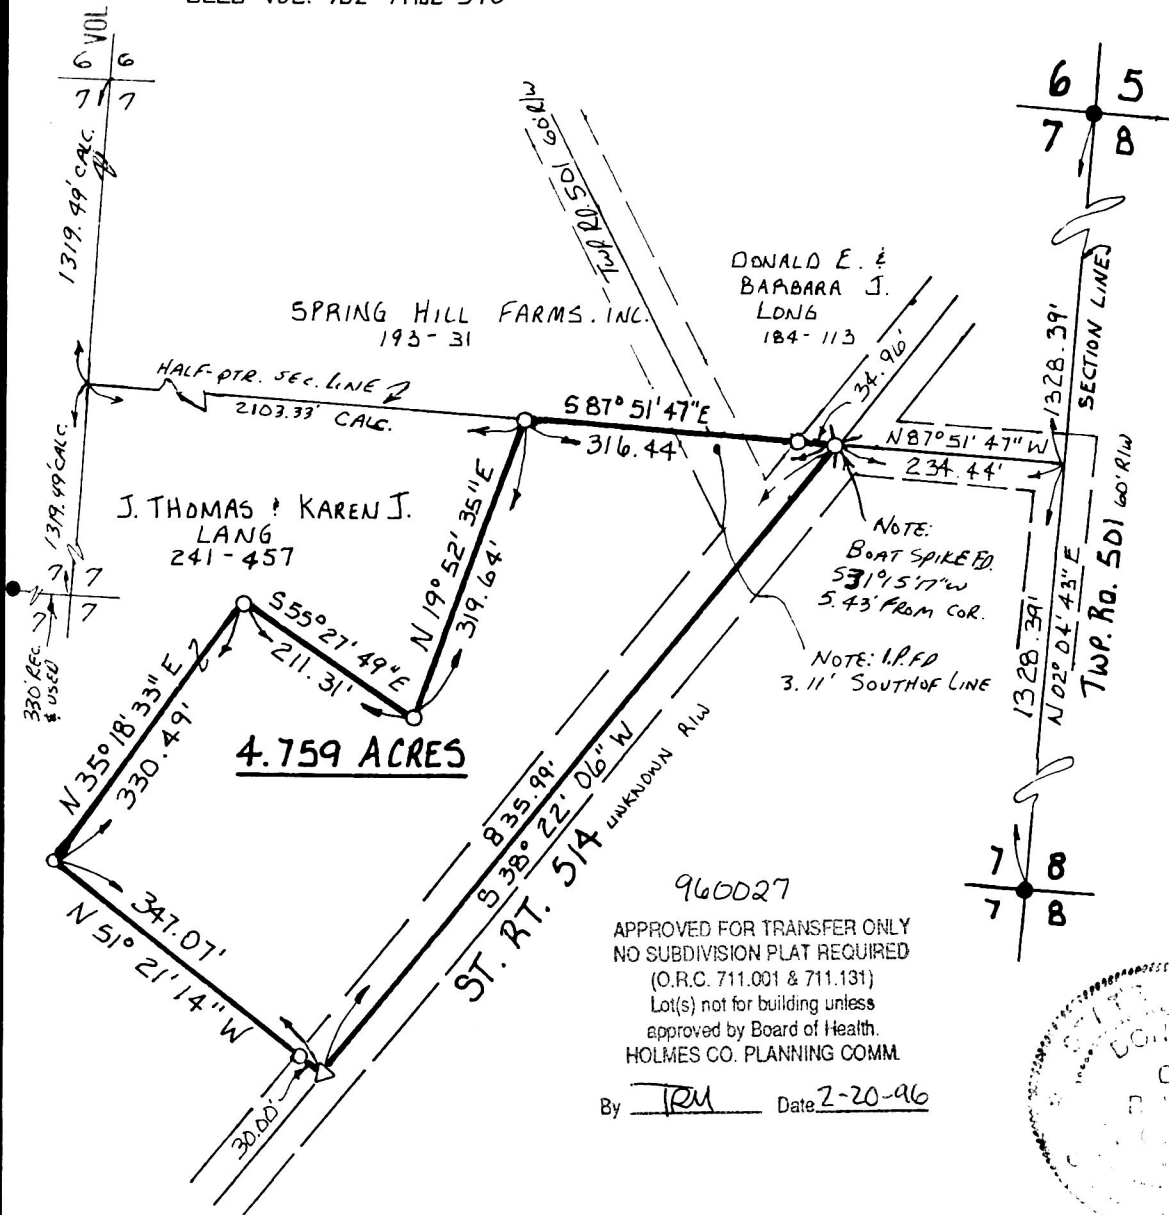

960027

APPROVED FOR TRANSFER ONLY  
 NO SUBDIVISION PLAT REQUIRED  
 (O.R.C. 711.001 & 711.131)  
 Lot(s) not for building unless  
 approved by Board of Health,  
 HOLMES CO. PLANNING COMM.

By TRM Date 2-20-96

