


MECHANIC TOWNSHIP
S.E. PTR. SECTION 1
T-8N; R-7W
HOLMES COUNTY, OHIO


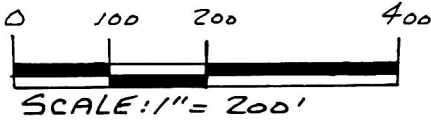


- IRON PIN FOUND
- △ R.R. SPIKE SET
- 5/8" RE BAR WITH I.D. CAP SET
- I.D. CAP MARKED "BAKER 6938"

REFERENCES:

- DEED Vol. 210 PAGE 441
- " " 138 " 202
- " " 266 " 639
- PLAT Vol. 14 PAGE 643
- " " 10 " 835

BEARINGS from PLAT Vol. 10 PAGE 835

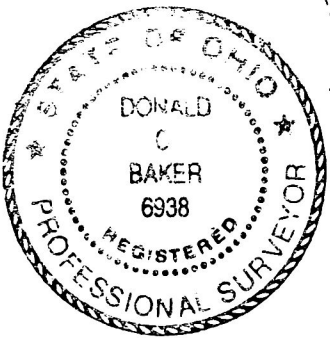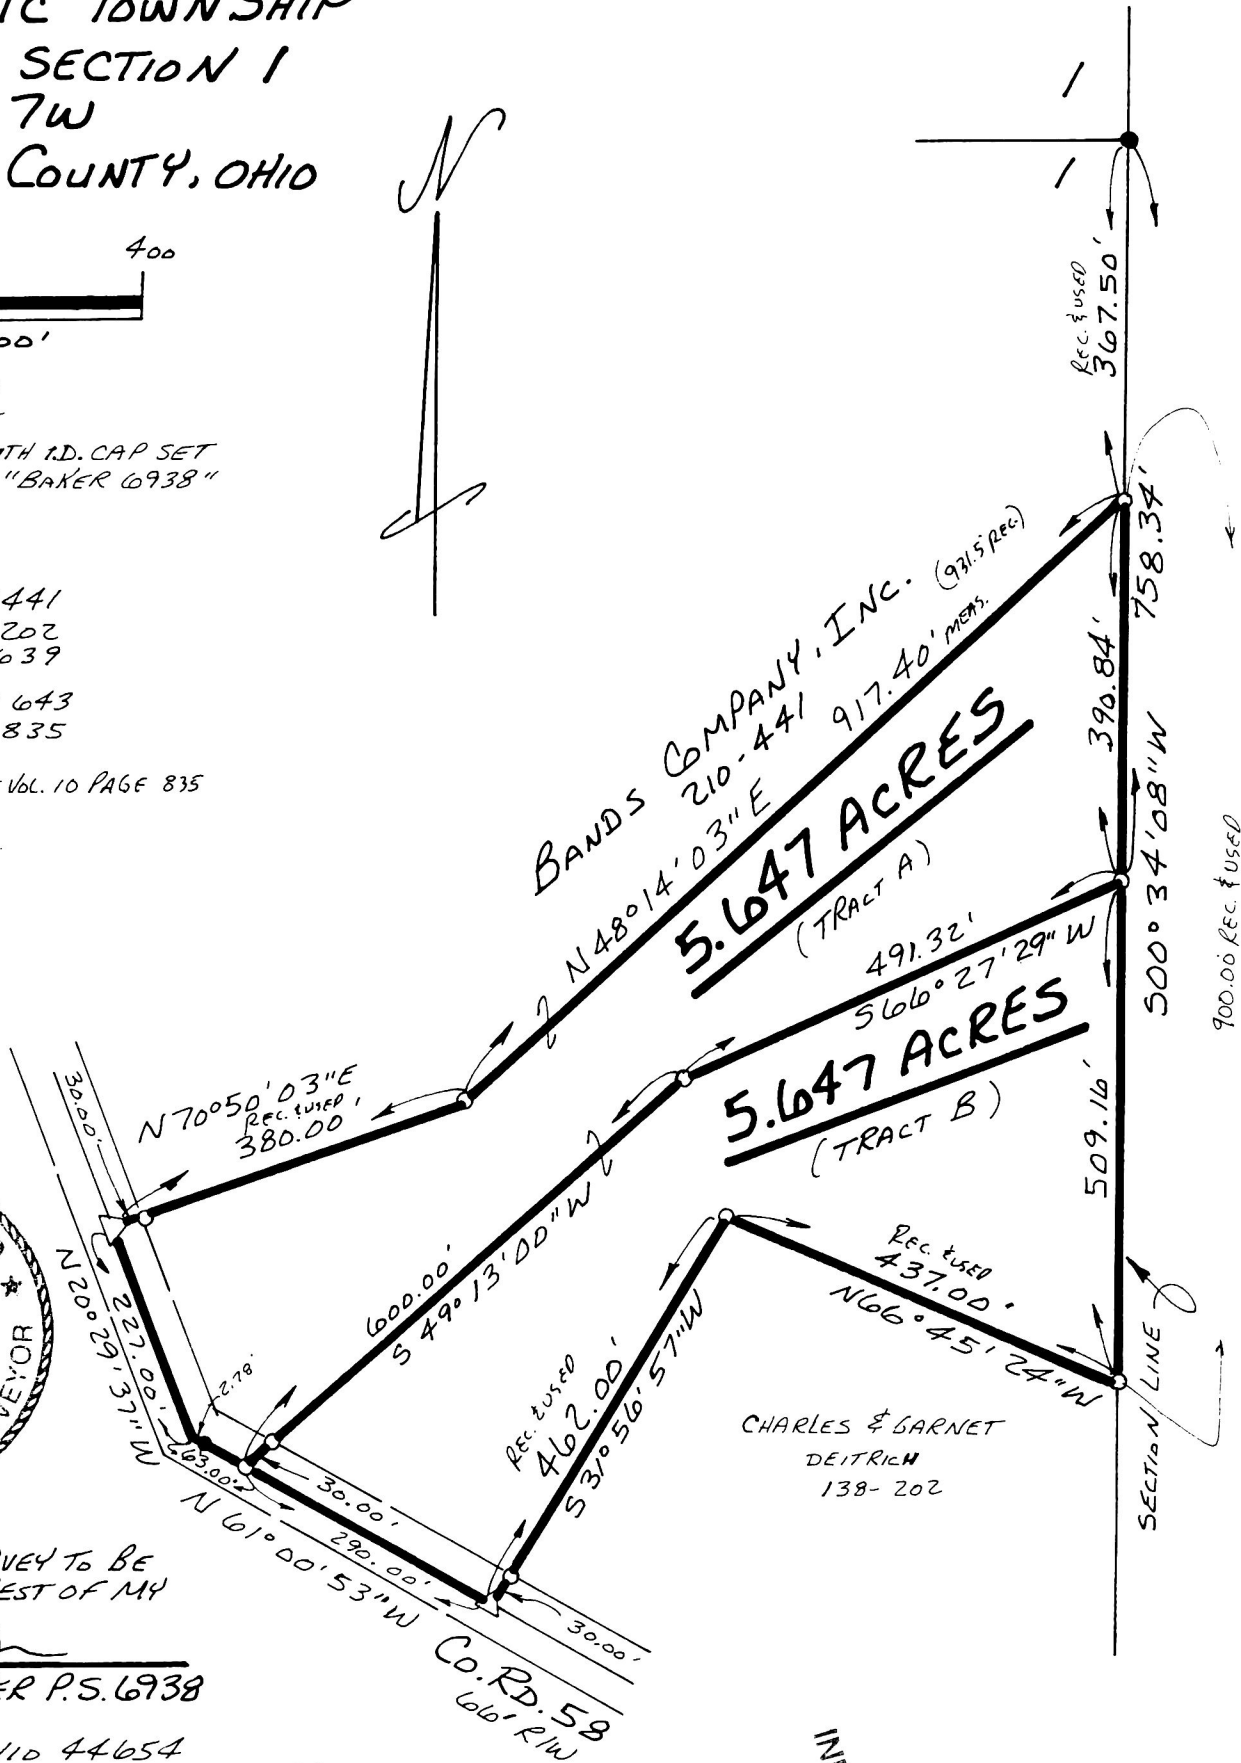

I CERTIFY THIS SURVEY TO BE CORRECT TO THE BEST OF MY KNOWLEDGE.
 Donald C. Baker
 DONALD C. BAKER P.S. 6938
 5958 T.R. 322
 MILLERSBURG, OHIO 44654
 PH. (216) 674-4788
 FEBRUARY 8, 1995

197176

INDEXED PLAT APPROVED

Recorded MAR 11 1996 AT 11:27 O'CLOCK AM
 HOLMES CO. OHIO FEE: 20.00
 PLAT Vol. 16 Pg. 40 Recorder Sally Miller
 3/8/96

4096-MLS